


GRUNNMYND 1:50

Beip. w. L. 5. 53444

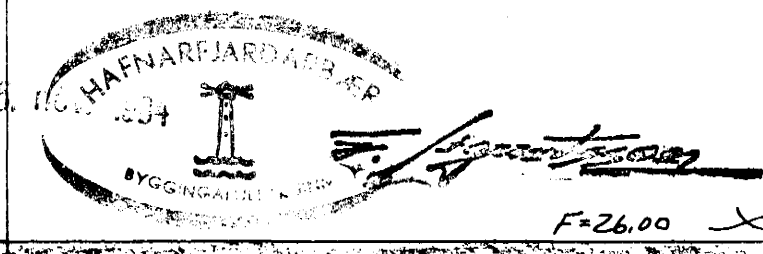

REIKN TEIKN RVIK I	SVEINN G. SVEINSSON BYGGINGARVERKFR. FVF	BR VERK NR.
<i>S. Sveinsson</i>	Dalshraun / <i>Gurmar</i>	MÆLIKV 1:50 1:50
	Jur. Slagnir	TEIKN. NR. 21