


28/11 '11  
*[Handwritten signature]*

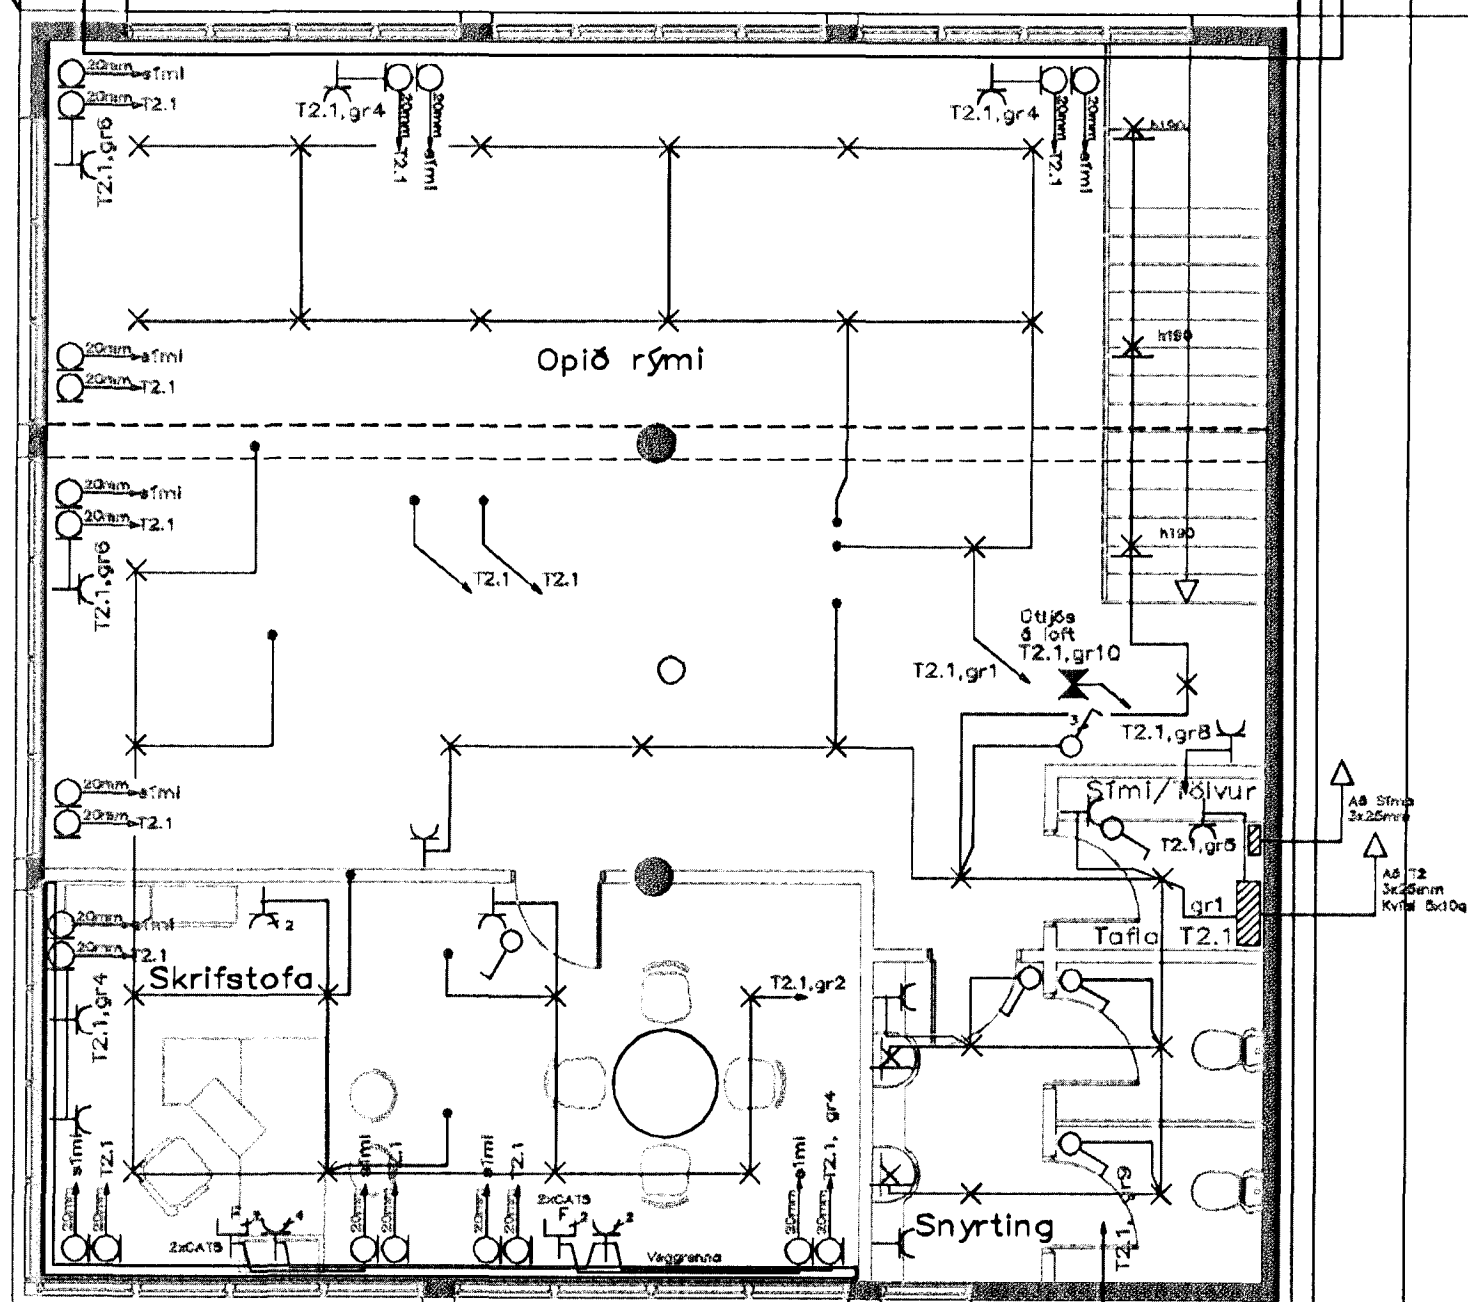

*Pólfur Kristjánsson*  
 KT 040851-4469 *[Handwritten signature]*

Stofa & Ragnarsson Ráðgjafar- og Eignar R. 22222-4128 Sími 454-7187		DALSHRAUN 8	
A Reyndartekning Dagur		21.09.11	STR
B Sambýkt		Dagur	Samb.
Dagsetning		Verk nr.	Málsvæði
21.08.03	03-100	1:50	03-103