



SKURÐUR A - A

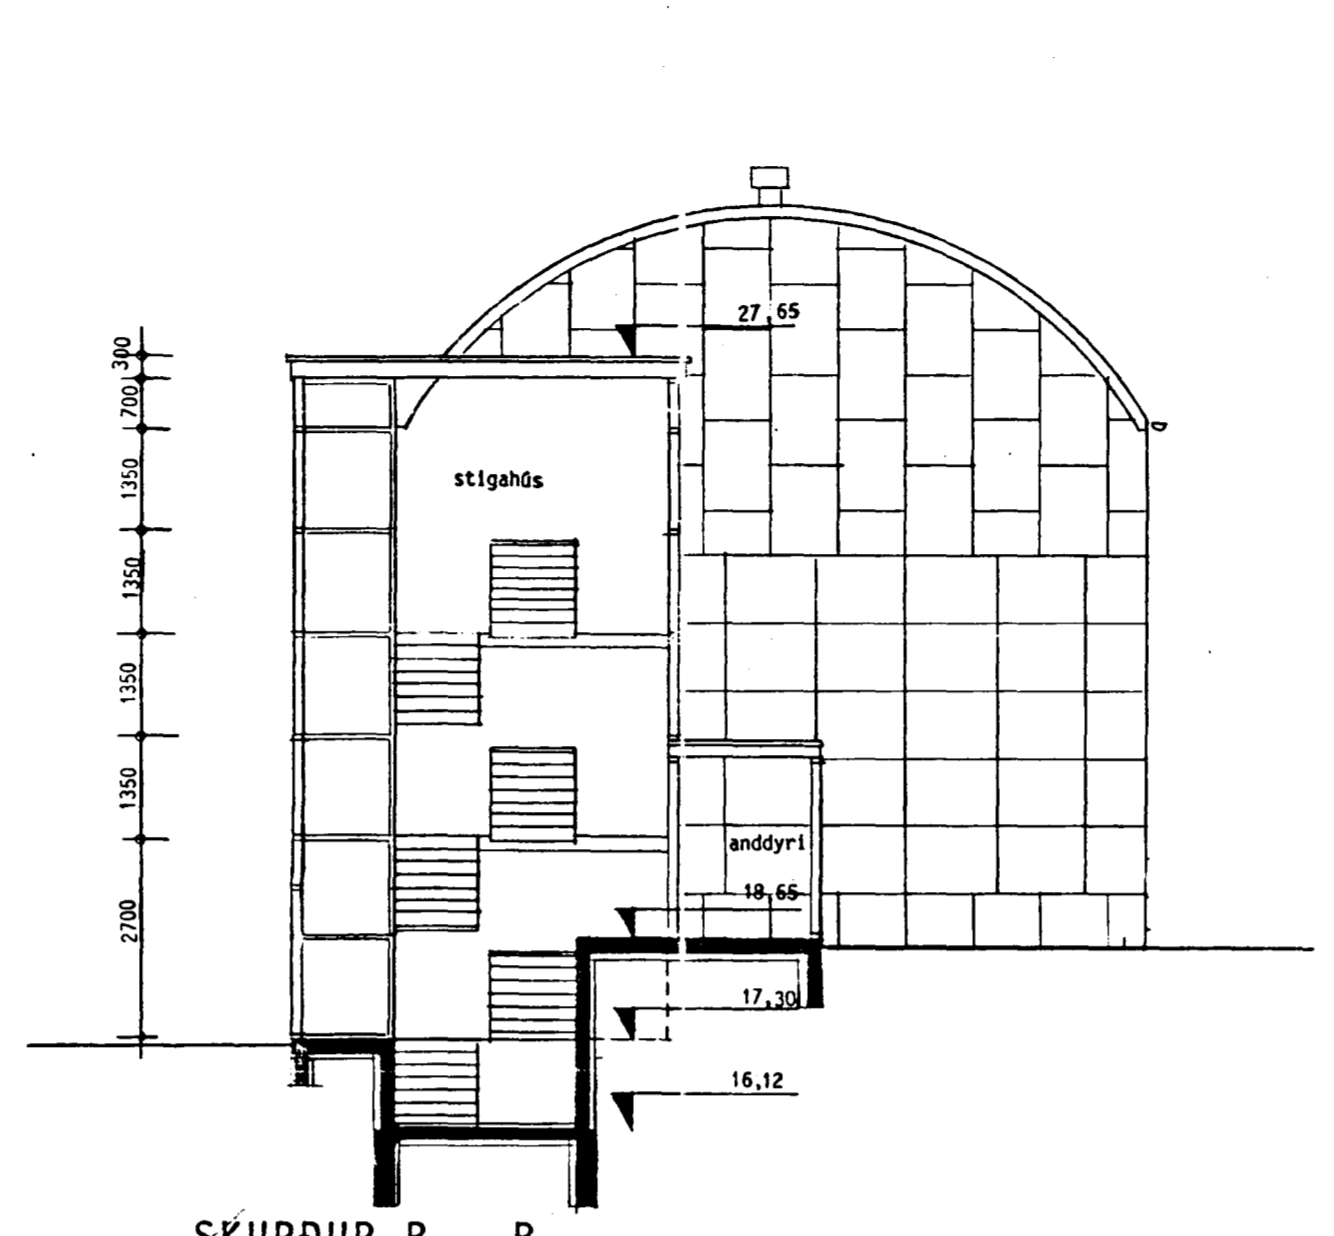

SKURÐUR B - B

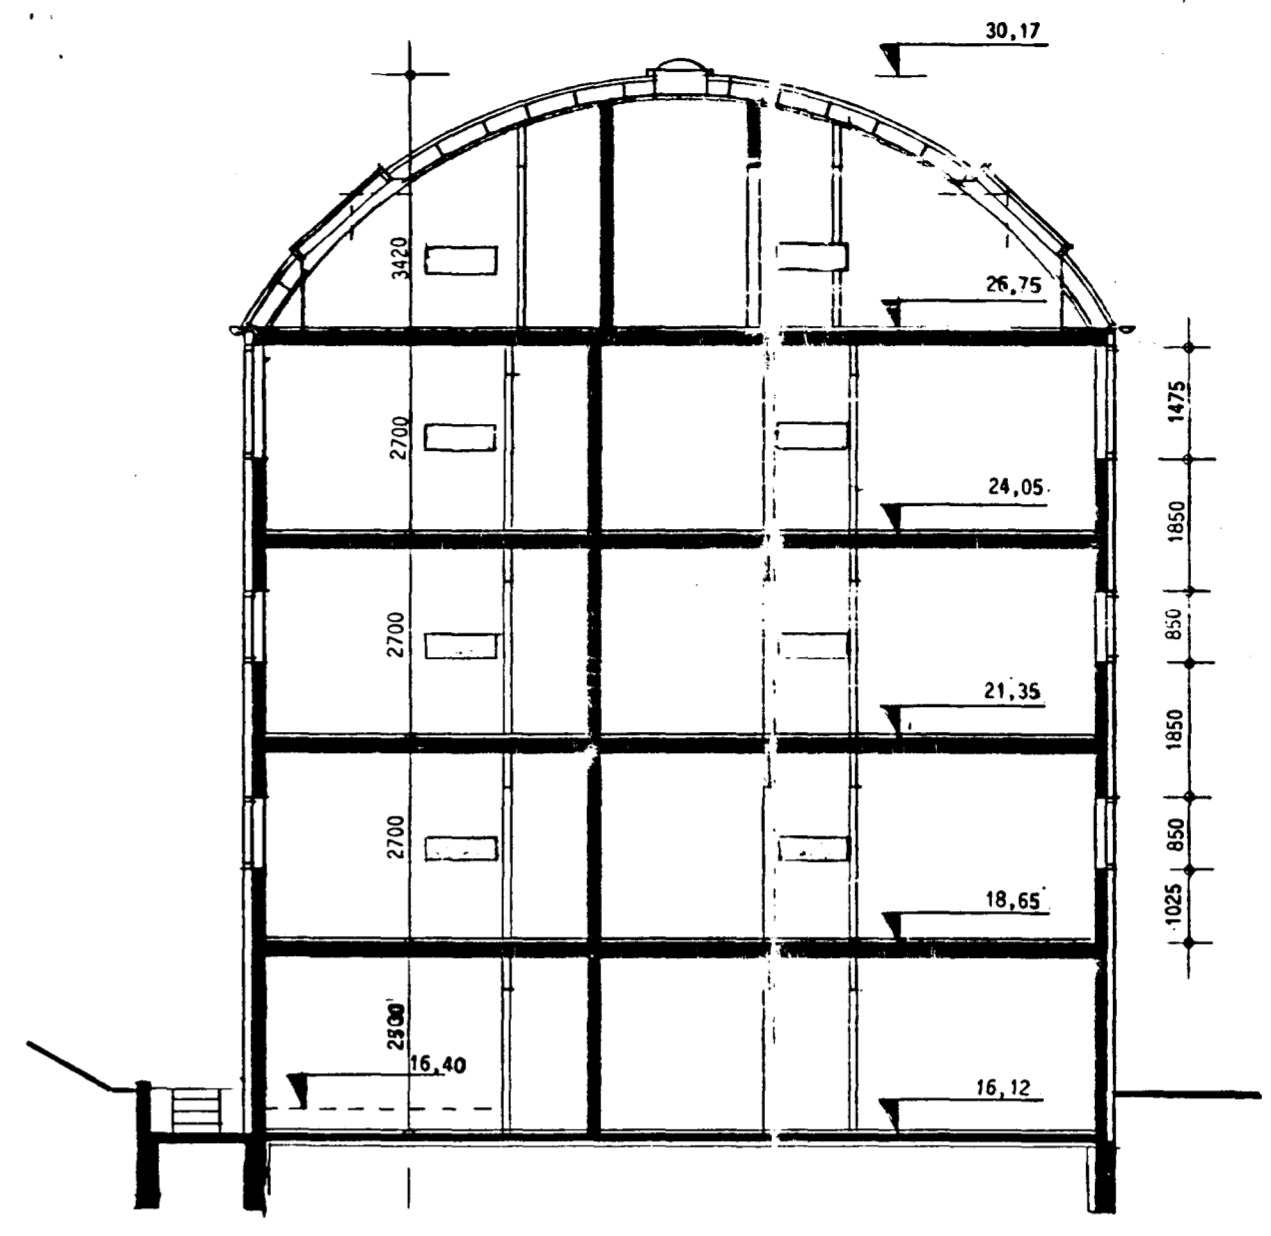

SKURÐUR C - C

br. 11.04.89
br. 23.08.89
br. 11.11.89
br. 27.09.90
br. 11.10.90 ís. n.a.
br. 01.11.90 FLUTA A ísúe
br. 09.11.90 stigahús

Flatarmál:

Minna hús:	26,7 m ²
1. hæð	95,7 m ²
2. hæð	95,7 m ²
3. hæð	60,3 m ²
Samtals	347,4 m ²

Stærri hús:

kjallari	126,5 m ²
1. hæð	126,5 m ²
2. hæð	126,5 m ²
3. hæð	126,5 m ²
4. hæð	89,5 m ²
Samtals	595,5 m ²


Stigahús:

kjallari	13,2 m ²
1. hæð	28,5 m ²
2. hæð	15,4 m ²
3. hæð	12,7 m ²
Samtals	69,8 m ²
Heildarflatarmál	1012,7 m ²

Römmál:

Minna hús	993,8 m ³
Stærri hús	1392,5 m ³
Stigahús	259,7 m ³
Heildarrömmál	2646 m ³

DOFRABERG 9
 HAFNARFIRÐI
 Grunnmynd og
 skurðmyndir,
 mkv. 1:100 10.01.89.
 O2 G

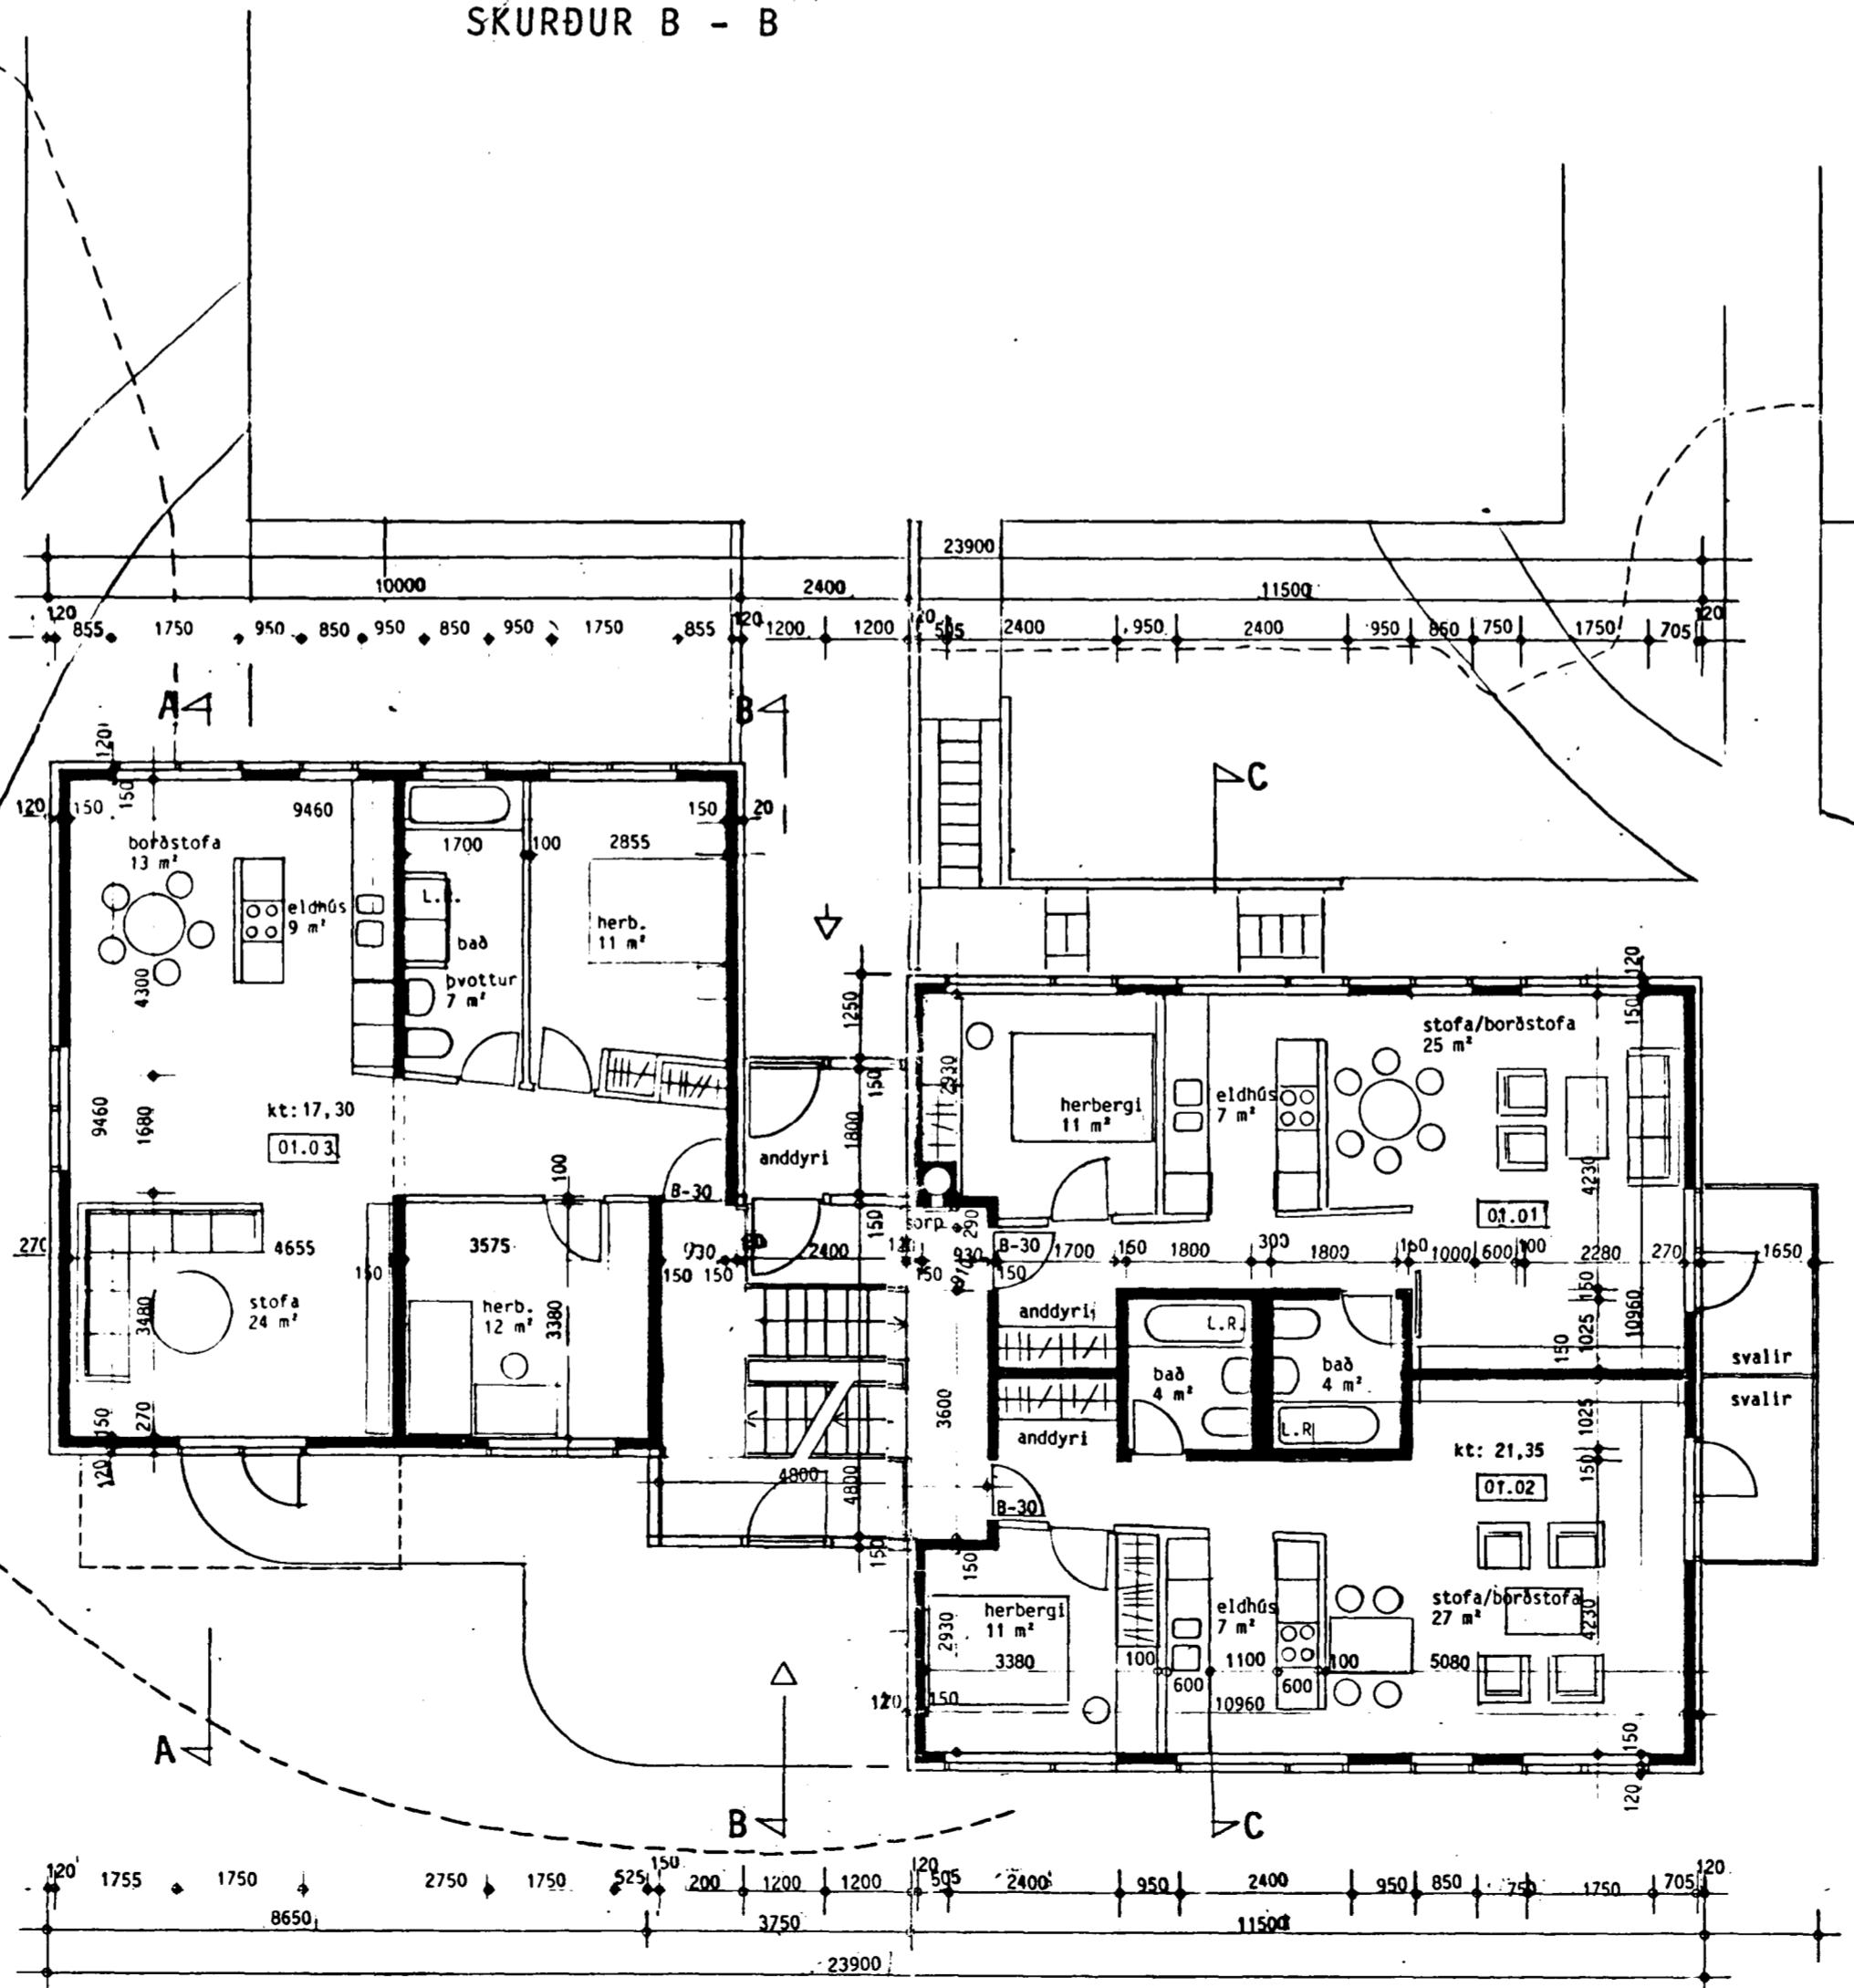

GRUNNMYND 1. HÆÐAR

Jón Ólafur Ólafsson
 Jón Einarsson

BATTERIÐ
ARKITEKTAR
 HAFNARSTRÆTI 17
 IS 101 REYKJAVÍK
 SIMJ: 623355, FAX: 623708
 KENNITALA: 450788-1559
 JÓN ÓLAFUR ÓLAFSSON FAI
 SIGURÐUR EINARSSON FAI