



GOLFHTALAGNIR PEY Ø 25 x 25

GRUNNMUND, 1:50

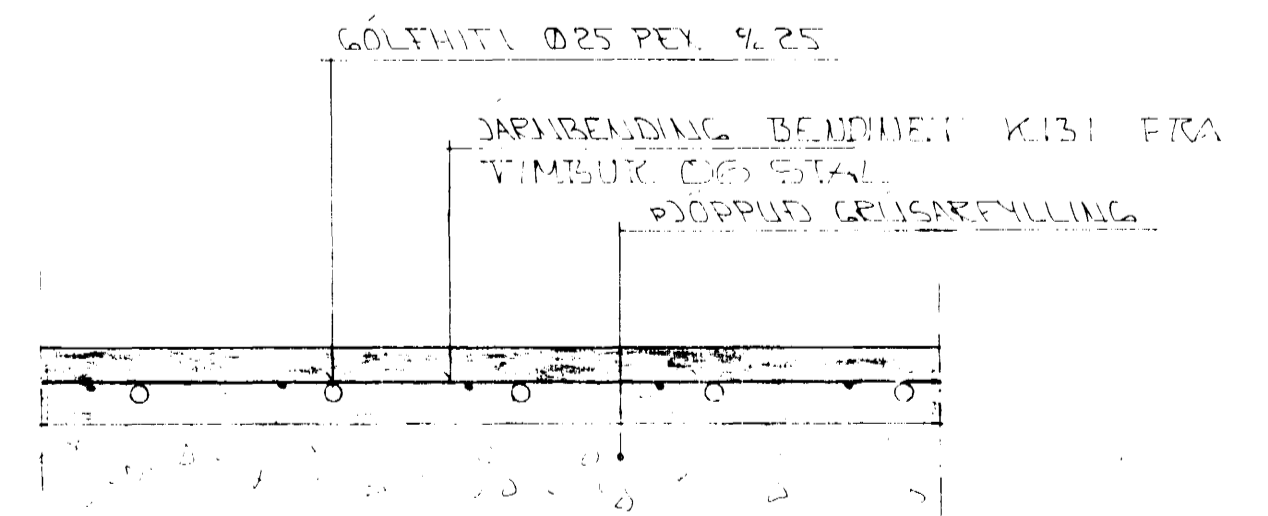

SNID Í GÓLFHITA Á FYLLINGU 1:10

ÁSKILIÐ, ELÐRI TEIKNING ÓGILD

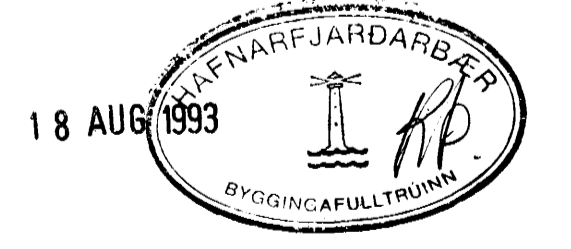

01	18.08.93 LEGU GÓLFHITA BR. BÆTTI LUN GRÝFJU	GH
	DRANGAHRÁUN 8 HAFNARFIRÐI	JUN 93
	GÓLFHTALAGNIE	GH
		5115
		2-03