



Sneiðing A - A

1 : 100

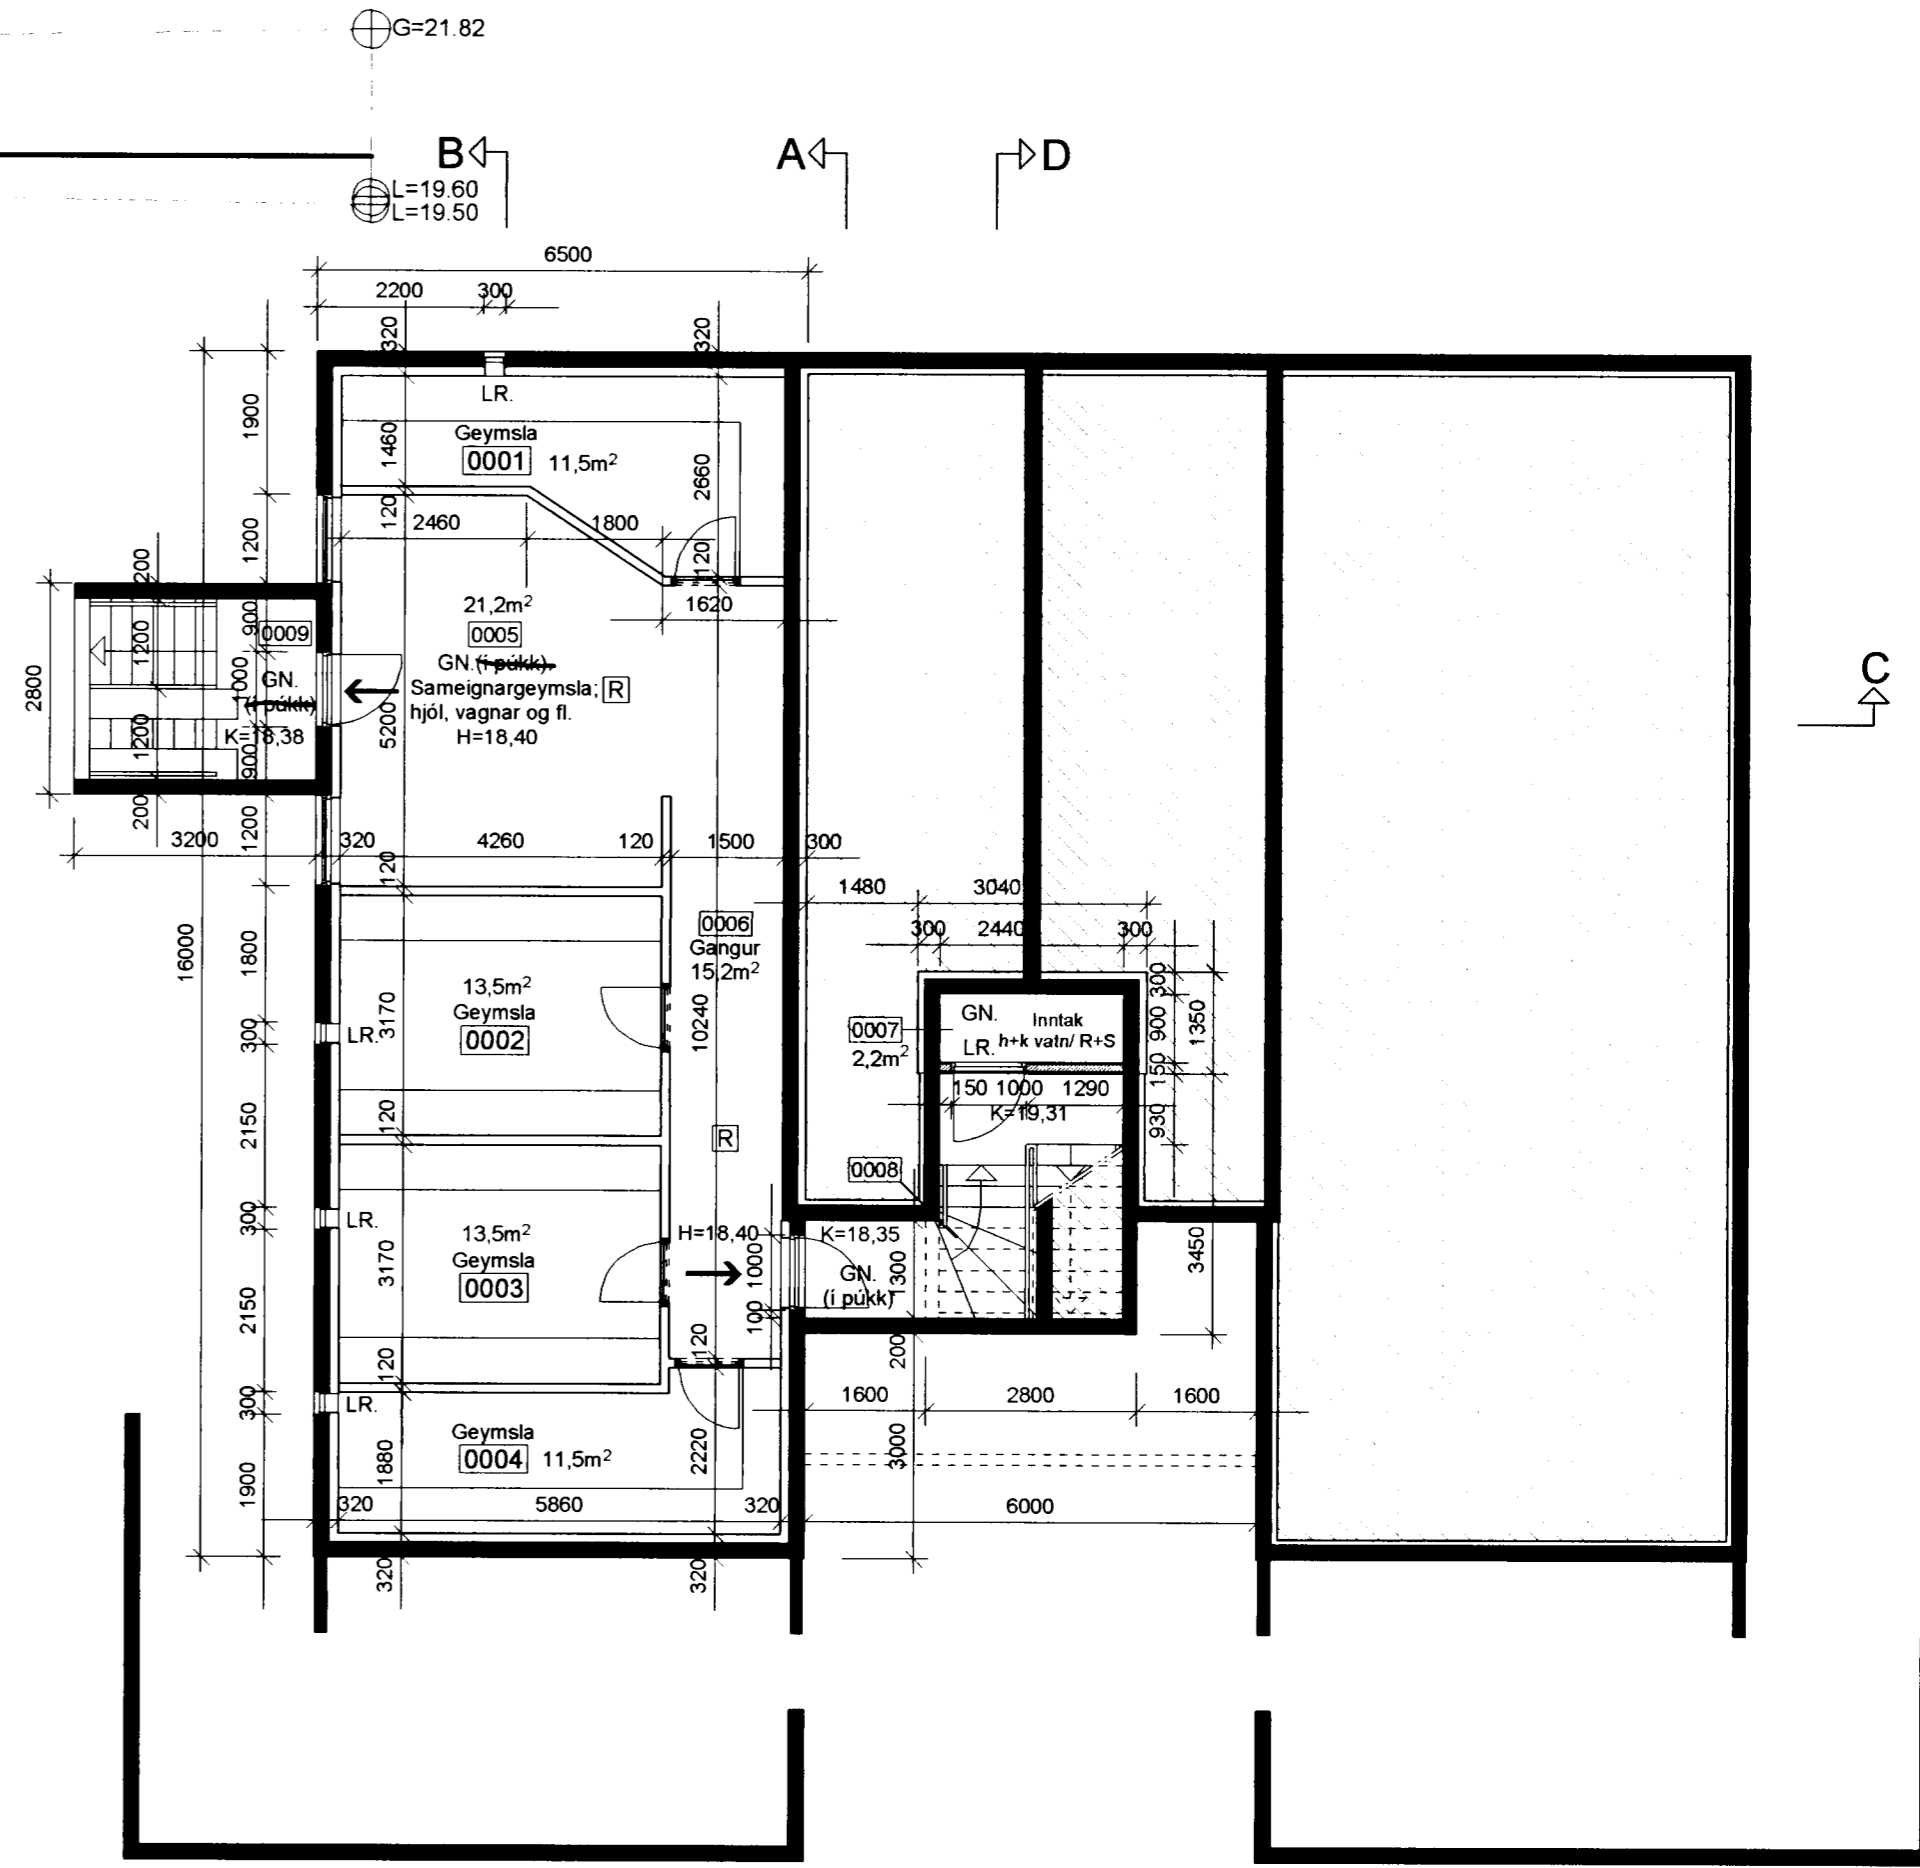

Grunnmynd kjallara

1 : 100

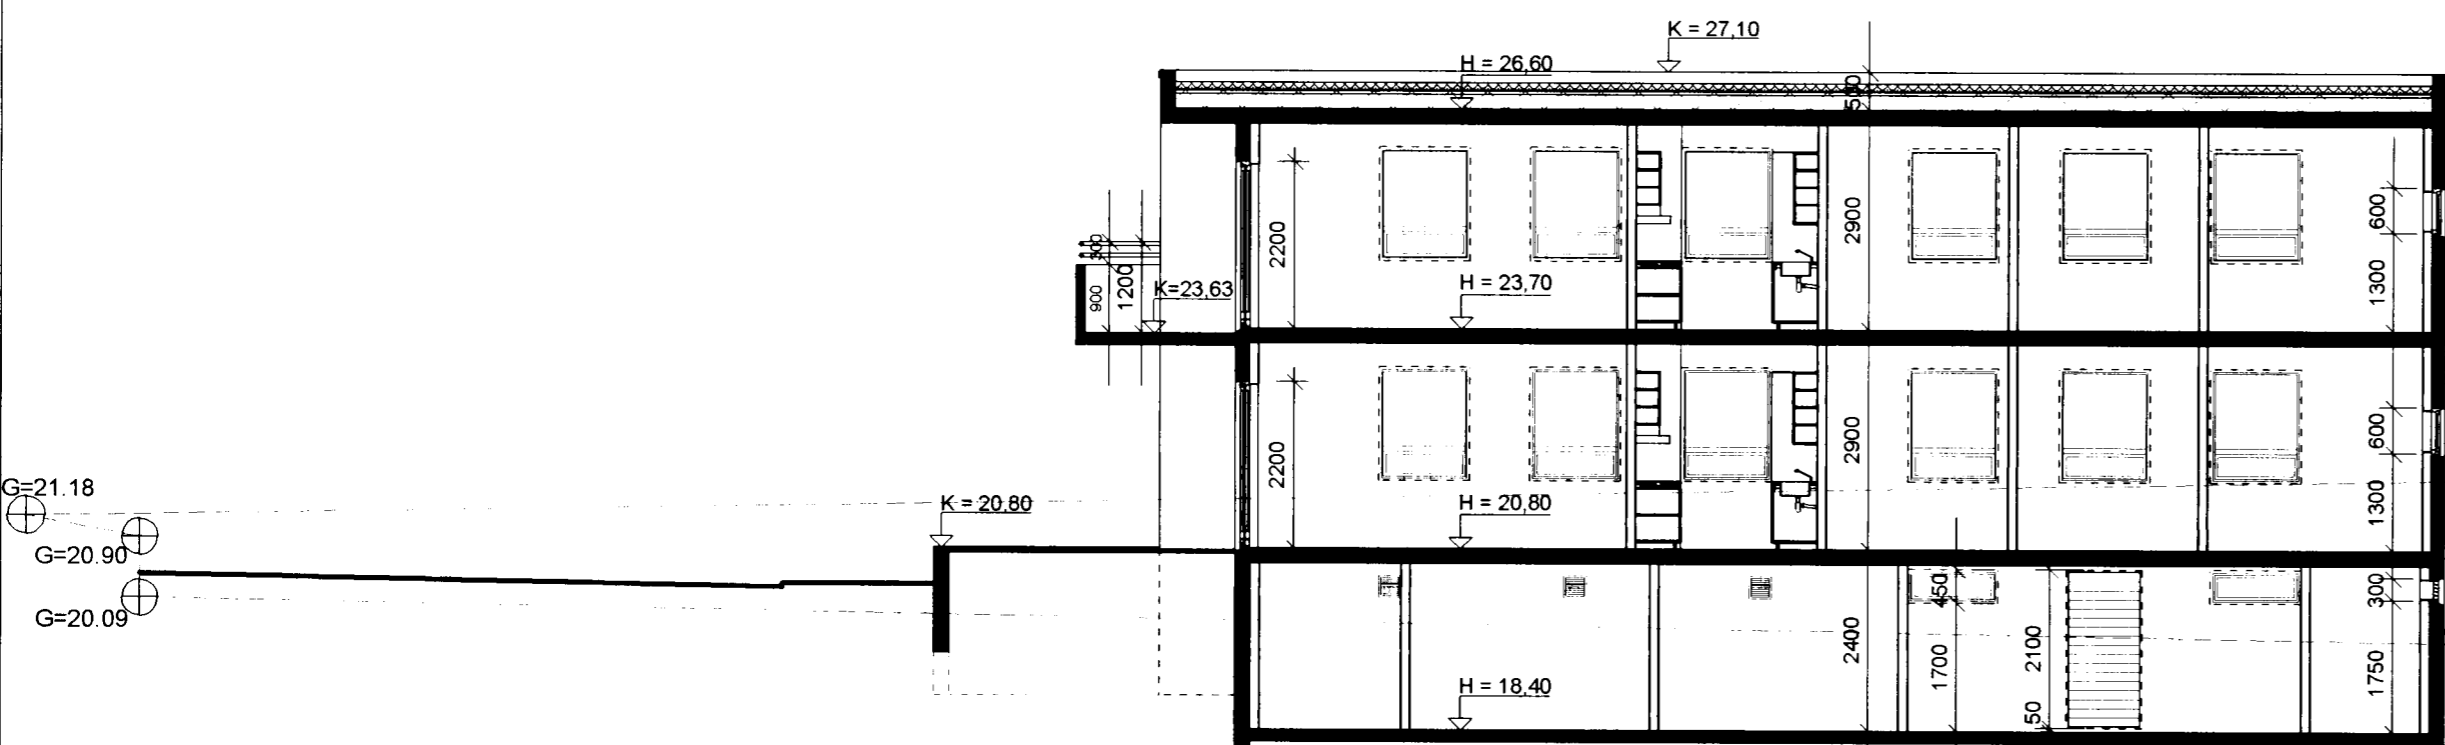

Sneiðing B - B

1 : 100

ARKITEKTAHÖNNUN ehf

Kennitala 531201-4180
PETUR ÖRN BJÖRNSSON ARK. FAI
TEIKNISTOFA TÚNGÖTU 14, 101 RVK
VS./FAX 551 0160 HS. 551 0101

Heiti verks: **DREKAVELLIR 10**

Heiti teikningar: **Grunnmynd kjallara
Sneiðingar A - A og B - B**

Mkv.: 1 : 100	Nr. teikningar: 03	Dags.: 01. 02. 2005
Verknr.:		Teiknað P.Ö.B