


RÚMMYND HITALAGNA

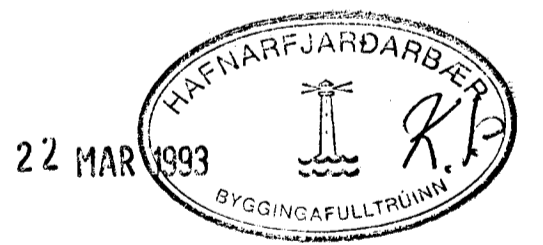

01	MARS '93	SÉR LAGNIE FYR ÍBÚÐIR	GH
BR.NR.	DAGS.	EDLI BREVTINGAR	SIGN.
		DVERGHOLT 19 HAFNARFIREI	DAGS. MARS'91
		RÚMMYND HITALAGNA	HANNAÐ P.B.
		MÆLIKV. A 1:50	TEIKNAD
		SIGURÐUR ÞORLEIFSSON TEKNIFRÆÐINGUR F.T.F.I.	VERK NR. 9055
		STRANDGÖTU 11 HAFNARFIREI SÍMI 54751/54255	BLAD NR. 2-05