



SÉRMYND XII 1:5

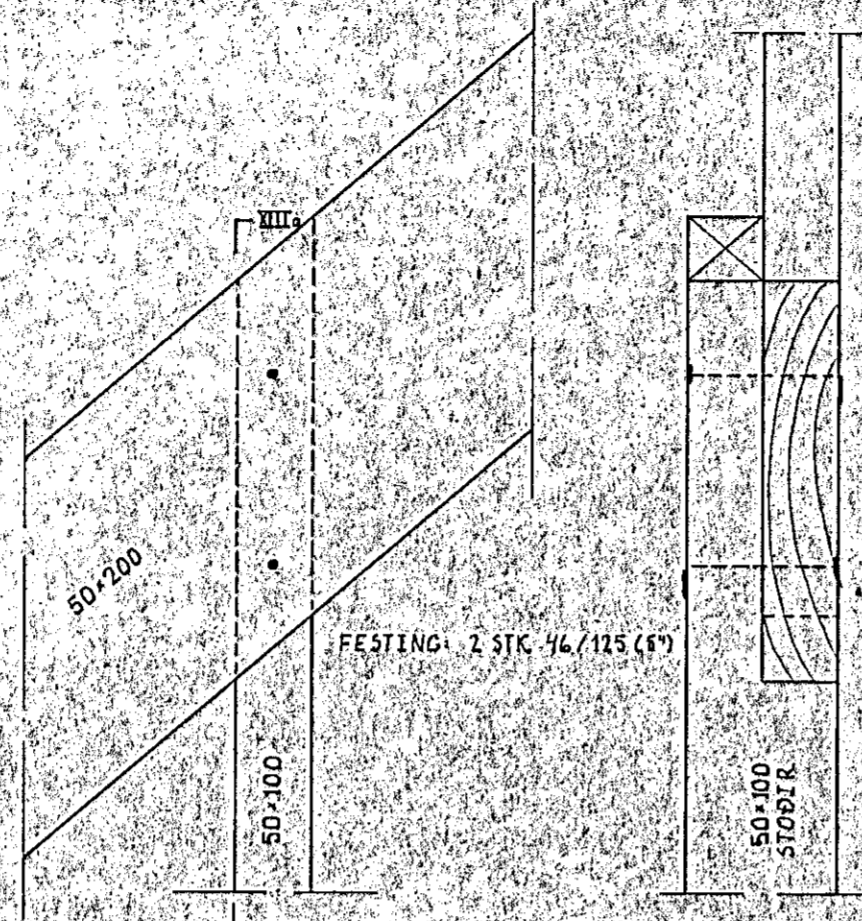

SÉRMYND XIII 1:5

SNID XIIIa-XIIIb 1:5

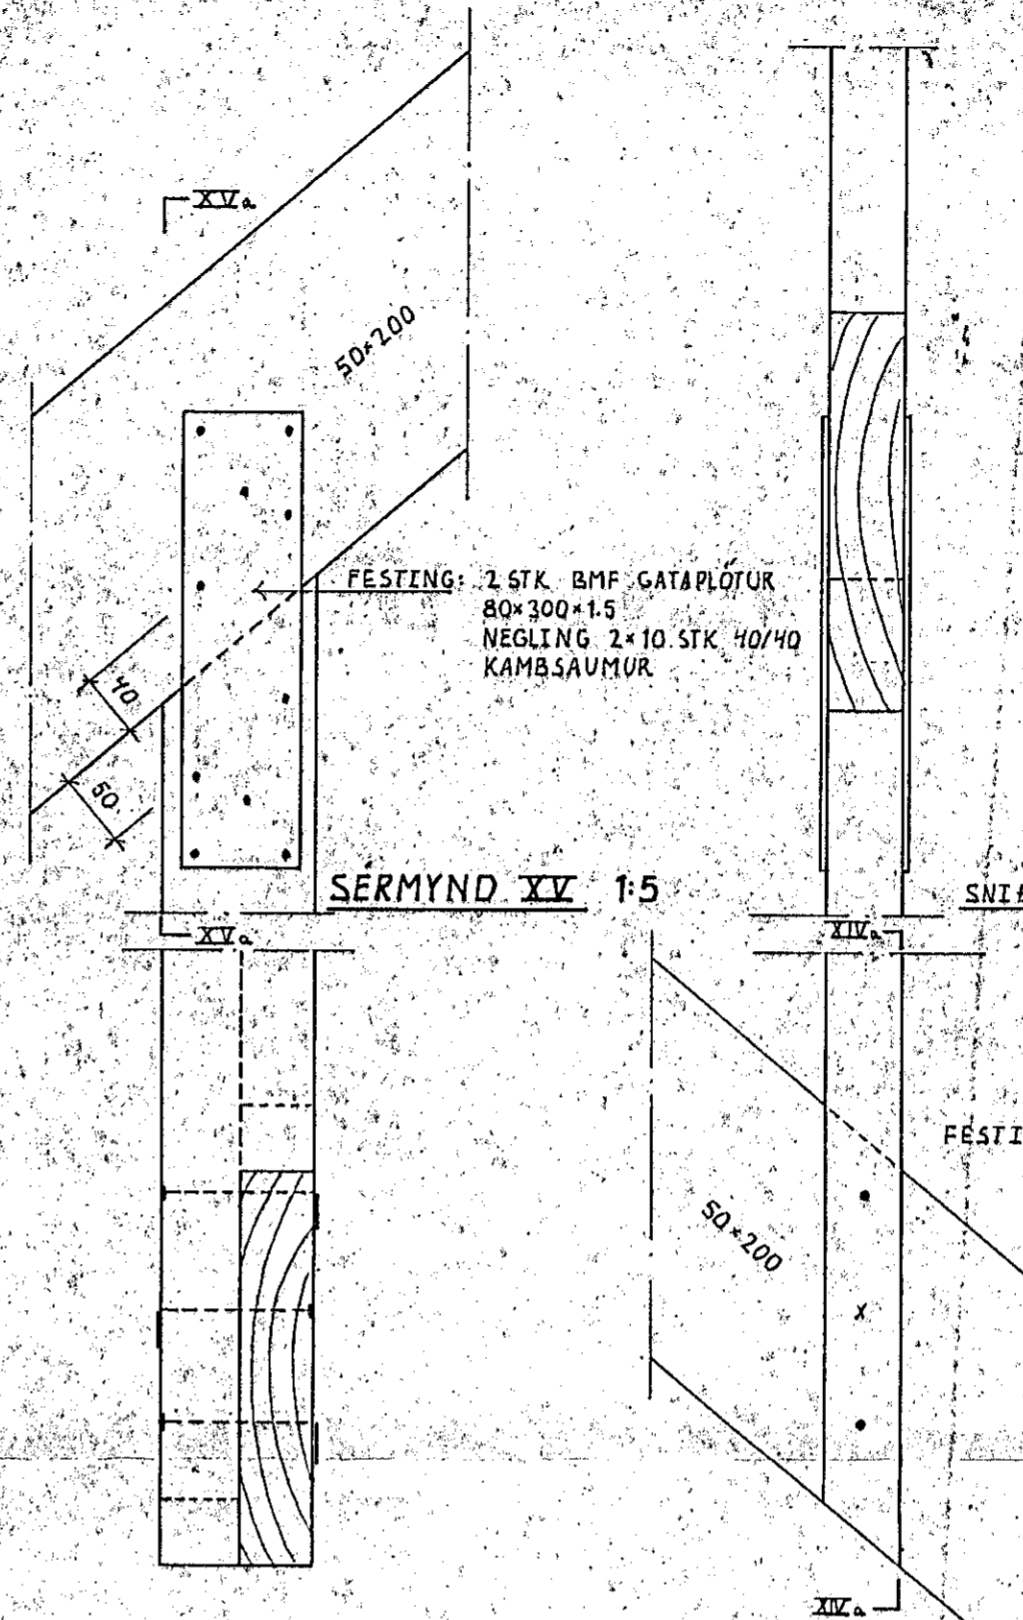


SÉRMYND XV 1:5


SNID XVa-XVb 1:5

SNID XIVa-XIVb 1:5

SÉRMYND XIV 1:5

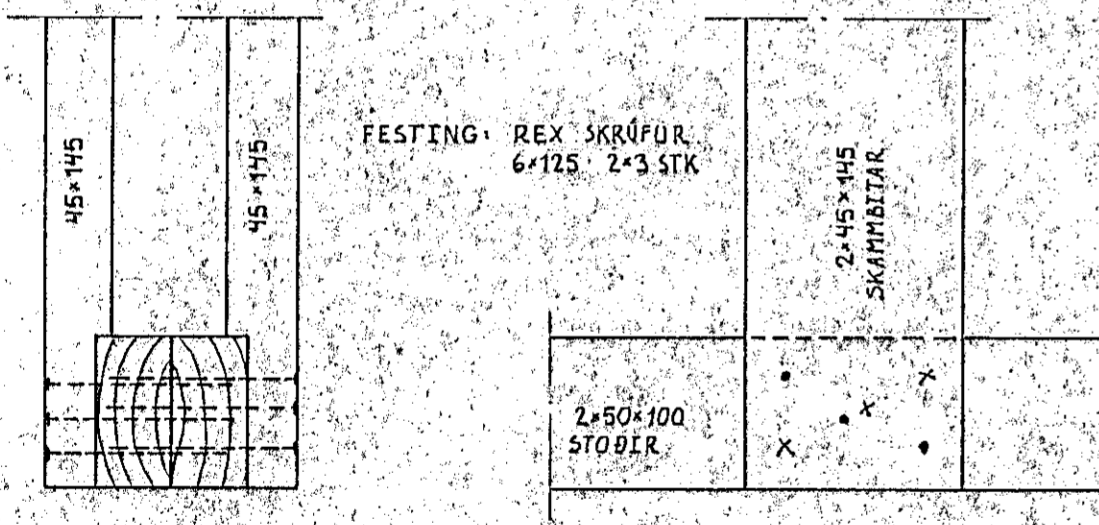


SÉRMYND XVI 1:5

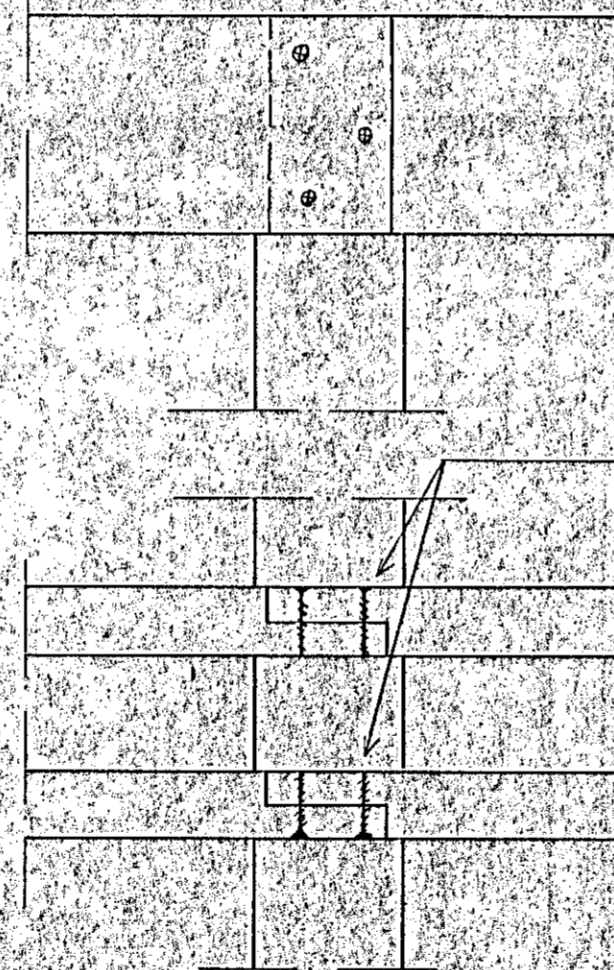

SAMSETNING TOGBANDA Í KVISTUM

ÁSKILID, ELDRI
TEIKNING ÓGILD

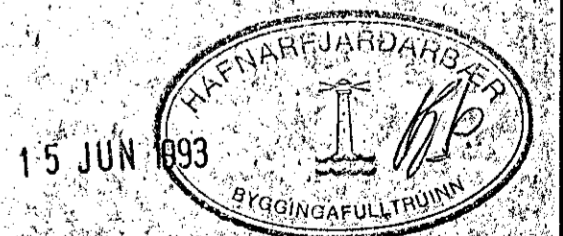

(A) BREYTT 7.6.1993 A.S.P.

GLITBERG 5, HAFNARFIRÐI	DAGS: JAN 1993
SÉRMYNDIR XII-XVII	HANNAÐ KS/ASP
MÆLIKVAÐI: 1:5	TEIKNAD ASP
KRISTJAN STEFANSSON TEKNIFRÆÐINGUR T.F.F.I.	VERK NR FLOKKUR
KEITVAJIKURVEG 68, HAFNARFIRÐI 501 652 100	19209 01
	TEIKNING NR
	07