



PLÖTUFYKUR 12 CM

1:50

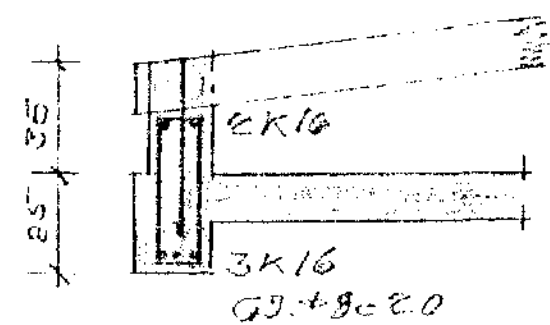

A-A 1:20

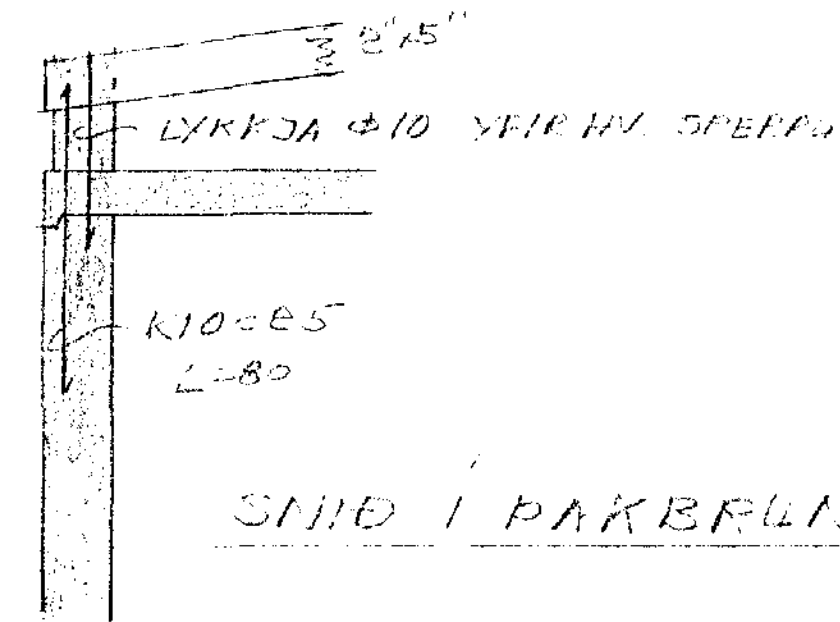

SNID Í PAKBRUN 1:20

HJALLABRÚ 10  
17  
BREITINGAR

BLÓTT AF LOFTI YFIR 3. HÆÐ

NOV. 4/1971

DWY

