




Inntök samþykkt 30.11.1976  
 H.H. RÁFVEITU HAFTARFJÁRDAR  
 Hl. Einarsson

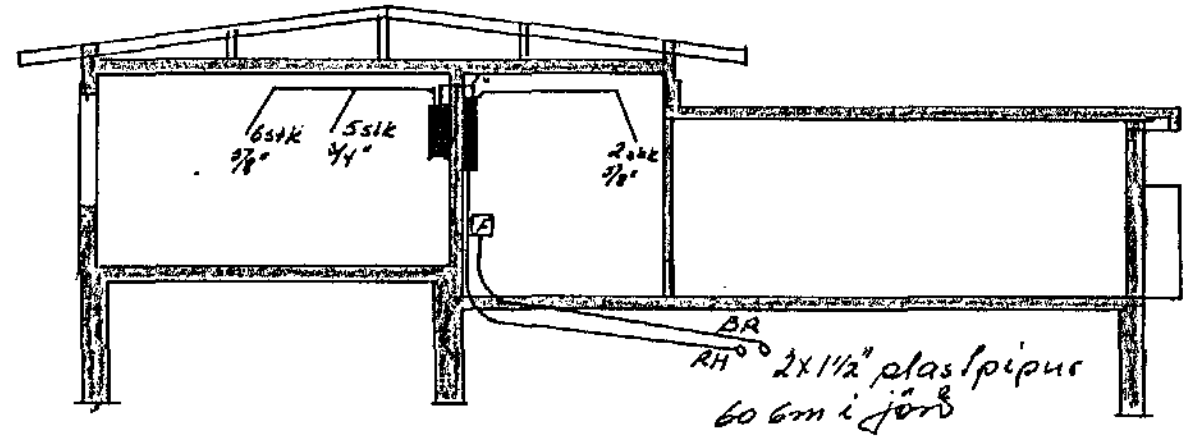

2x1 1/2" plasspípur  
 60.6m í jörð

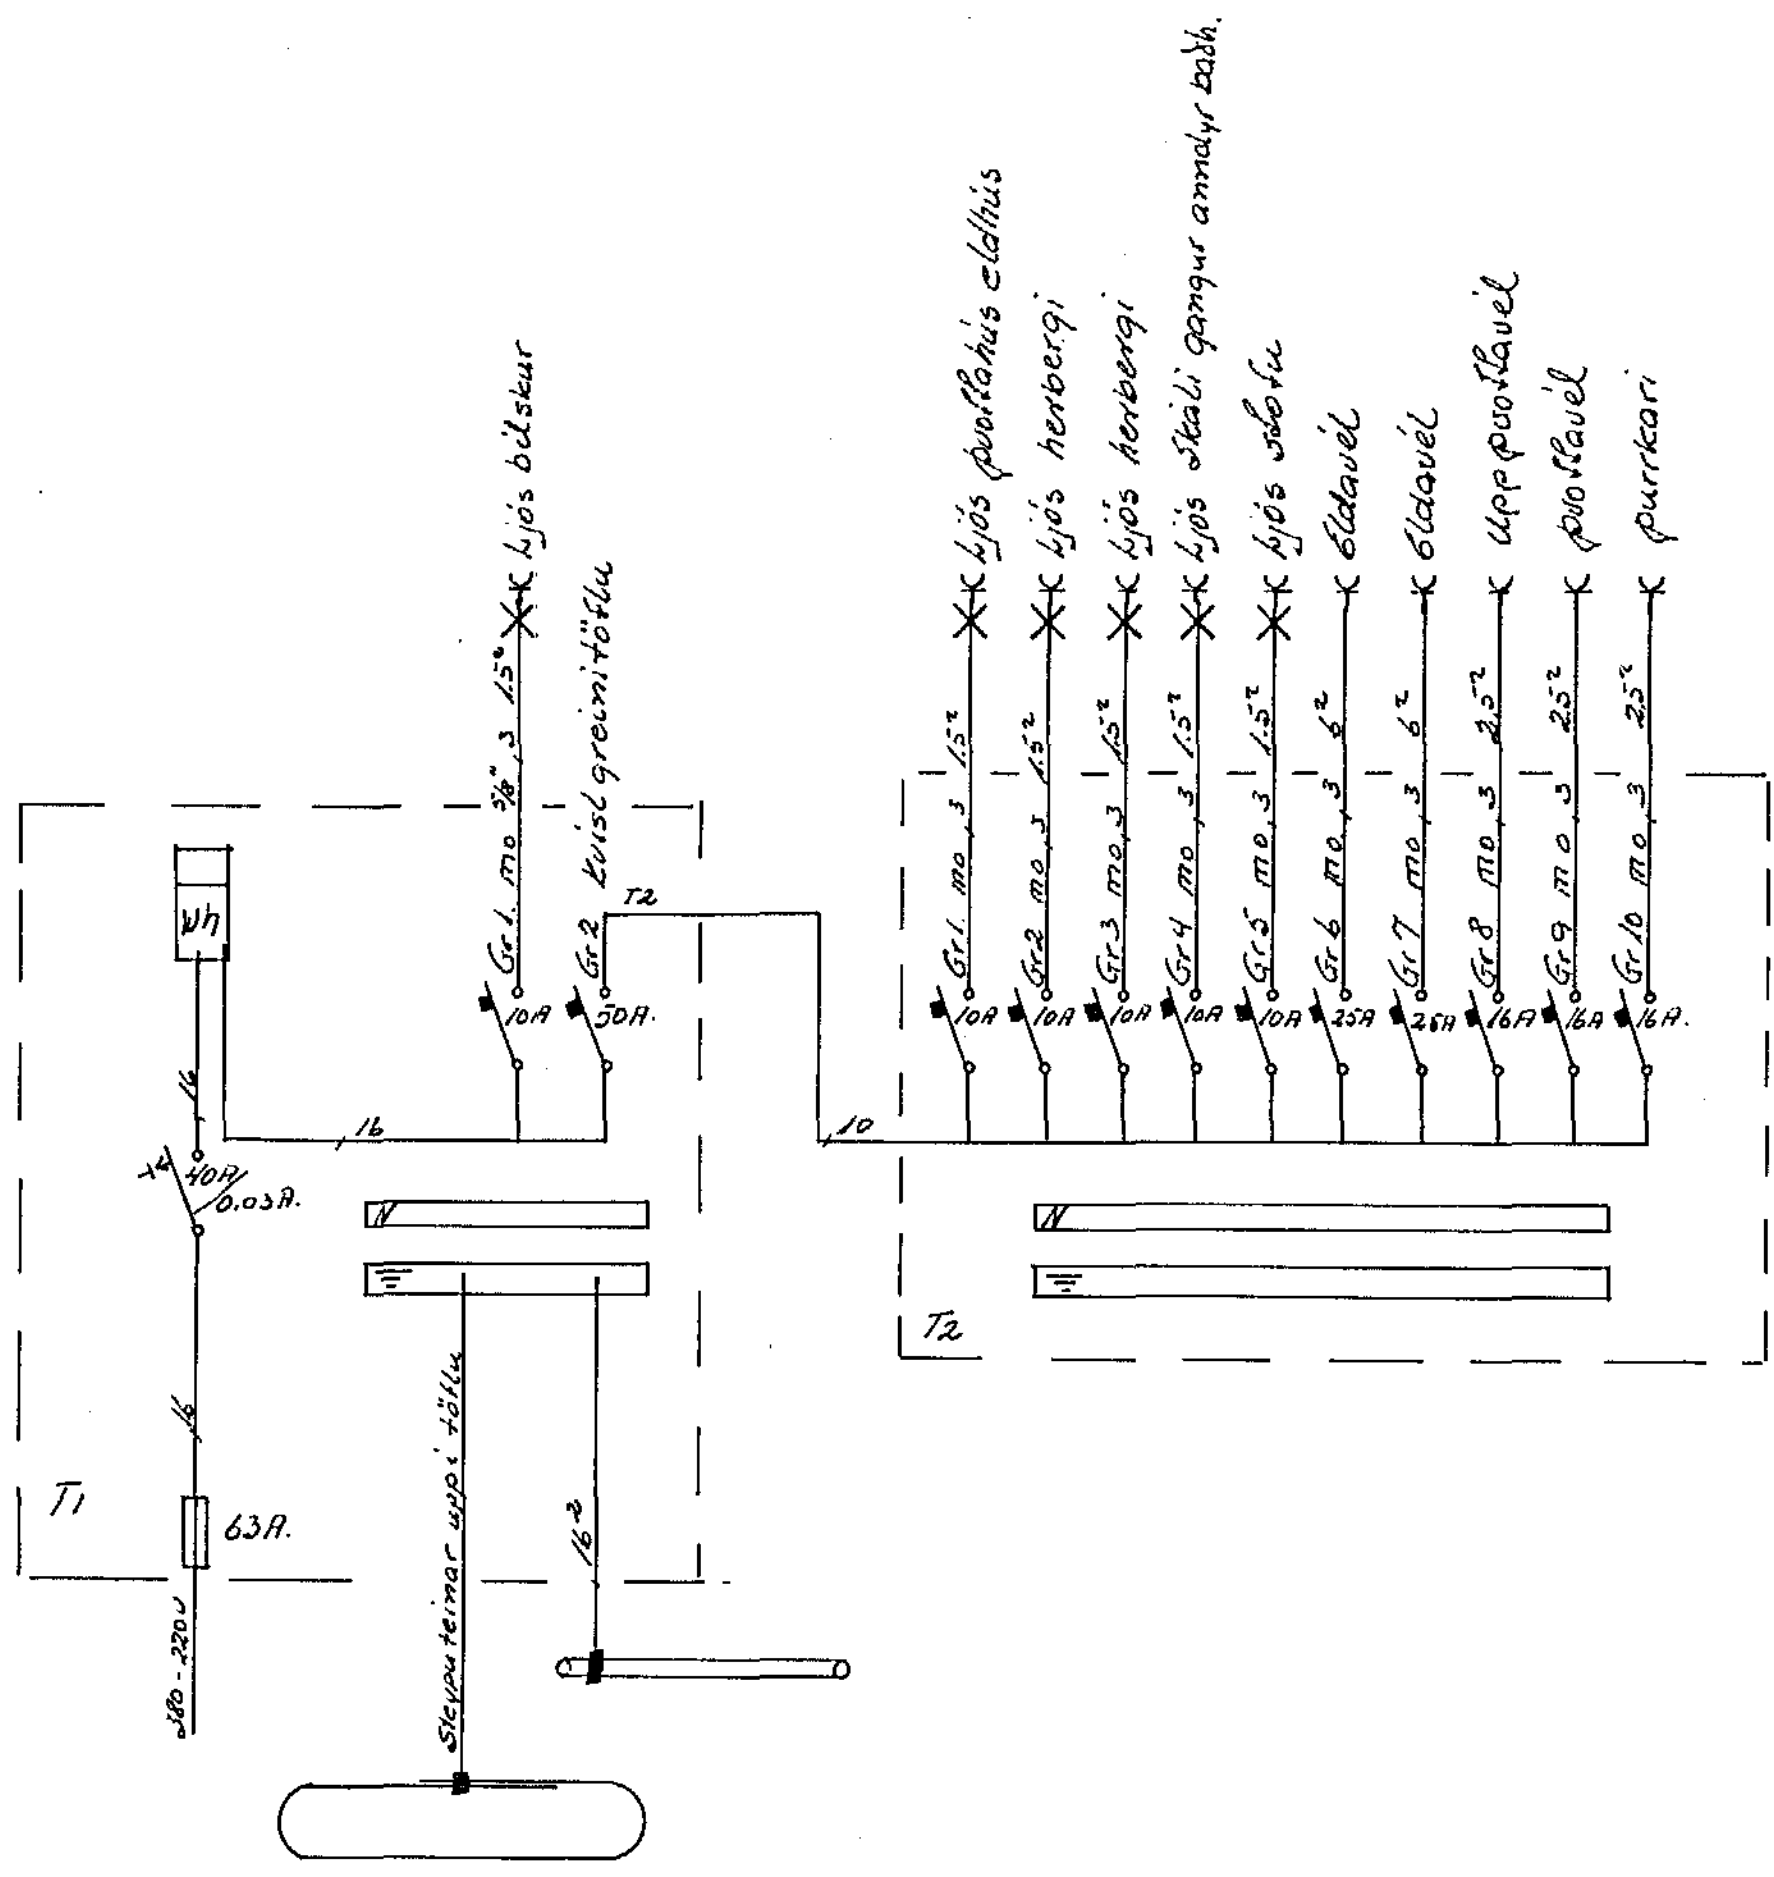

Hjalla braut.

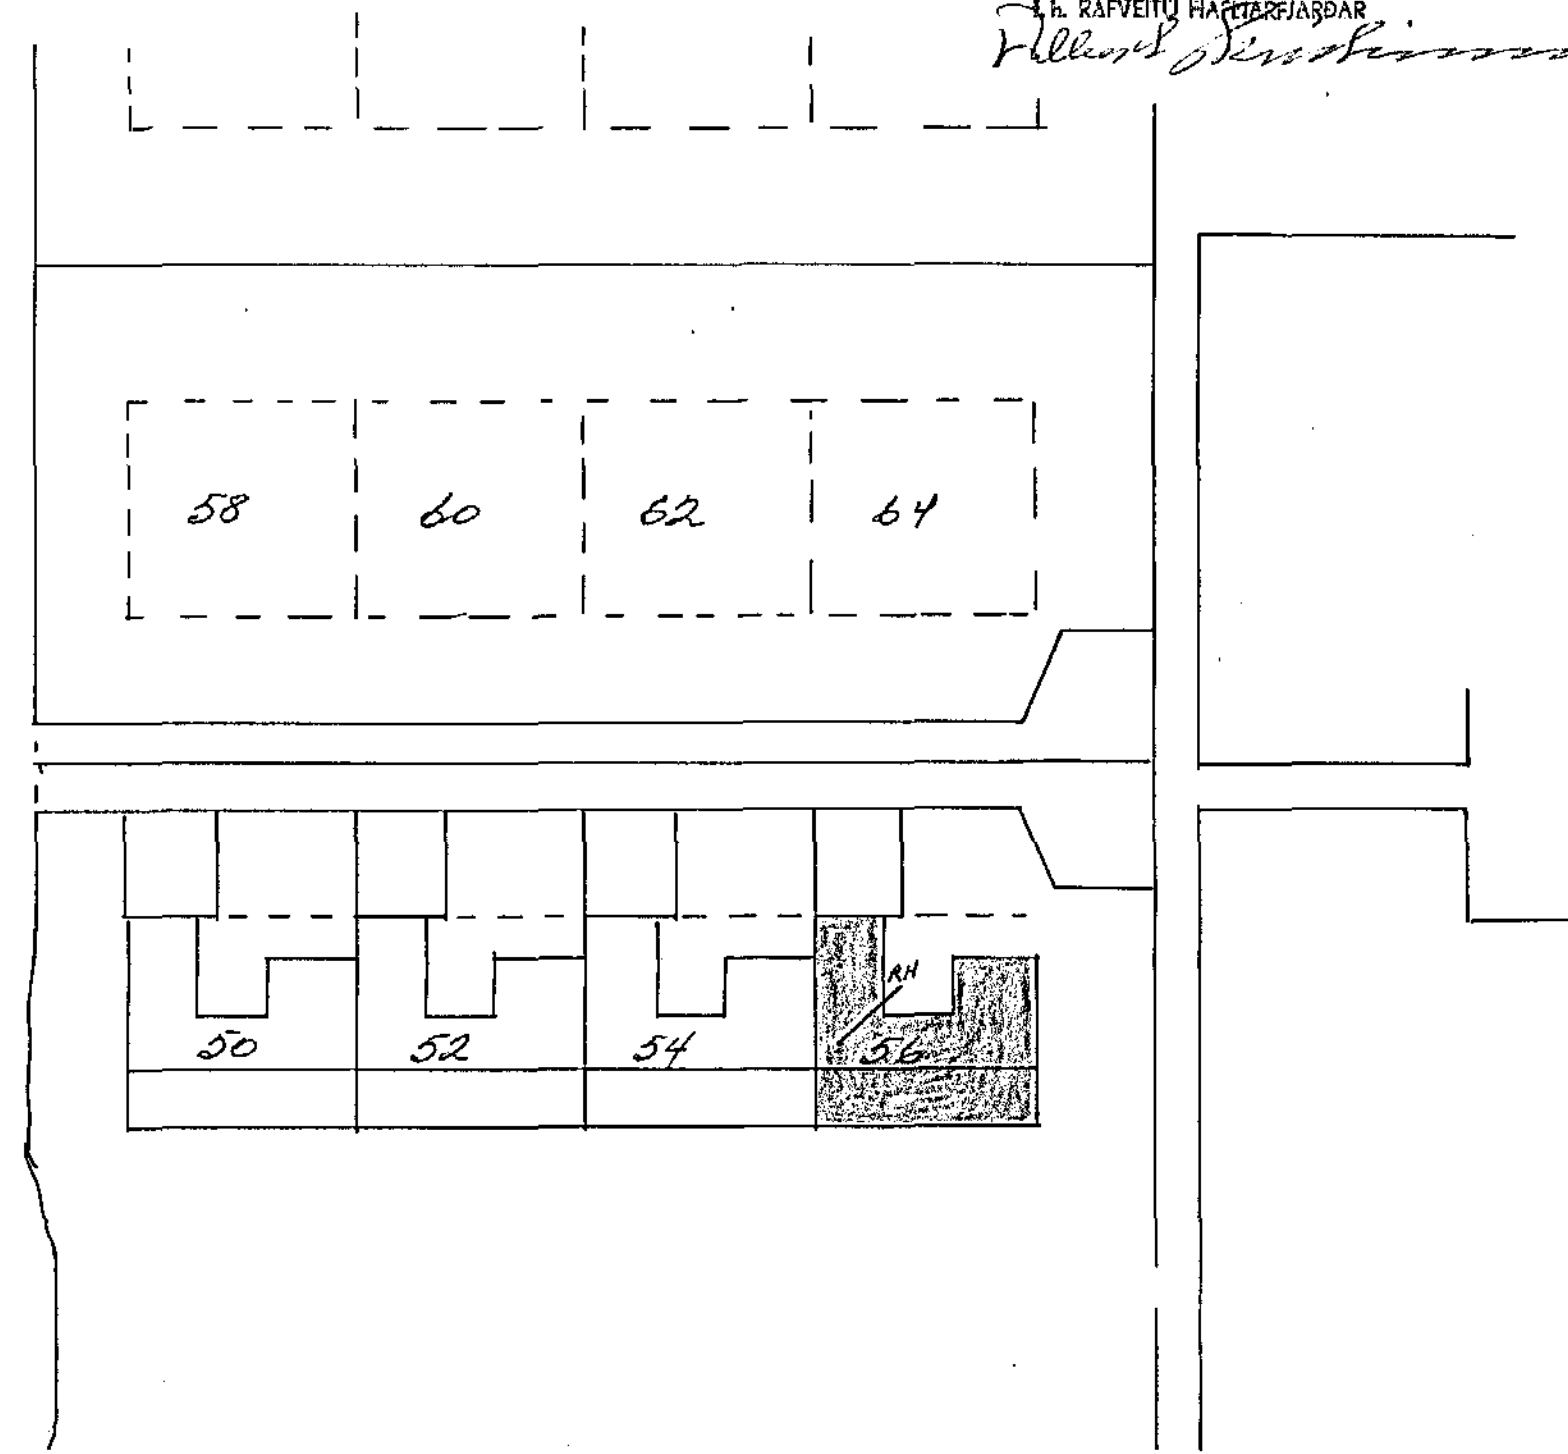

Breytingar	NR	Dag.	Nafn		
				Jens Einarsson	5.52829
				Hjalla braut 56	A.R. T.R. 5.
				Þverskurður afsláðu	M: 1:500 1:100
				og einstímunynd	B. 2 af 2
					Jún. 1976