

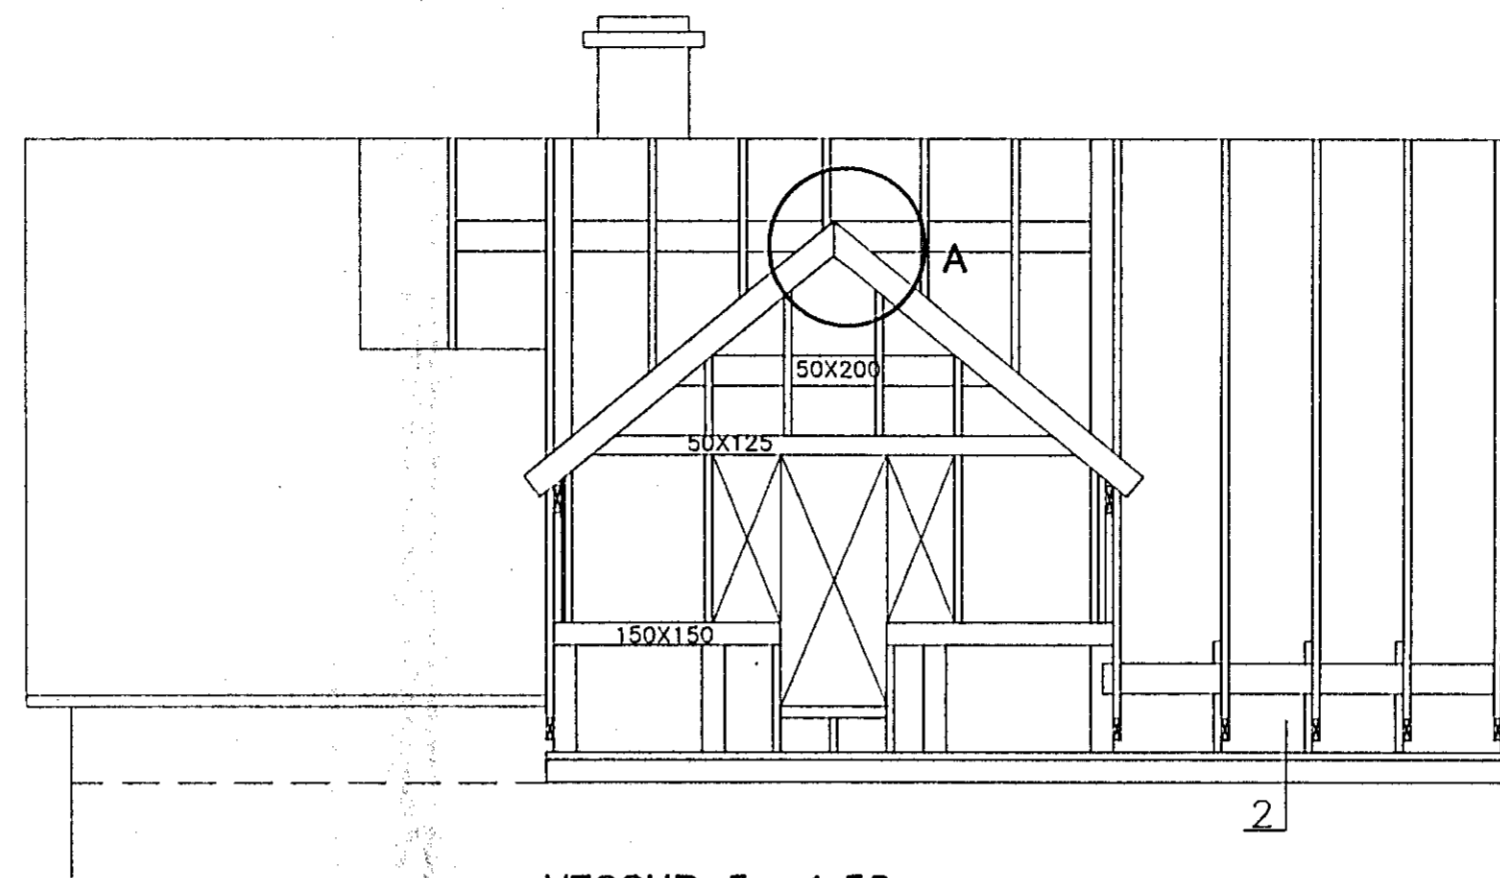


VEGGUR 4 1:50

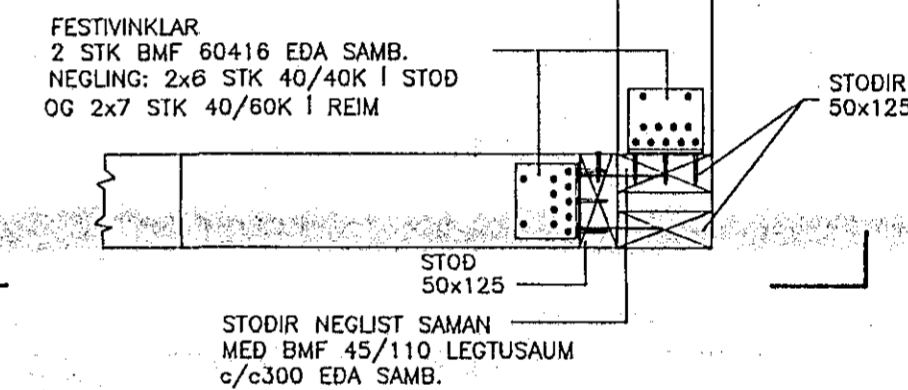


VEGGUR 5 1:50

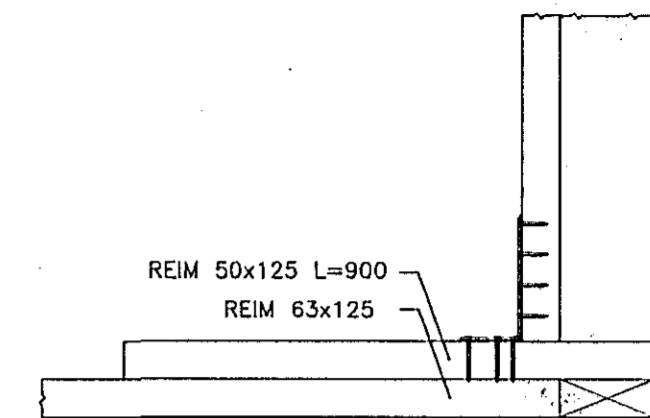


DEILI D. 1:10


SNID \*D ER SPEGLUN AF SNIDI D

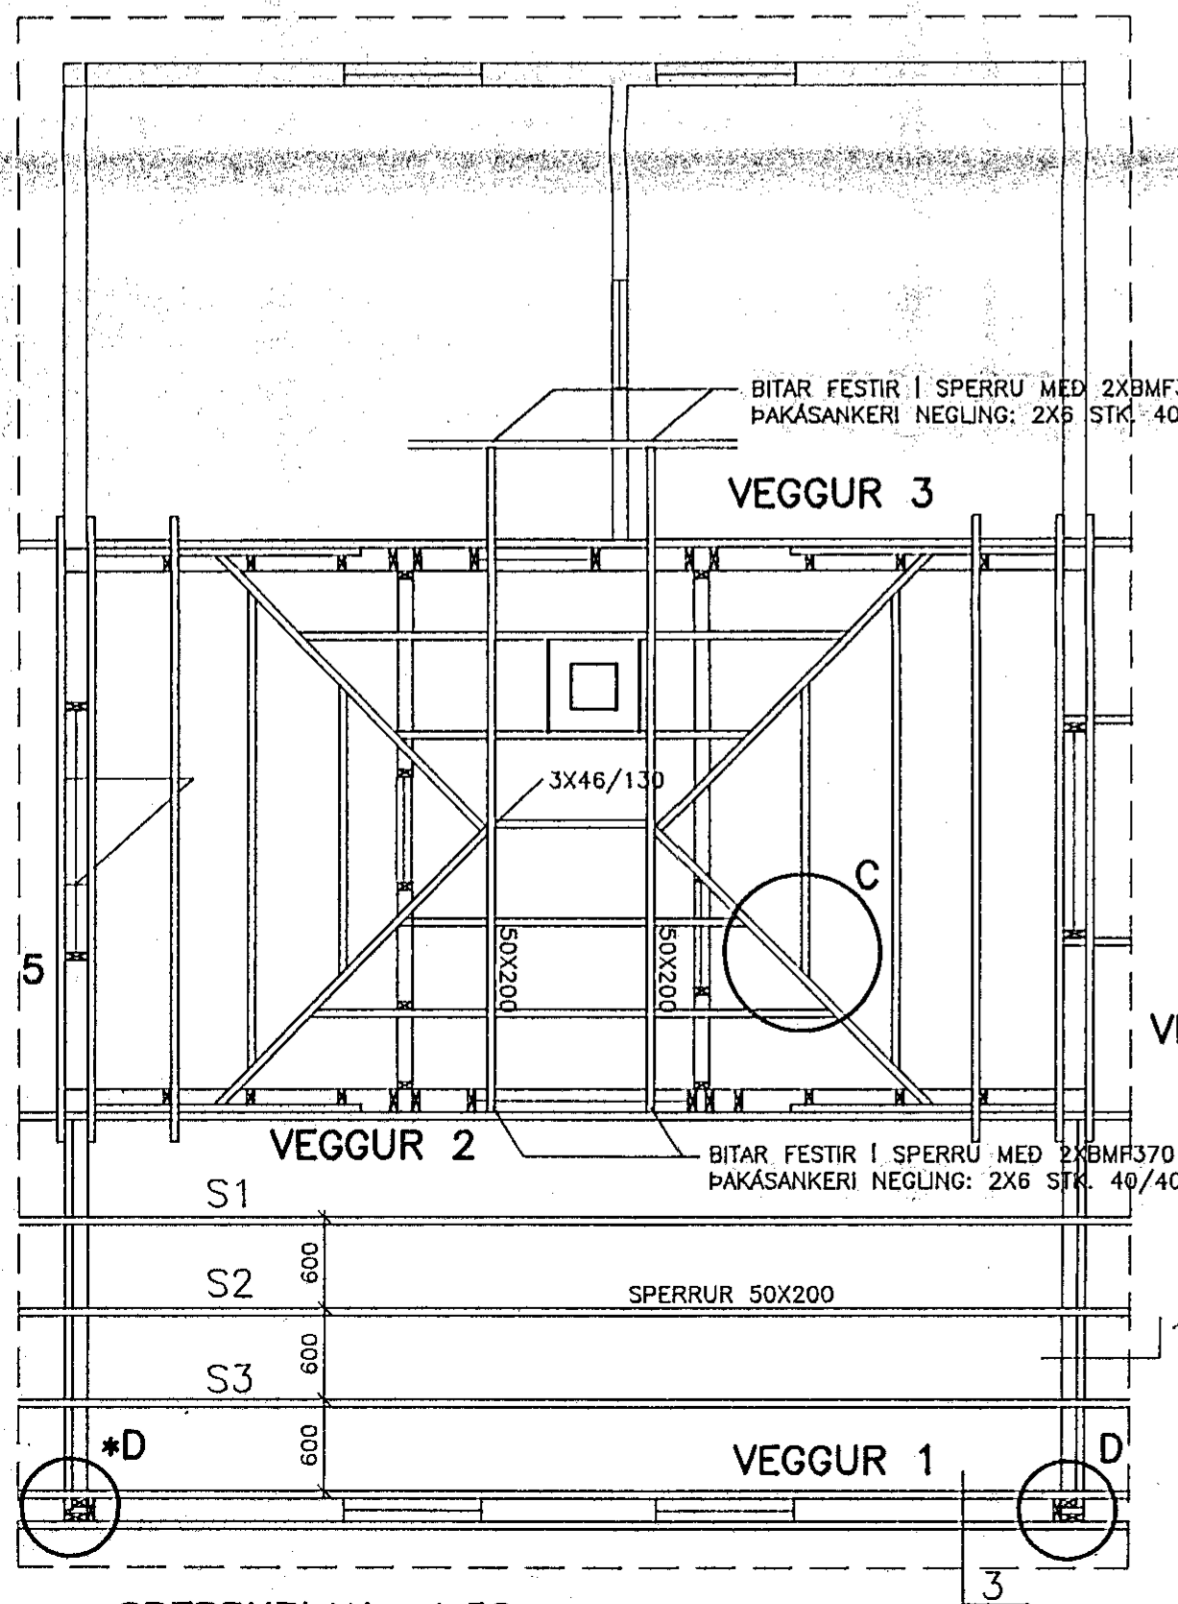

SPERRUPLAN 1:50

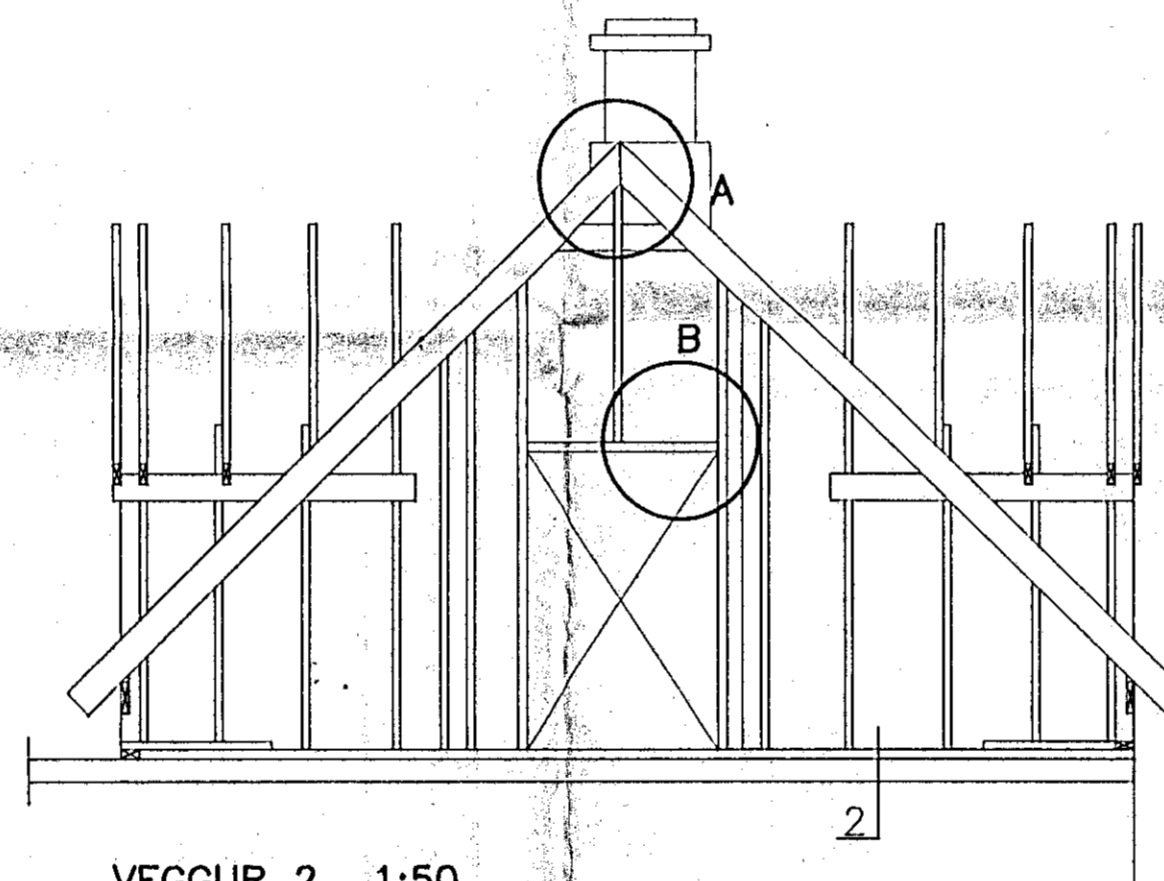


VEGGUR 2 1:50

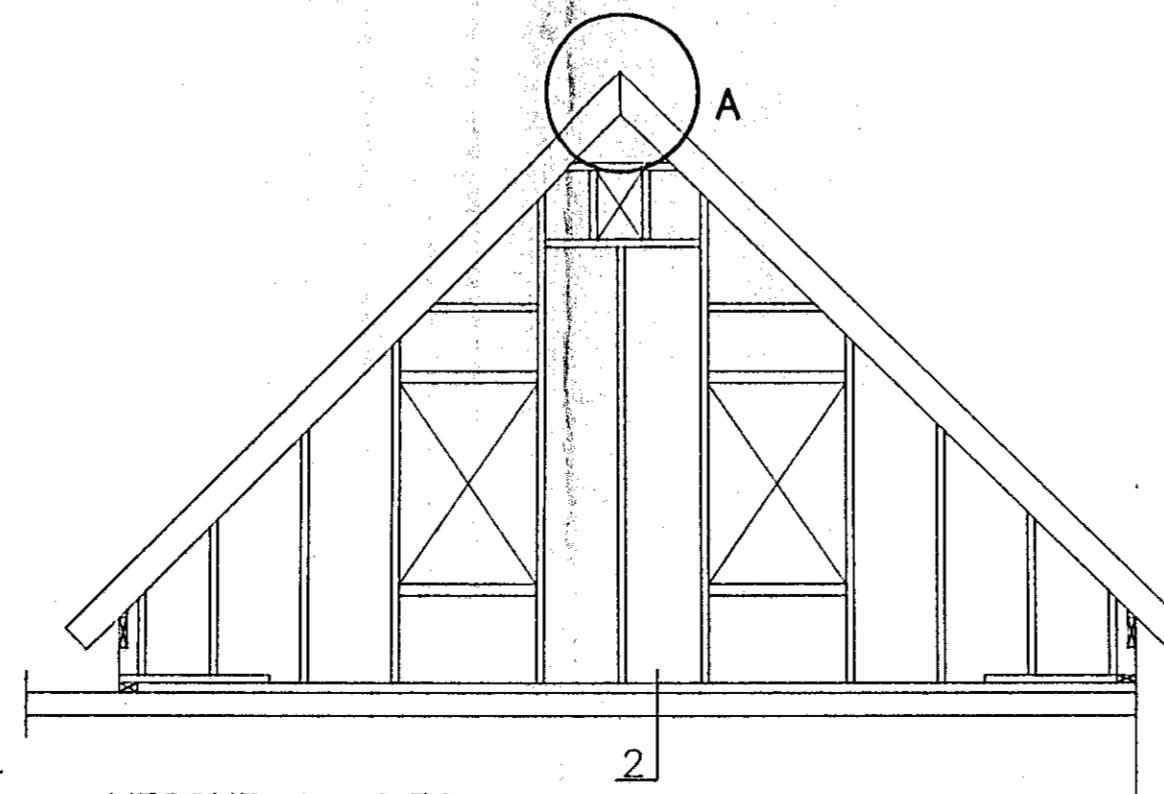

VEGGUR 1 1:50

ÁSKILID, ELÐRI  
TEIKNING ÓGILD

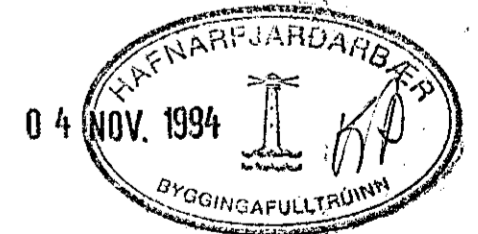

SKÝRINGAR SJÁ TEIKNINGU NR. 4

ÖLL MÁL ERU Í MILLIMETURM

SPERRUM BREYTT, MENISÁS TEKINN, BITI SETTUR NÓV'94 T.J.		
BREYTING		
HANNAÐ T.J.	JÓN BERGSSON DIPL. ING.	VERKFR. VERKFRÆÐIHÖNNUN M.V.F.I SMÁRAHVAMMI 4, HAFNARF. S. 51974
TEIKNAD T.J.	J.B.	HOLTSGATA 11
YFIRFARID J.B.	VERK 9411	VEGGIR / DEILI
		M=1:50
		DAGS. OKT. 1994