



MÁLSETNING SÖKKLA M 1:50

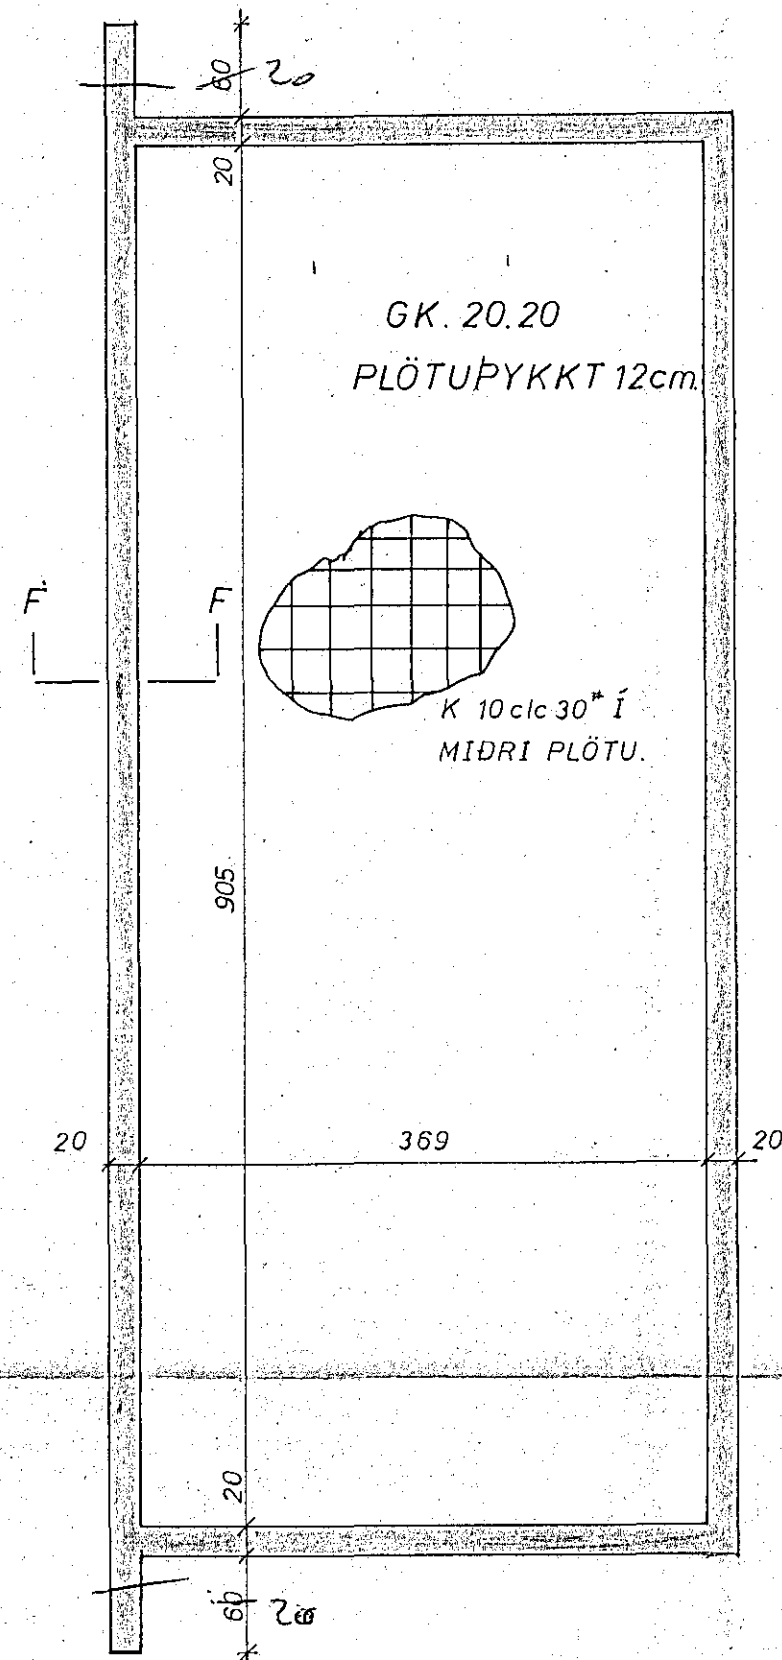


JÄRNUN VEGGJA M 1:50


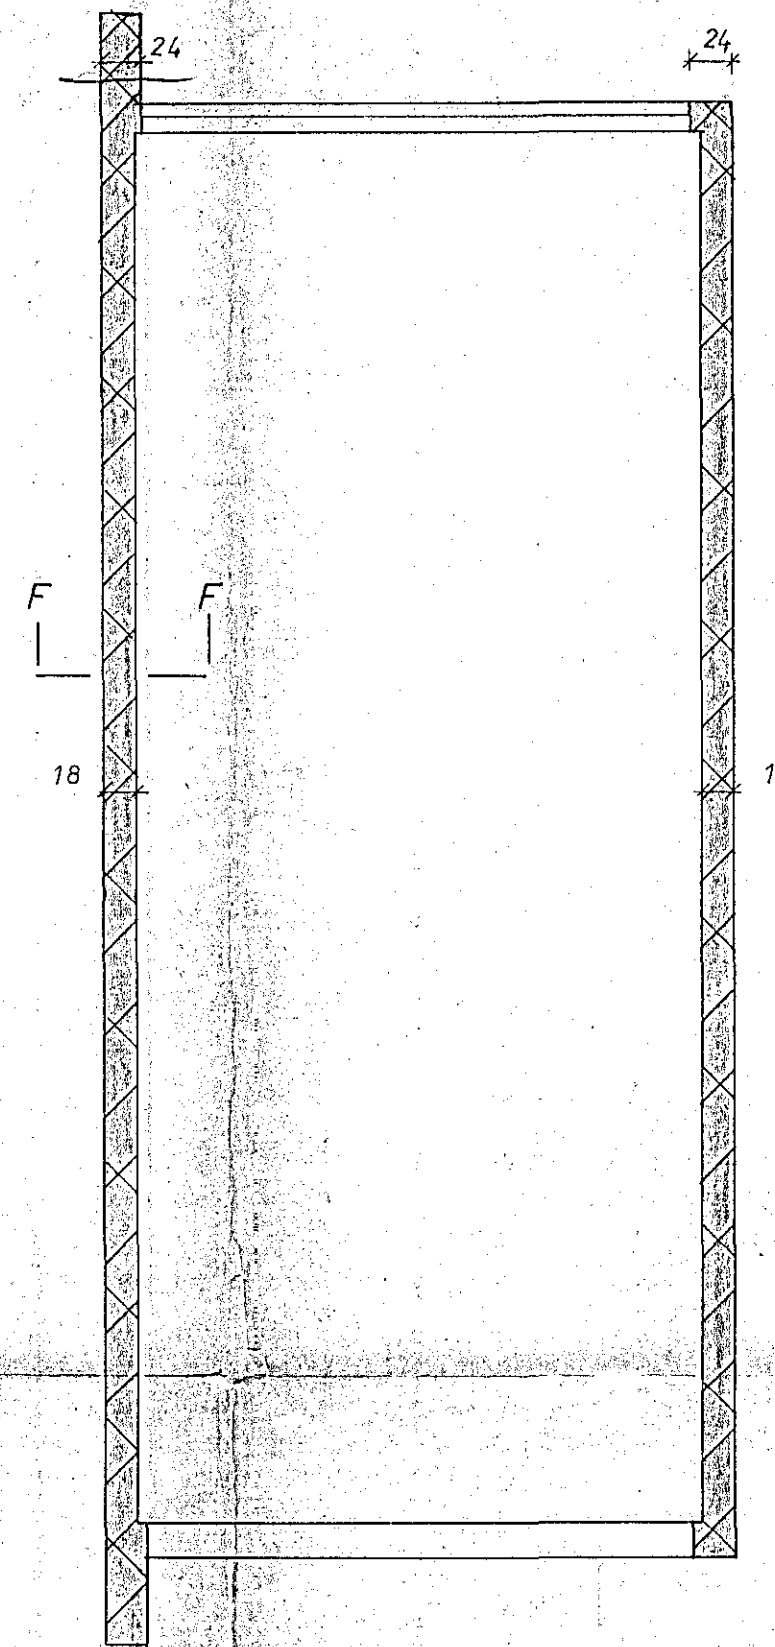


K 10 c/c 25 LÖDRÉTT Í MIDJUM VEGG
K 10 c/c 20 LARÉTT

SNID F-F M 1:10

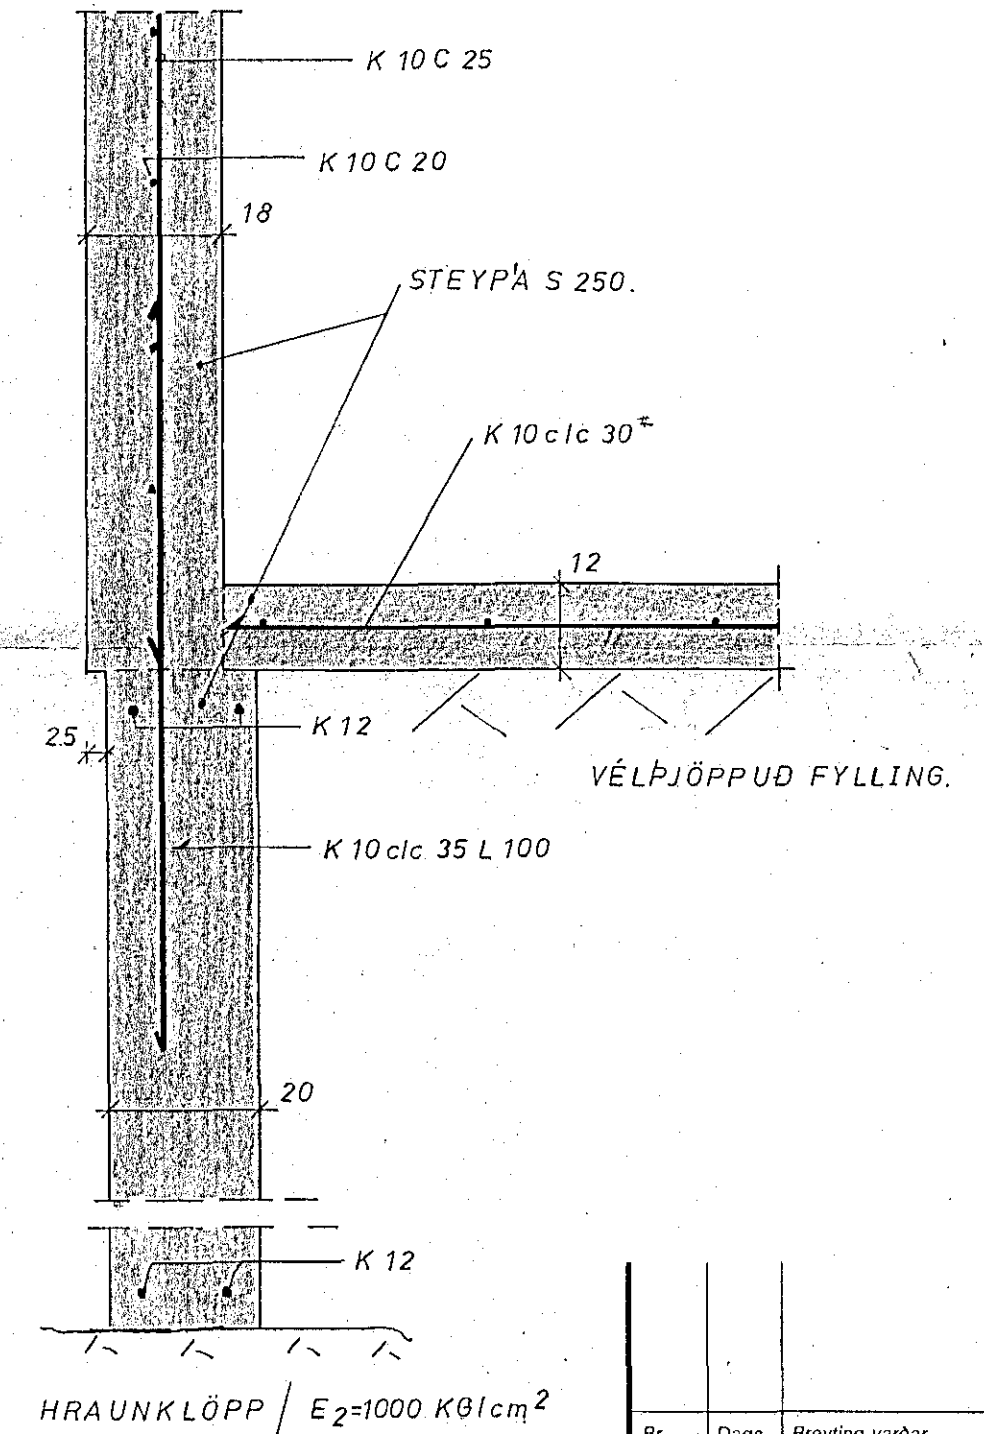

M - 1:50

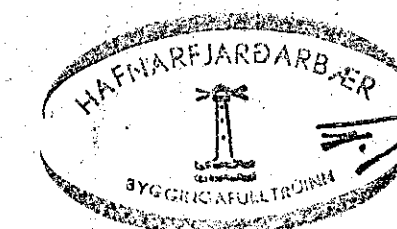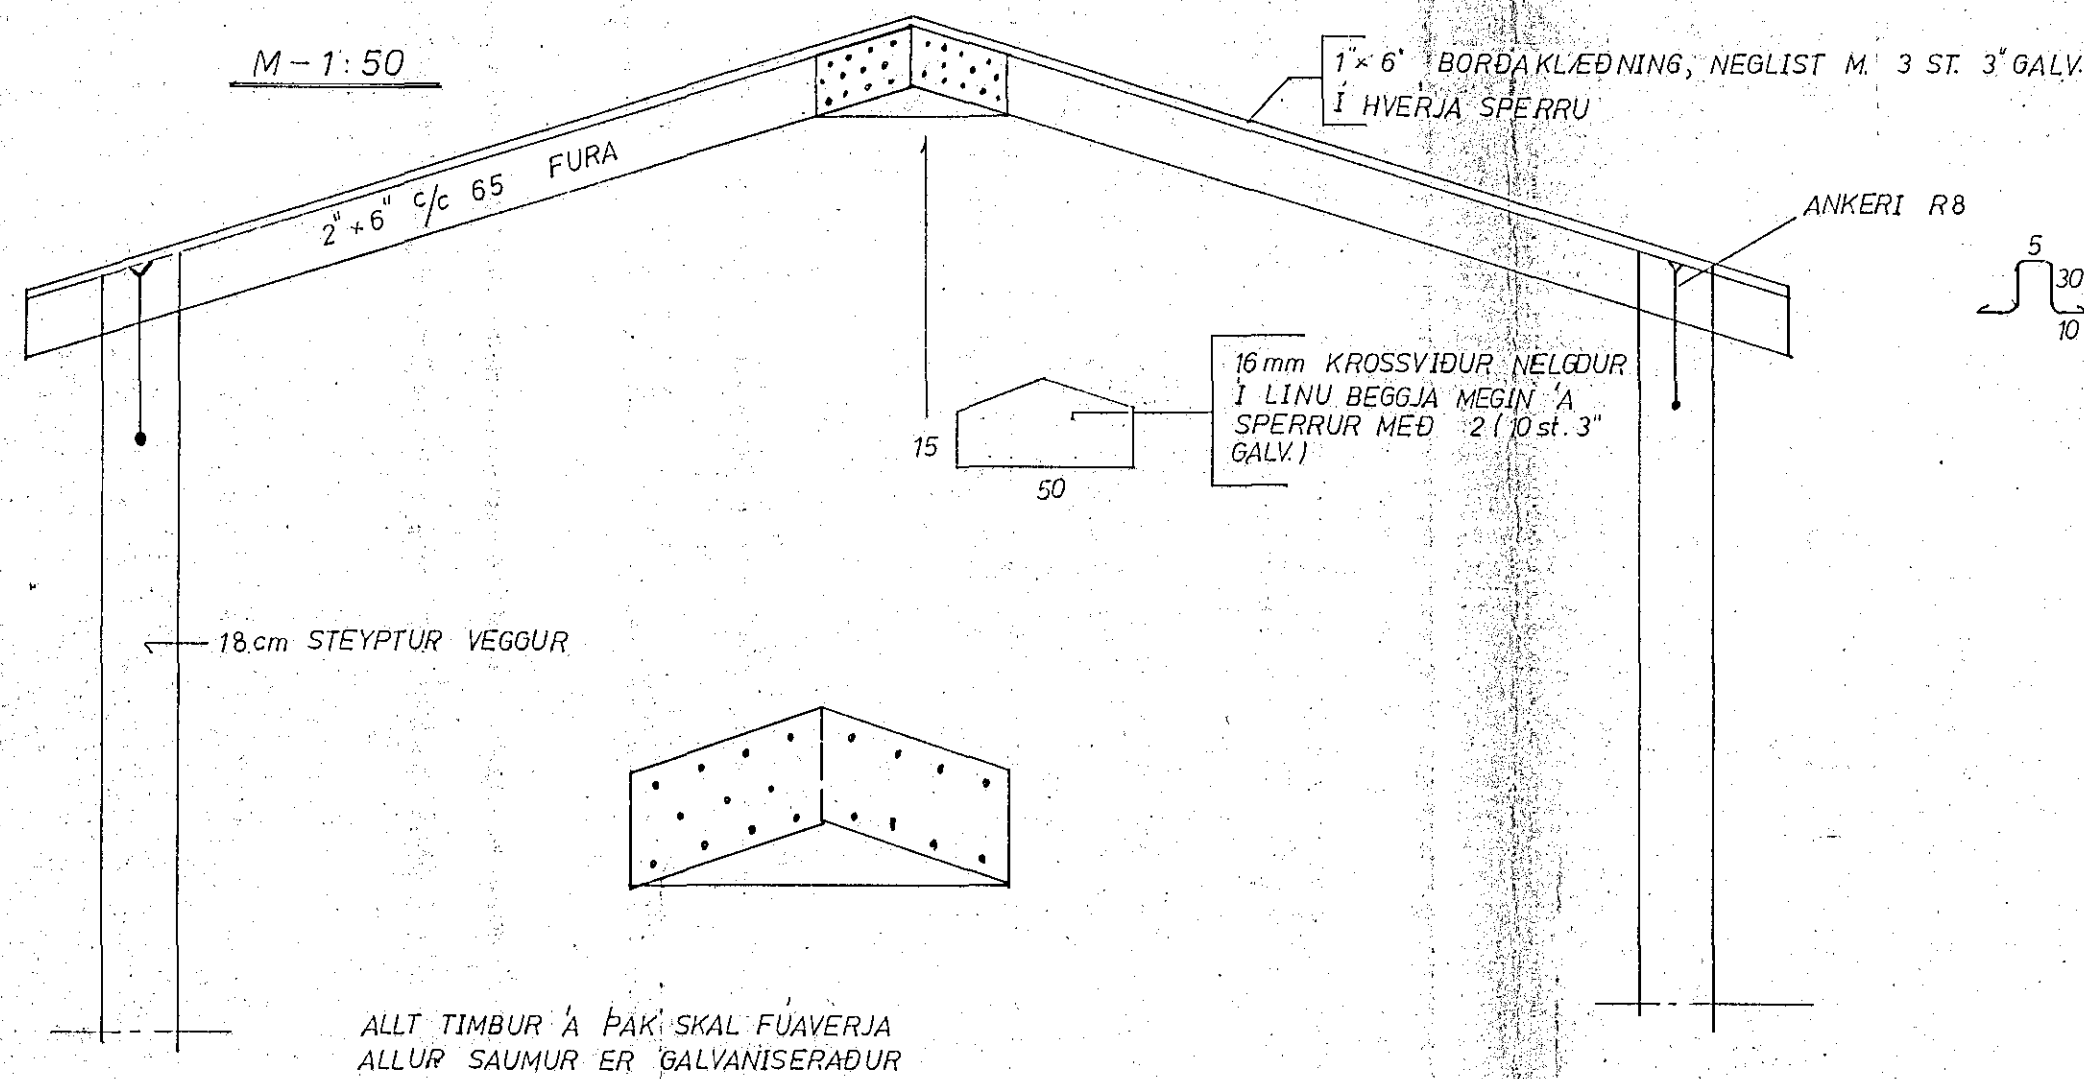

Br.	Dags.	Breyting varðar.
Verkfræðipjónusta Guðmundar Óskarssonar Ráðgefandi verkfræðingar Skipholt 19 Reykjavík Sími 15945		
HRAUNTUNGA 24 HAFNAF BÍLSKÚR - JÄRNUN OFL.		
Reykjavík: FEBR. 82.		
Teikn: G I.	Kvarð: 1:50 1:10	
Reikn: G I.	Verk nr.:	Bl. nr.
Yfirt:		
Samþ:		