


Sampl. 3/3 99  
 8/11

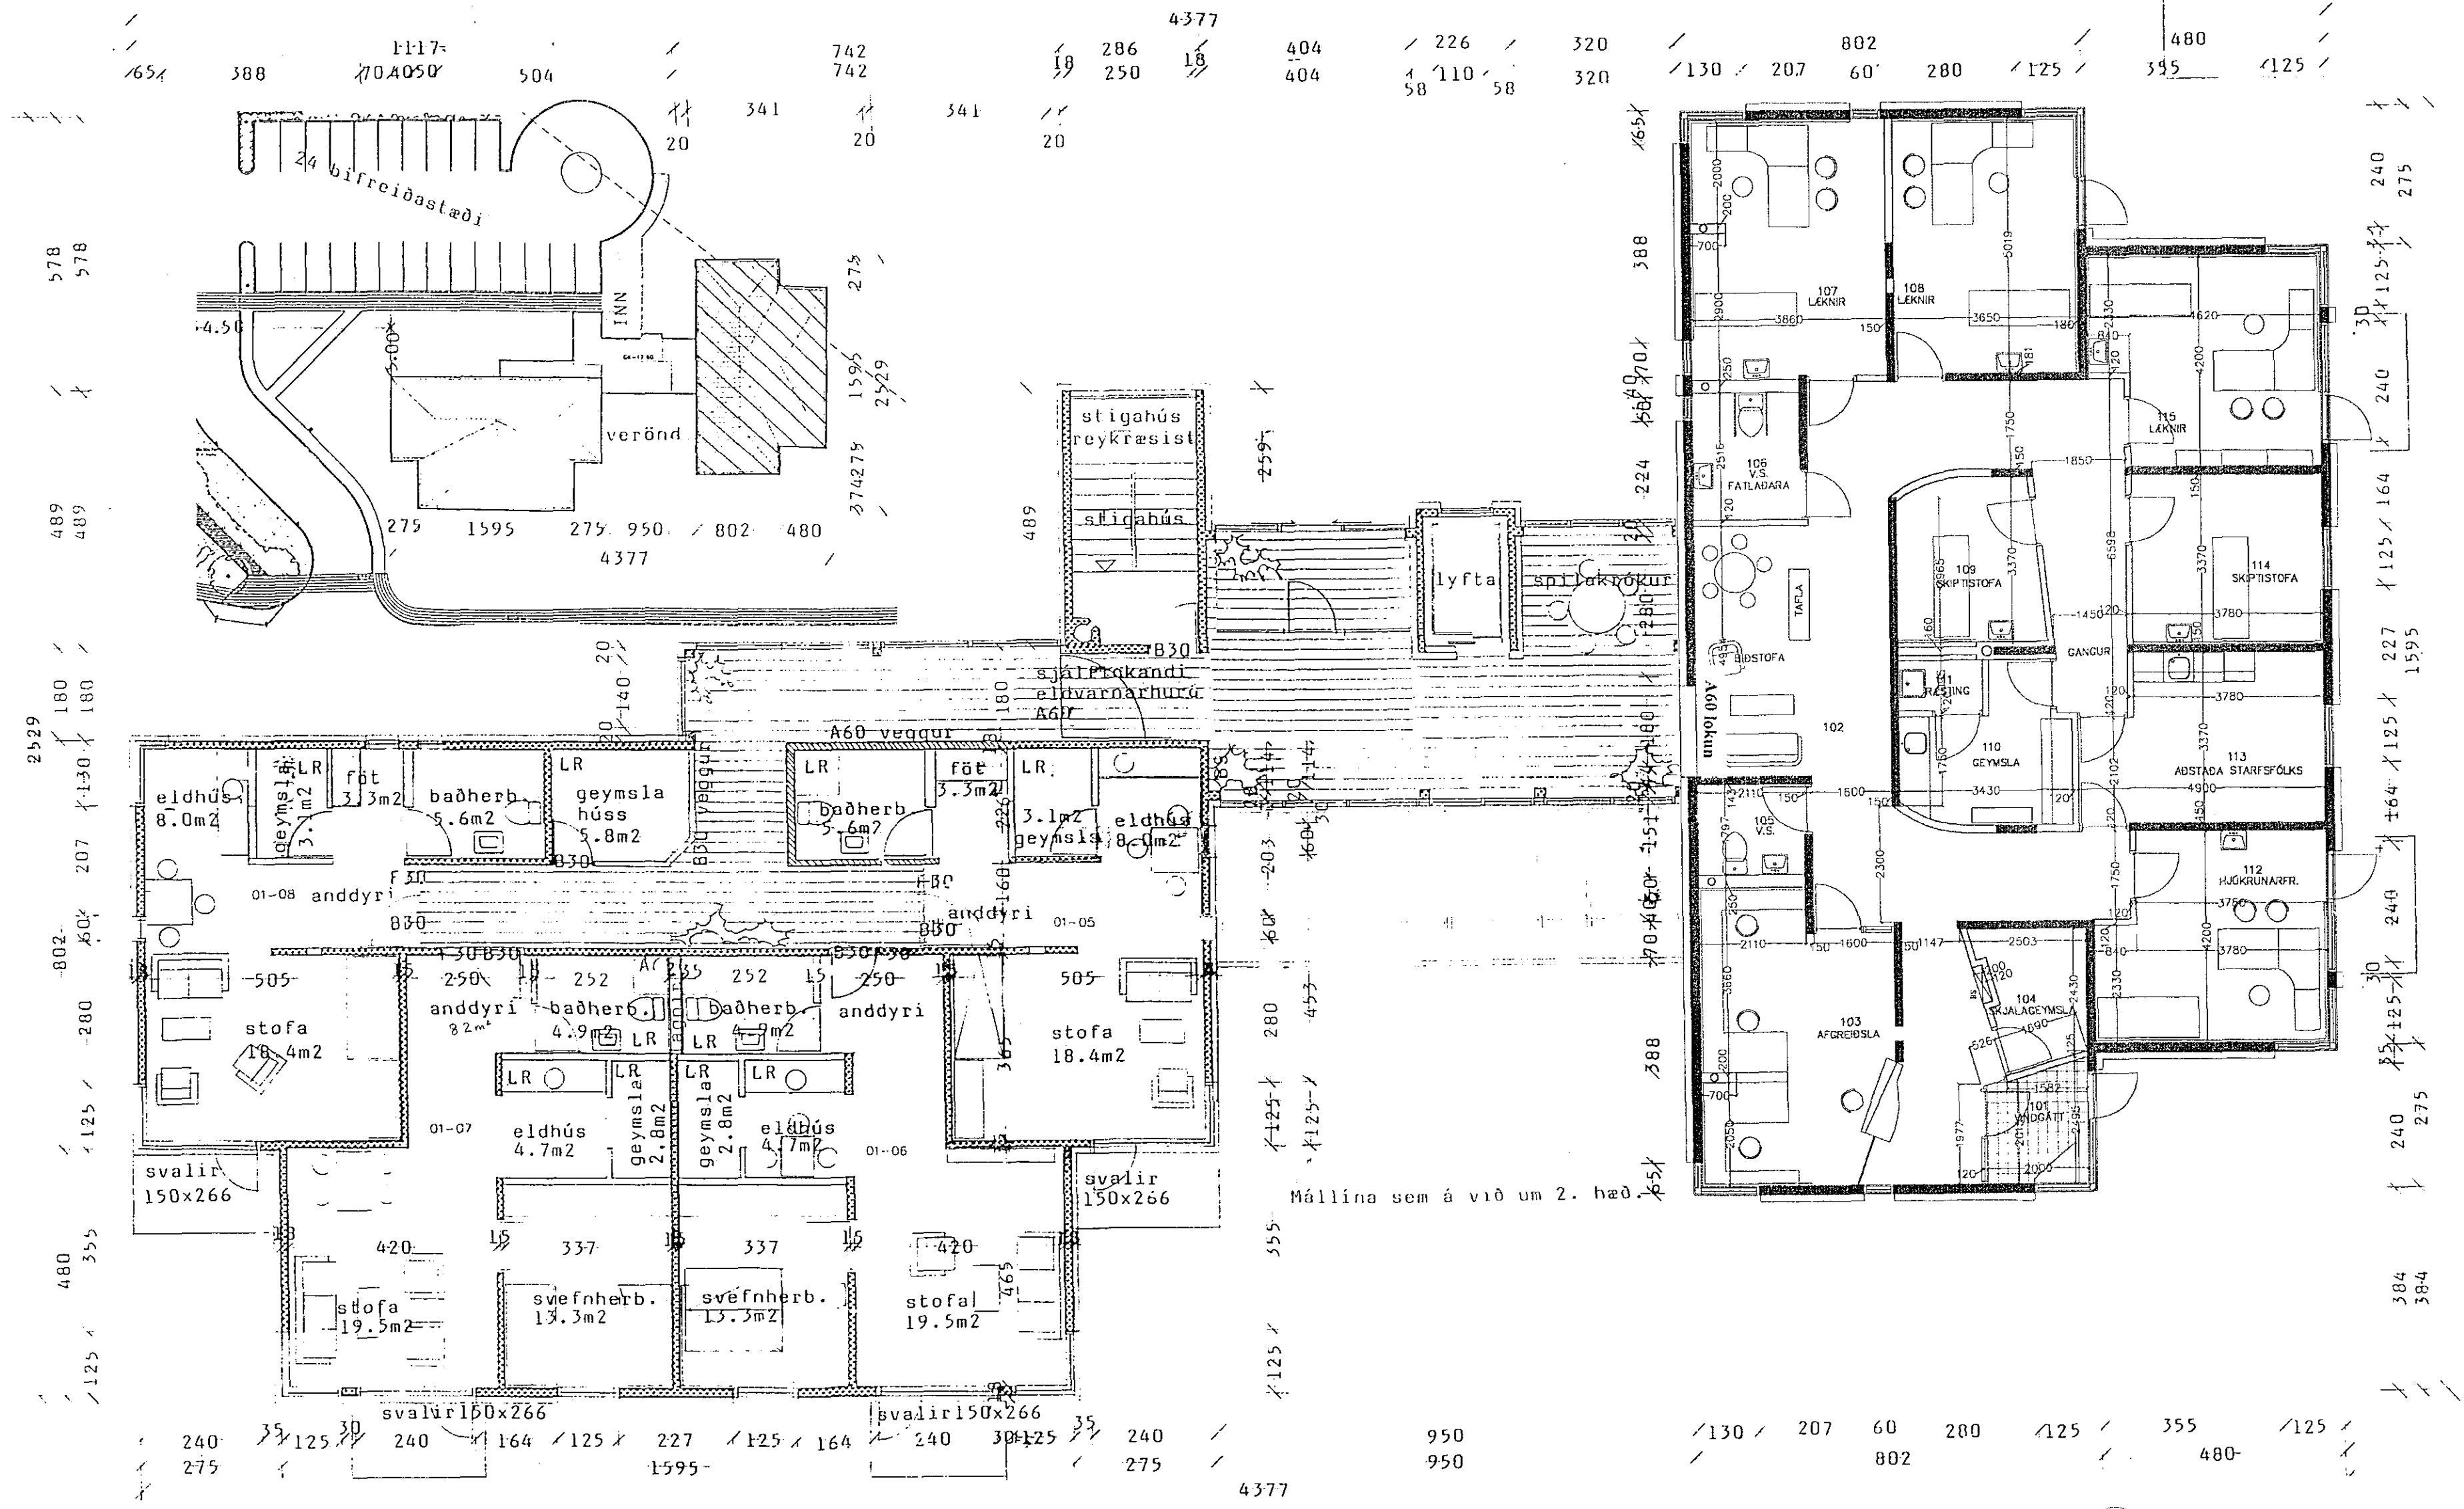

05.10.1998 Breytt A60 lokun milli heilsugæslu og íbúða

MEYFILL: \_\_\_\_\_ DAGS: \_\_\_\_\_ LFSANG: \_\_\_\_\_

\_\_\_\_\_

\_\_\_\_\_

\_\_\_\_\_

**SÓLVANGSVEGUR 3**

SUDURENDA JARÐHÉÐAR BREYTT

Í HEILSUGÆSLUSTÖÐ

MELKY: 1-100 DAGS: 03.06.1998 1.01

ARKITEKTASTOFA  
 FINNS BJÖRNSSONAR OG  
 HILMARI PÓSS BJÖRNSSONAR  
 BERGSTADAHYLLI 10  
 101 REYKJAVÍK  
 Sími 661 1480  
 FAX 662 4600