





SNID D-D M 1:20

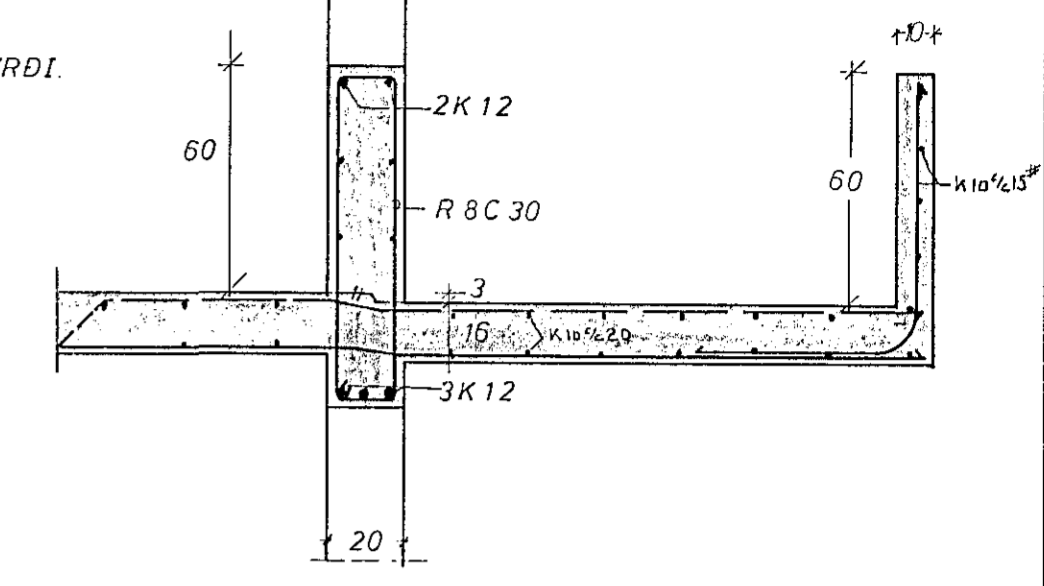

SNID E-E M 1:20

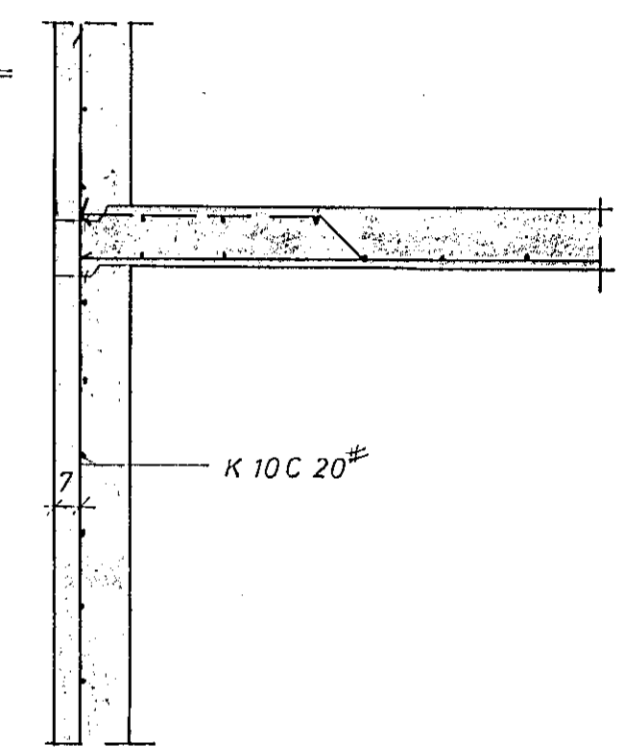

SNID C-C M 1:20

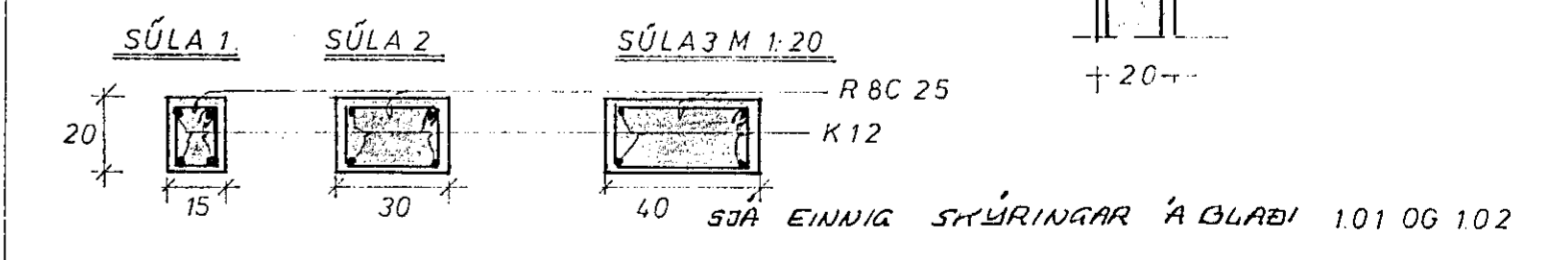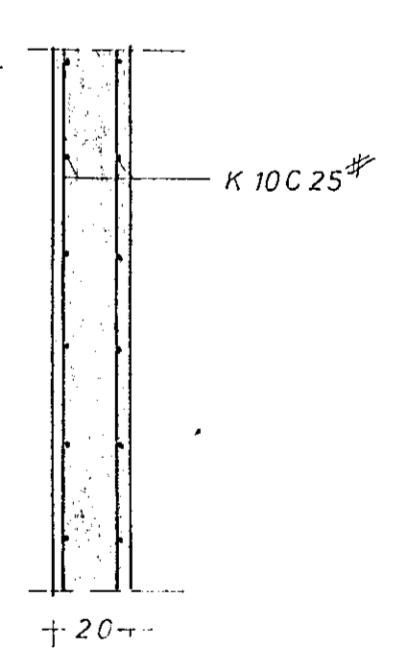

22. júlí 1984  
 HAFNARFJÁREYKJER  
 BYGGINGAFULLTRUINN FM  
*Óskóla Þorsteinsson*

VERKTAKA OG TÆKNIÞJÓNUSTA	
GUNNARS INDRIDASONAR LAUGAV. 1B 5. 1B520	
HVASSABERG 4 HAFNARF.	DAGS. SEPT '83
GRUNNMUND SÖKKLA EFRI HÆÐAR OG JÄRN Í MILLI-LOFT YFIR KJALLARA	MKV. 1:50
	TEIKN. '05ÁS
	REIKN. '05ÁS
SAMÞYKKUR: <i>Jónna Indridason</i>	18-103

15/7'84 Kjallara brytt GZ