


STYPA:	
S > 250	
VS ≤ 0.5	
LOFT ≥ 6%	
SEMENT ≥ 300 KG/M ³	

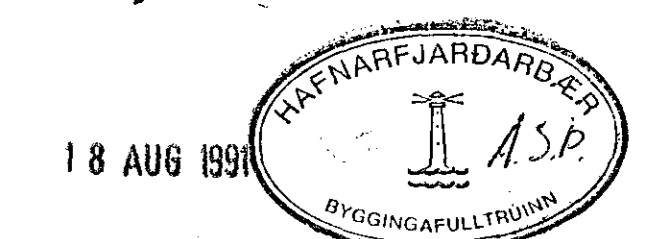

18 AUG 1991

SKÝRNINGAR

ALMENNAR SKÝRNINGAR SÁ BL. NR. 1-01.

02	AGÚST '91	ÞÆTT VÍÐ PLÖTU YFIR SVÖLLUM	SK
01	MARS '91	VEGJÁ DE. Á SKIPLAGI TRUBA	GL
BR. NR.	DAGS	EDLI BREVTINGAR	SIGN.
HÖRCHOLT 27-29 HAFNARFIRÐI			DAGS DES '90
BENDING VEGGJA 4 HÆÐAR			HANNA
BENDING PLÖTU YFIR 4 HÆÐ			TEIKNAR
MELIKV. A 1:50			VERK NR.
SIGURÐUR ÞORLEIFSSON TEIKNIFRÉBINGUR F.T.			9051
STRANDGÖTU 11 HAFNARFIRÐI SÍMI 54751/54755			BLAD NR.
			1-07