


*Mh. brunnmätistöki  
Skr. bréf Brunnm.kest.  
4/3 81.*

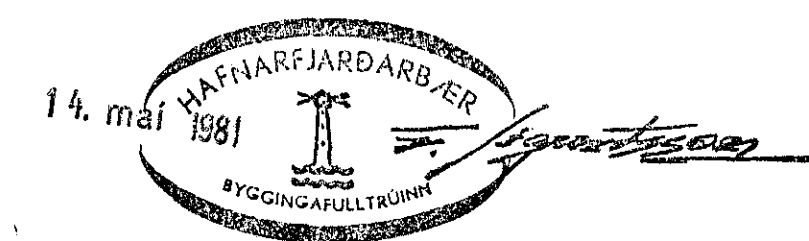

ÖLL MÁL M.M.

<b>GÍSLI H. GUÐLAUGSSON</b>			
TÆKNIFRÆÐINGUR SÍMI 42970			
VERK NR	94	EFTIRSLNR	TEIKN NR 100094-1
DAGS	30. 81	HAFN	VERKKAUPI RÁSVÆRK
REIKN	30. 81	TEIKN	VERKEFNI
ATH			KAPLANARUNN 17
SKY	1:100	HEITI	SPERRUR