




GRUNNMYND ~ 1:50

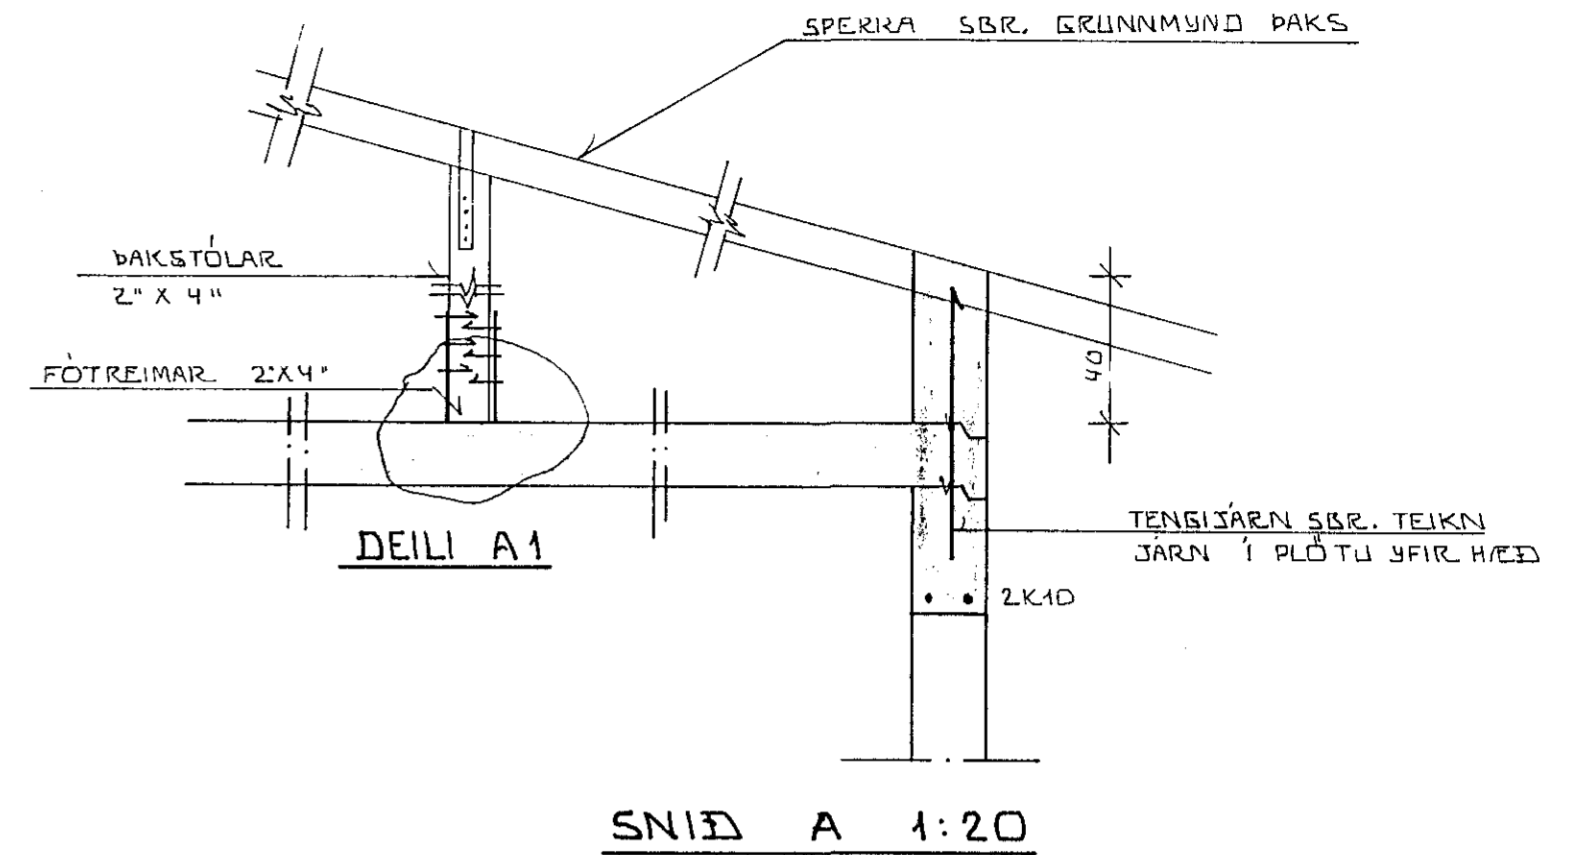


SNID A 1:20

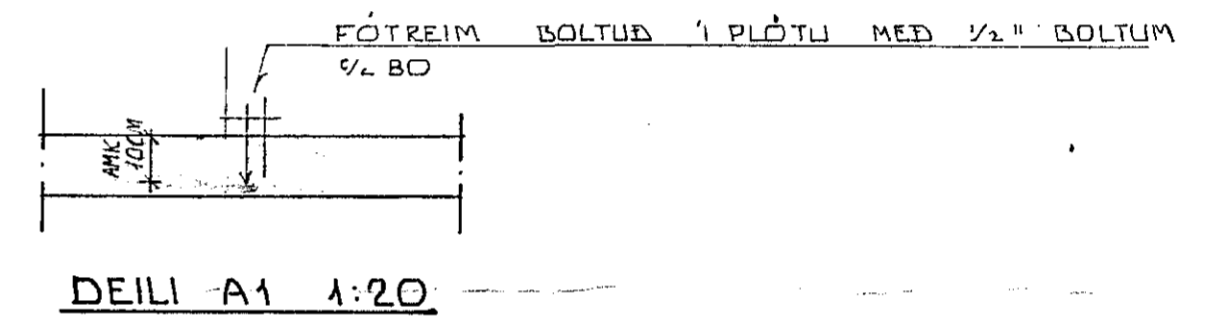

DEILI A1 1:20

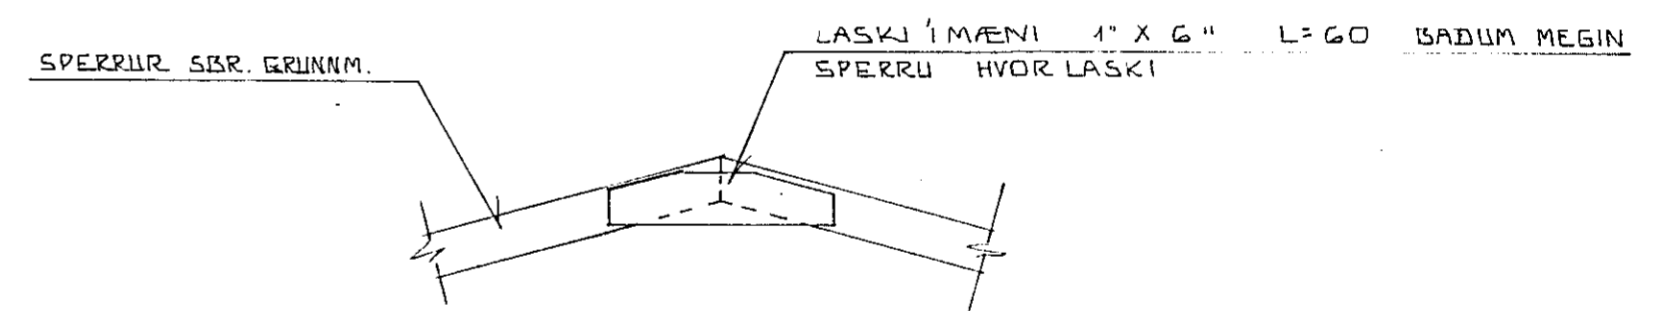

SNID B 1:20

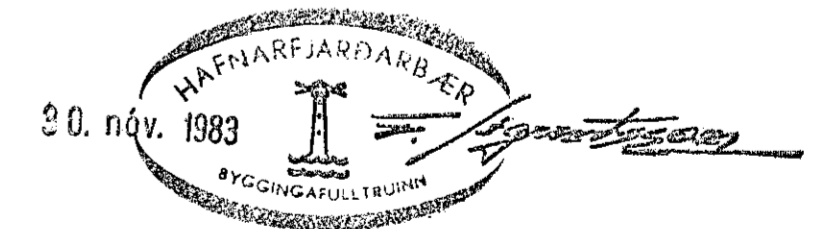

DR. NR.	DAGS	EDLI BREVTINGAR	SIGN.
KJELDUHVAMMUR 13 HAFNARFIRÐI.			DAGS. 03.01.83
PAKYRKI.			HANNAÐ
MÆLIKV. ~ 1:50			TEIKNAD
SIGURÐUR ÞORLEIFSSON TEKNIFRÆÐINGUR F.T.F.I.			VERK NR. 8238
STRANDGÖTU 11 HAFNARFIRÐI SÍMI 54751			BLAD NR. 07