



Sámpykkt á fundi bygginga-
nefndar þ. 10/11. 1982
BYGGINGAFULLTRÚNN
Í HAFNARFIRÐI

Áskildur er samþykktur
á milli 10.11.1982

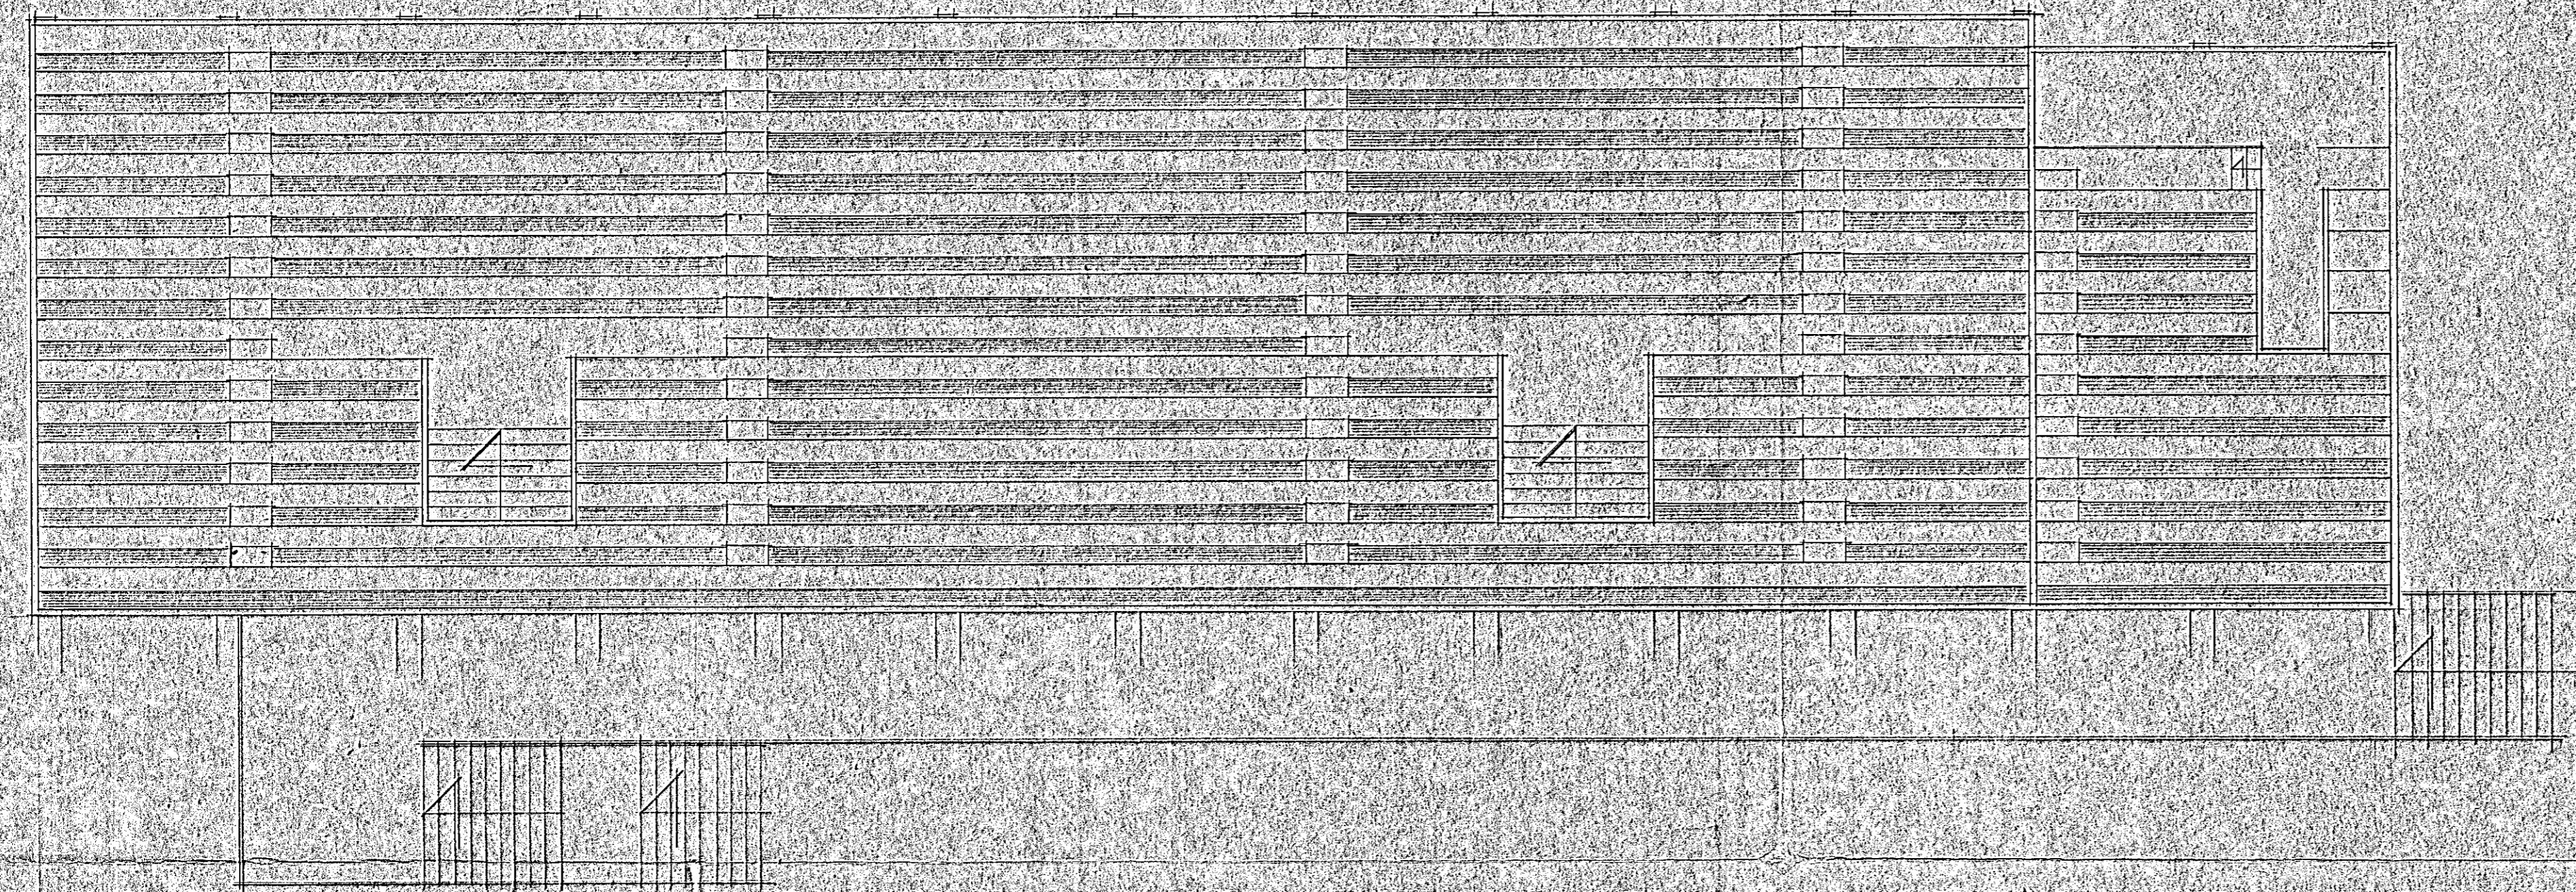

GRÖNNHYNDI AÐR EFTURDÁ PALLAR

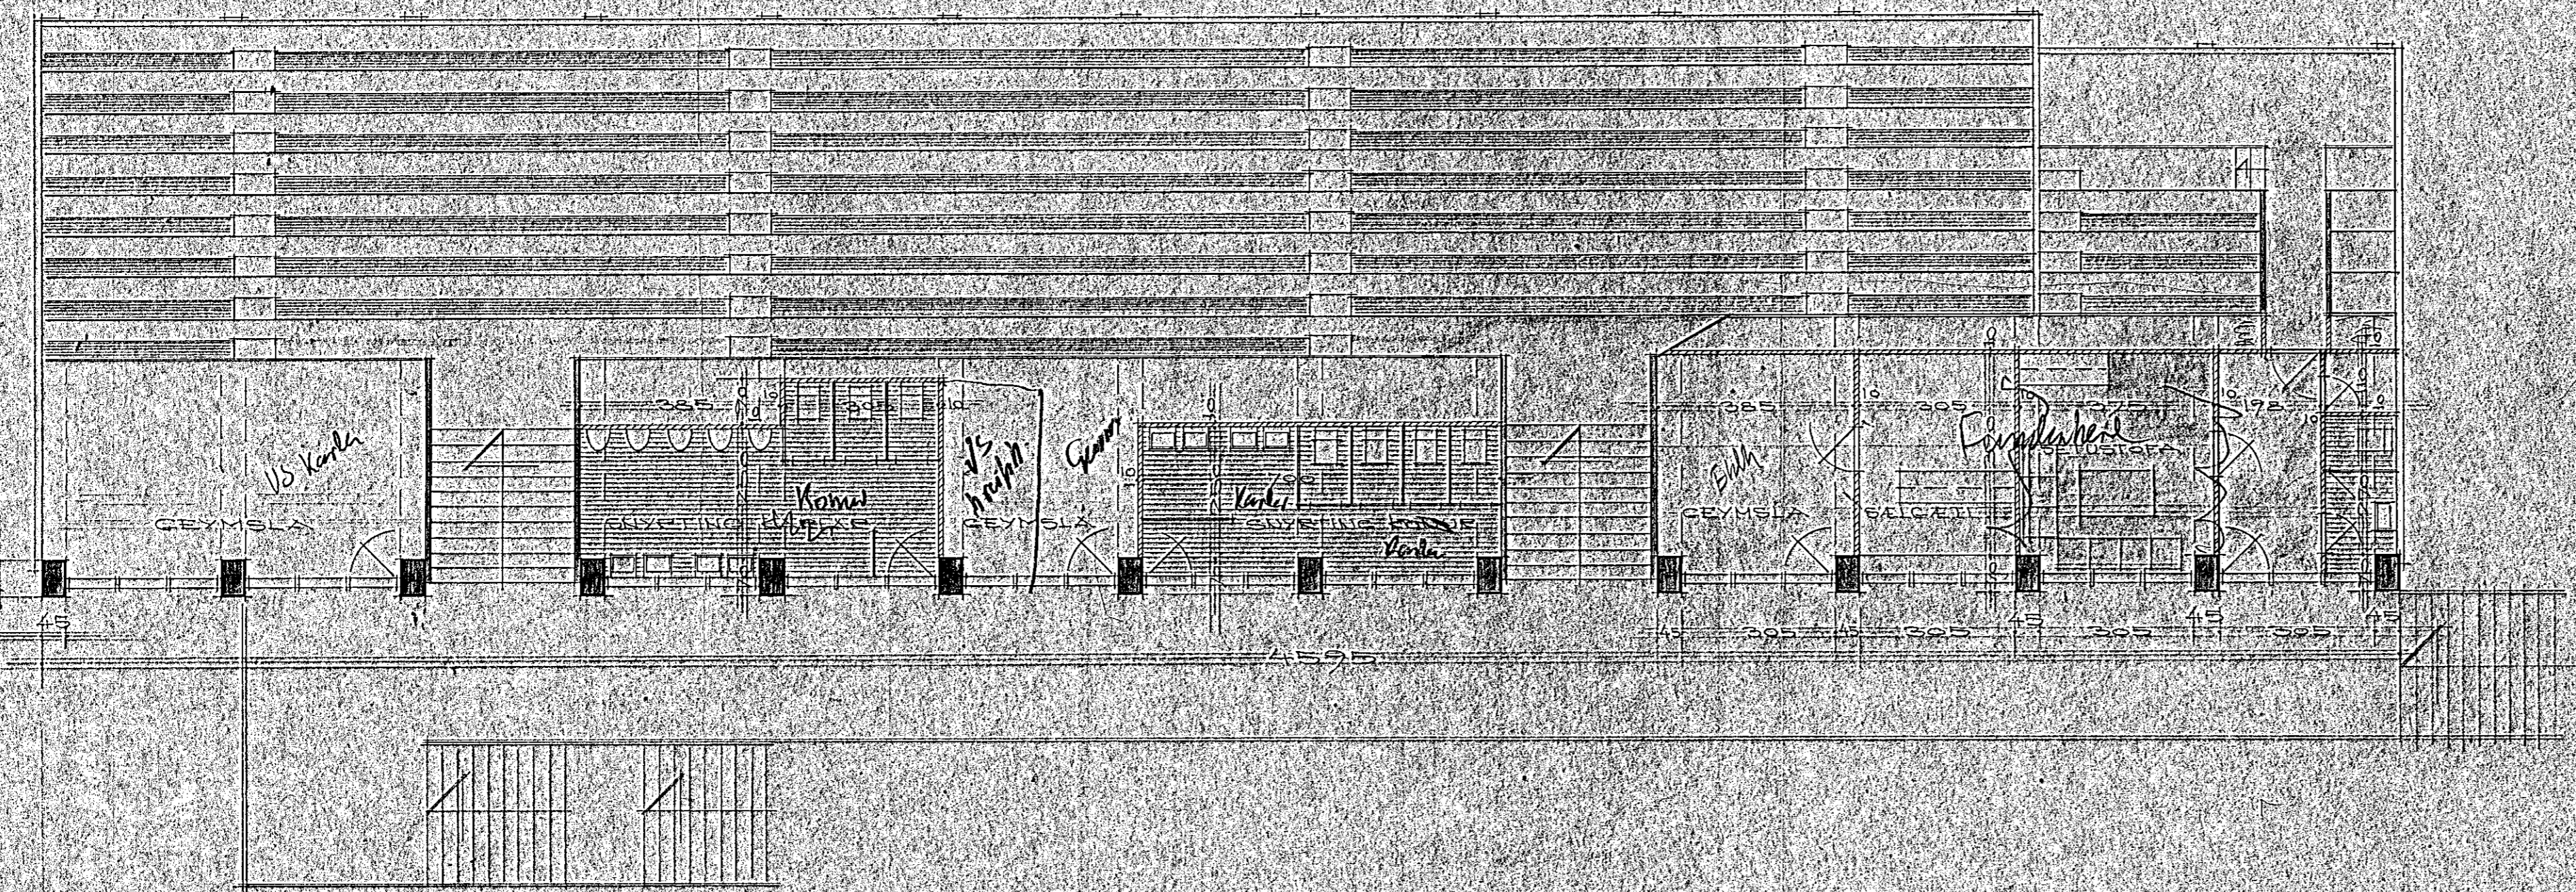

GRÖNNHYNDI EFTIR HEB

4800 1000 03

TEIKNISTOFAN H.F. ARMULA 6 105 REYKJAVÍK
SÍMIL 3 87 80

TEIKNINGARFRAMA
GÍSLI HALDORSSON ARNARFAL
JOBEI REYNSIS ARNARFAL
LEIUEI GÍSLASON ARNARFAL
B. ABNL MARTEINSSON ARNARFAL
HALDOR GUDMUNDSSON ARNARFAL

TEIKNINGARFRAMA
EFTIR HEB GRÖNNHYNDI
PALLAR

A-3

105 REYKJAVÍK
SÍMIL 3 87 80