




SNID A 1:20

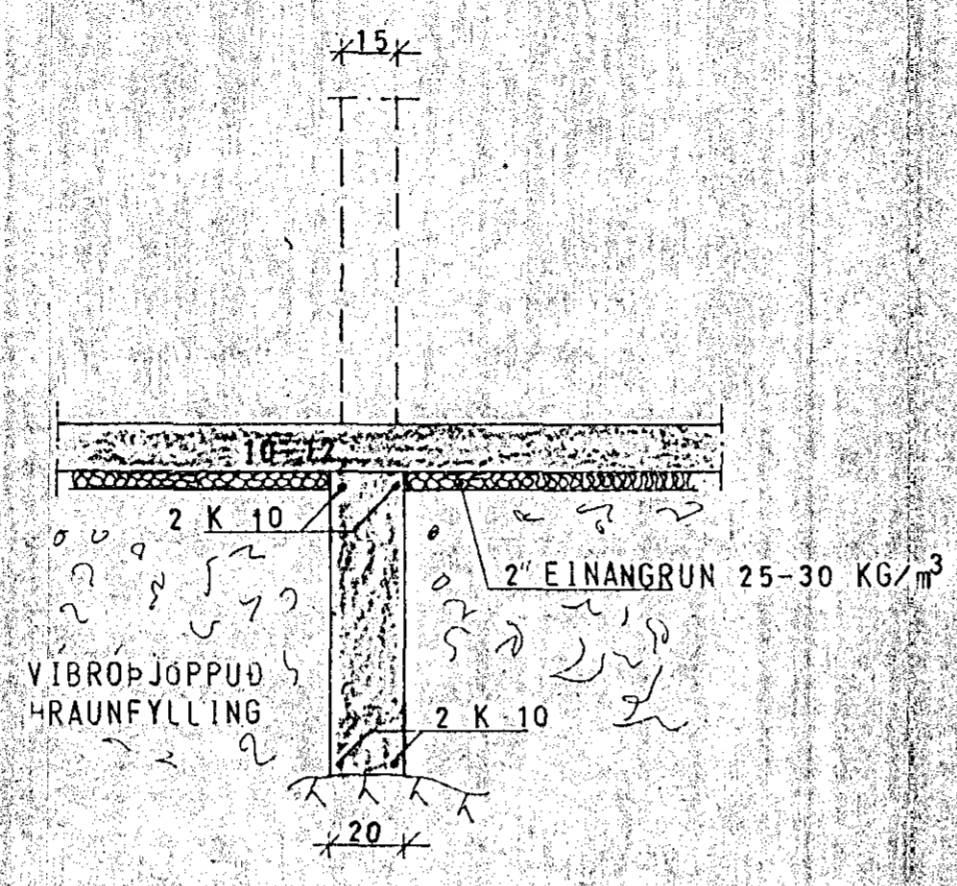

SNID B 1:20

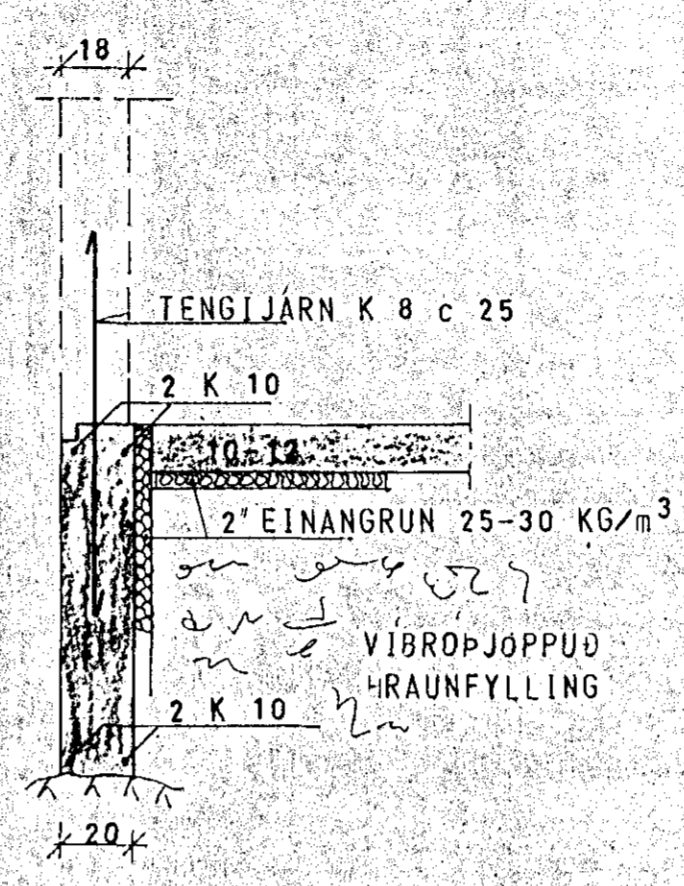


SNID C 1:20

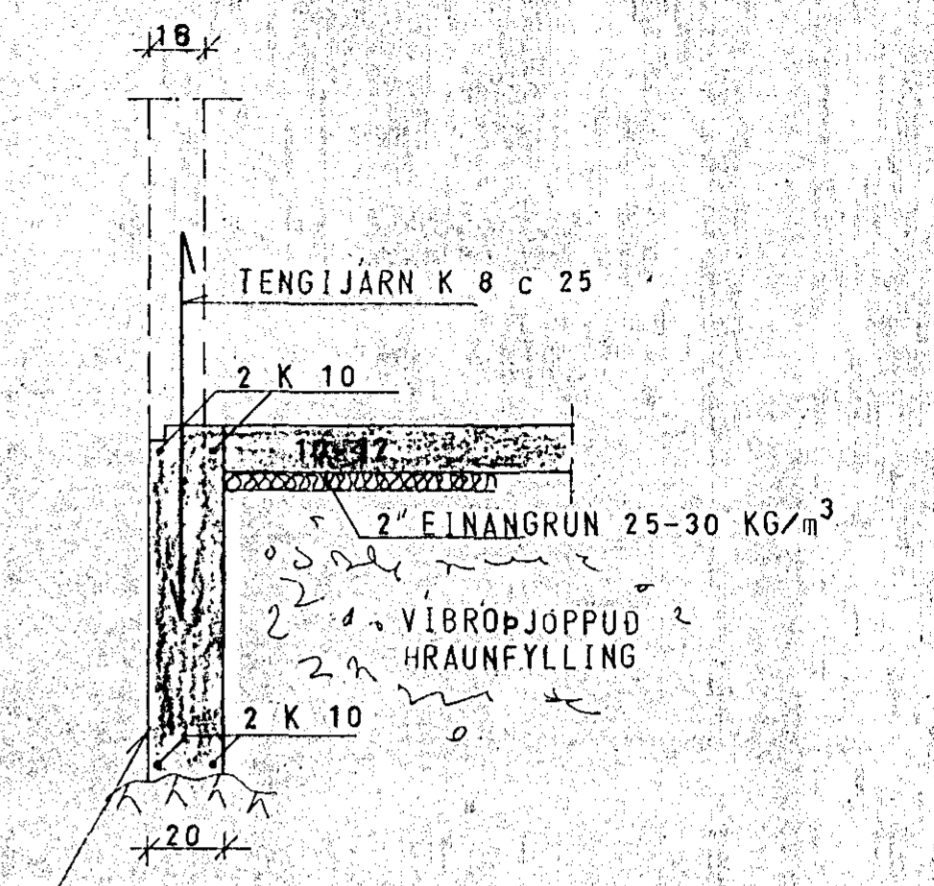


SNID D 1:20

VEGGUR A MILLI HÚSA SKAL VERA VÍR-  
HÖGGVIN, KÚSTADUR OG BIKADUR

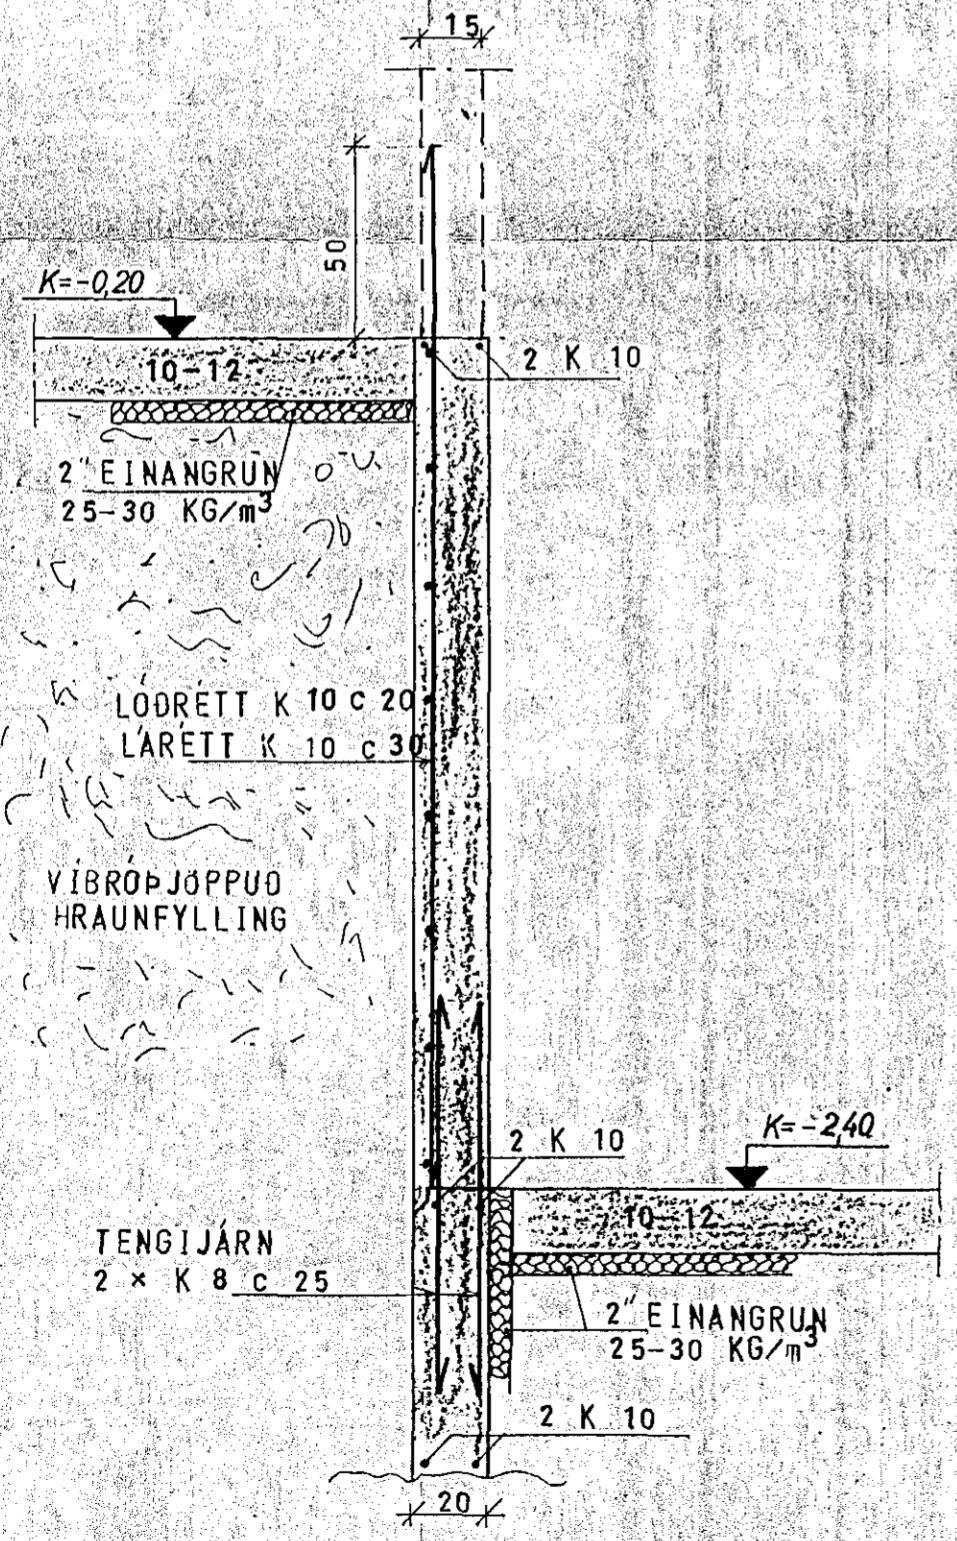

SNID E 1:20

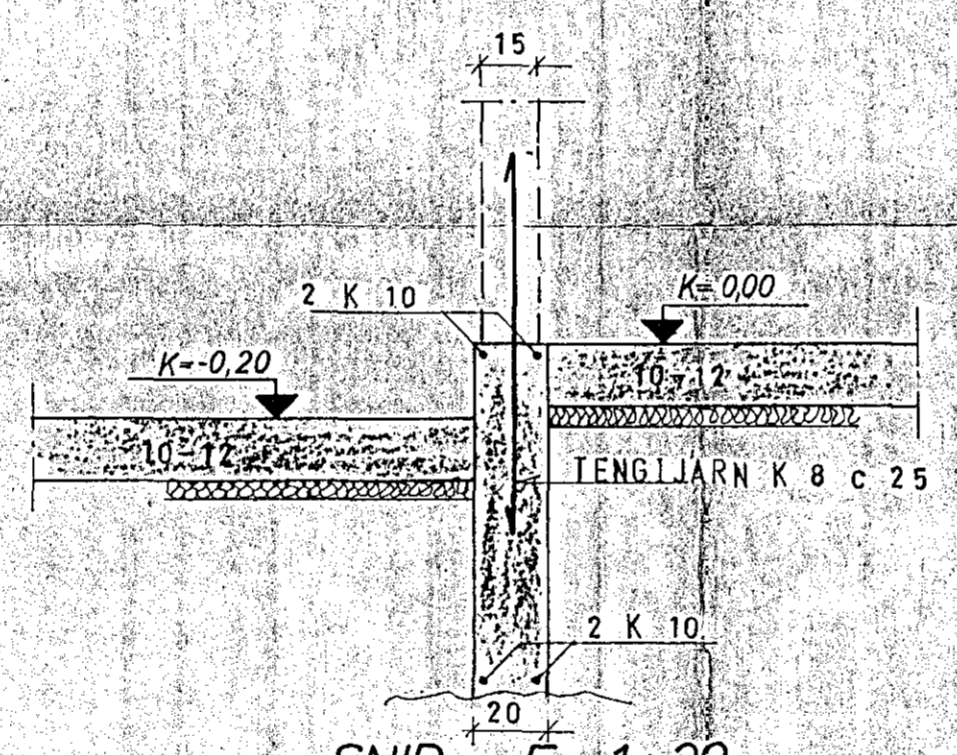

SNID F 1:20



SKÝRINGAR SJÁ TEIKN. NR. 10.

HÚS B

KLAUSTURHVAMMUR 13	MÆLIKVARÐI 1:20	VERK 8001	TEIKN NR. 1.2
SNID 'I' UNDIRSTÖÐUR	Hannað: <i>JK</i> Teiknað: <i>JK</i>	Yfirfari: <i>SK</i> Samp: <i>13</i>	DAGS MAÍ 80
JÓHANN GUNNAR BERGÞÓRSSON VERKFR MVFI STRANDGÓTU 11 — HAFNARFIRÐI — SÍMI 53315	BREYTT		