


SÉRMYNDIR PAKS
SÁ BL.NR. 1-05

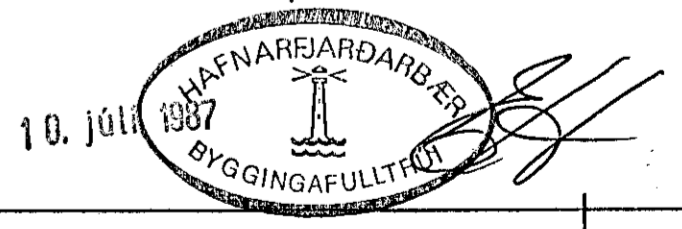

GRUNNMYND 1:50

BR.NR.	DAGS.	EDLI BREVINGAR	SIGN.
01	10. JÚLÍ '87	REYKÁFUR FERJUR	
KVISTABERG 17 HAFNARFIRDI			DAGS. JÚNÍ '87
GRUNNMYND PAKVIKIS.			HANNA
MÆLIKV. 1:50			TEIKNAD.
SIGURÐUR ÞORLEIFSSON TEKNIFRÆÐINGUR F.T.F.I.			VERK NR. 8712
STRANDGÖTU 11 HAFNARFIRDI SÍMI 54751			BLAD NR. 1-04