


E  
5 1  
SNID  
M 1:20

F  
5 1  
SNID  
M 1:20

BREYTING: BENDING PLÖTU YFIR KJALLARA FÆRD INN  
Á TEIKN. I JÚLI 1990

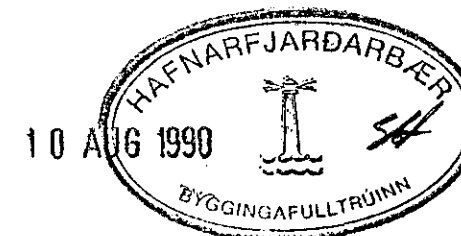

LINDARBERG 8, HAFNARFIRDI

JÄRNBENT STEINSTEYPA  
SNID E OG F

DAGS: MAI 1990 MK. 1:20 BLAD 5

Kristinn Baldursson Ástúni 12 Kóp. FJ.FL. KNT. 100454-0599