





SNID B - B 1:50

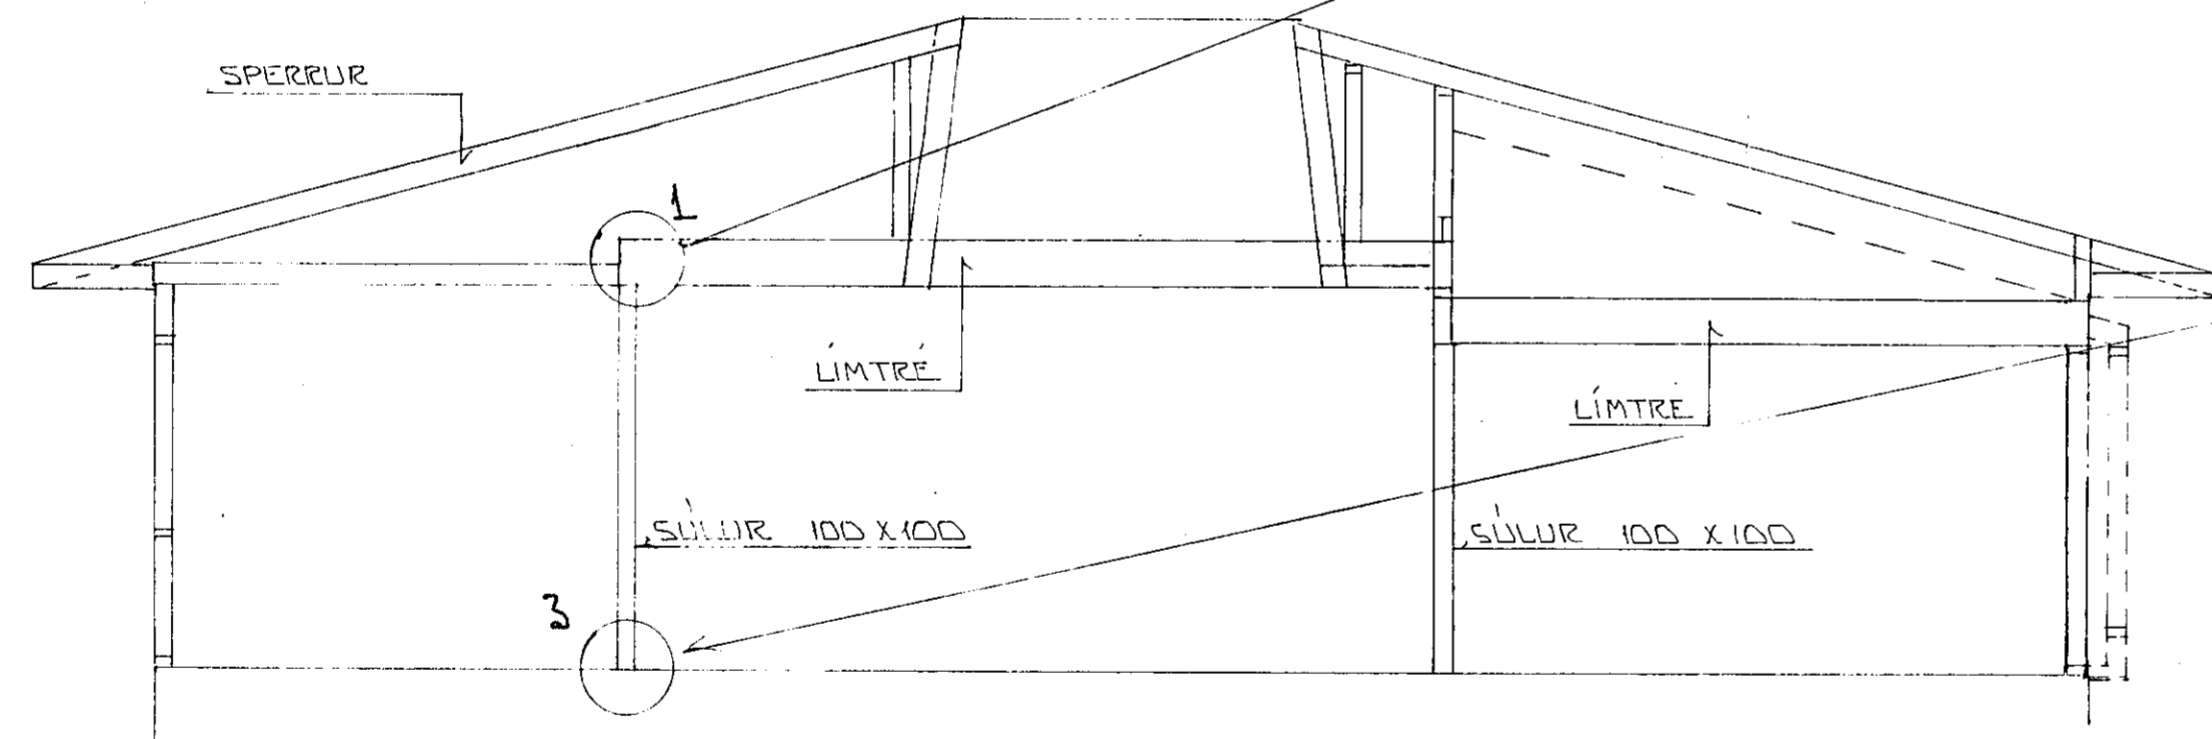

SNID C - C 1:50

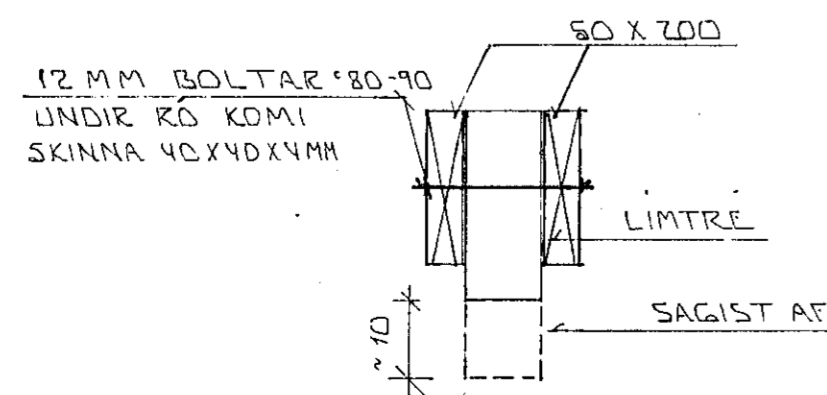

BREYTING Á SÉRMYND 2

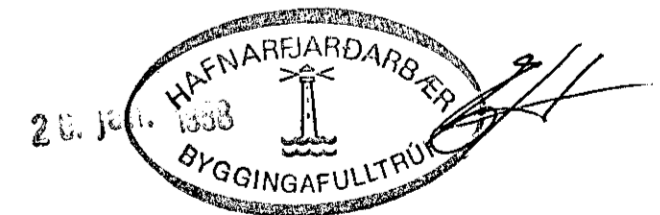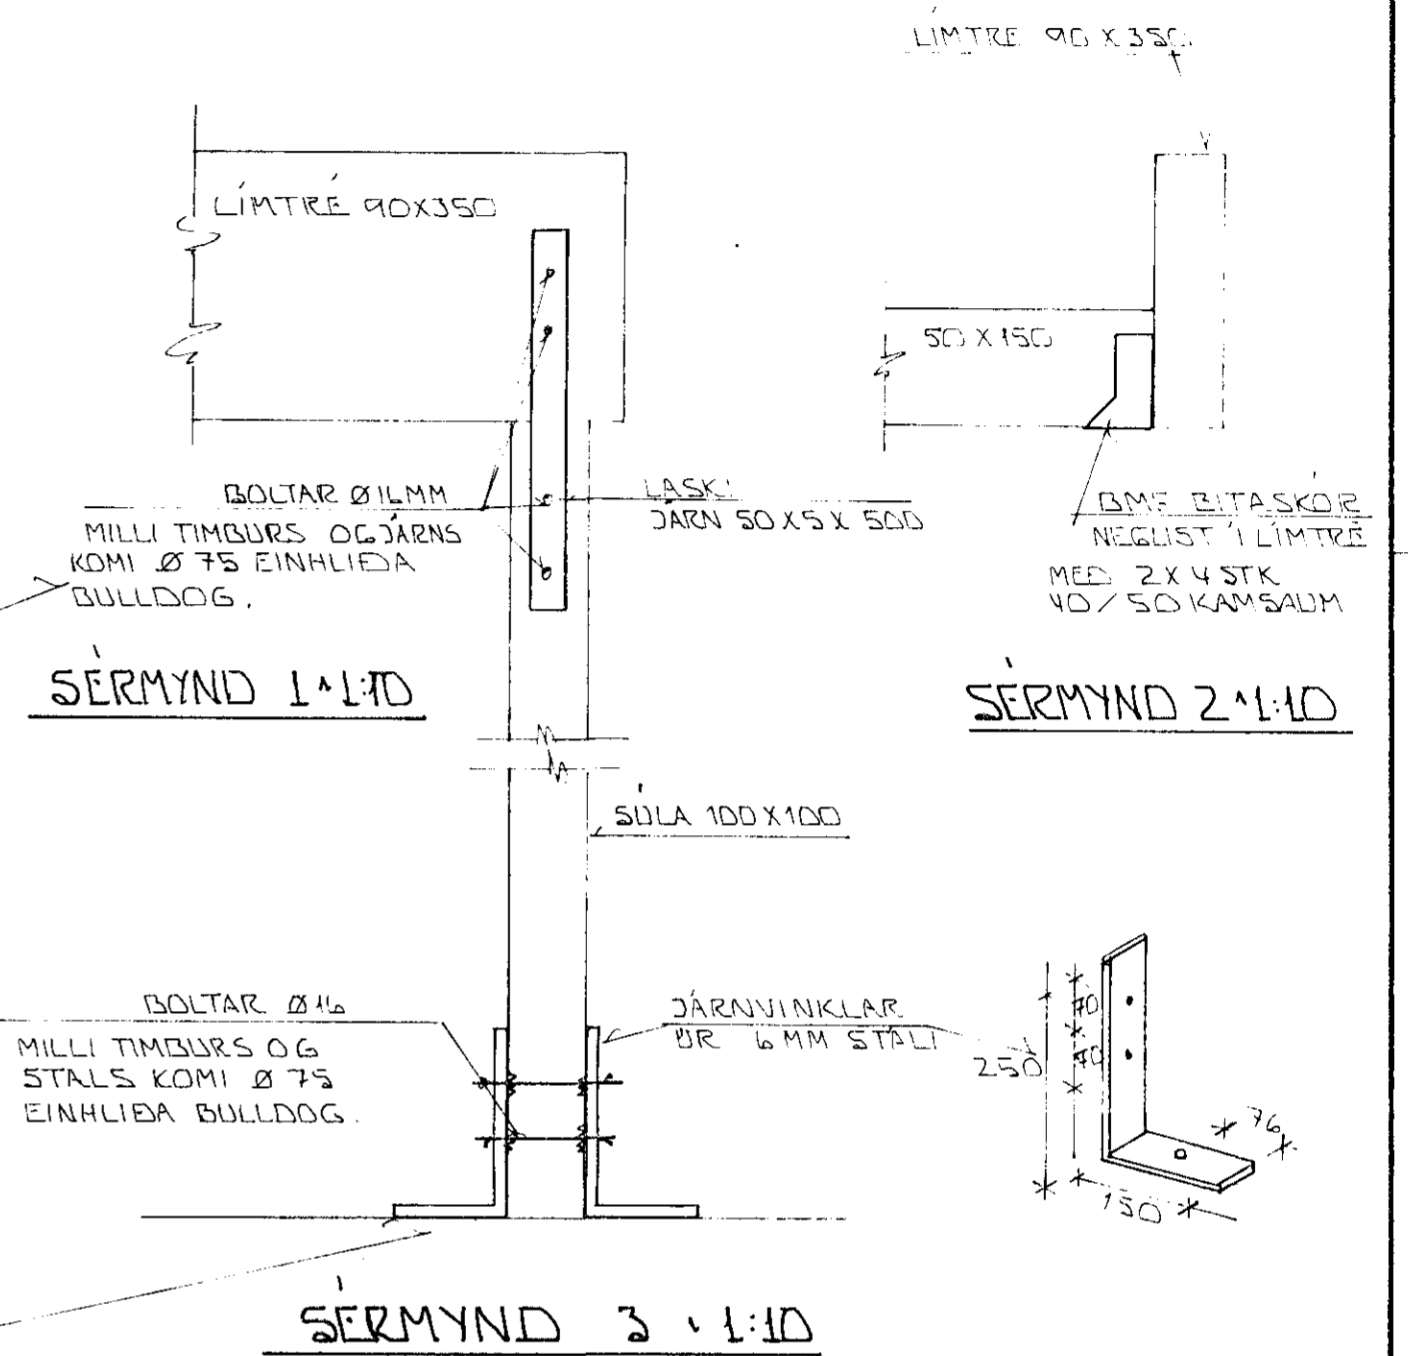

DI	7.1.88	BR. Á SERN. 2	
BR.NR.	DAGS.	EDLI BREVTINGAR	SIGN.
LYNGBERG 17	HAFNARFJÖRÐUR		DAGS MÁ'87
BURÐARVIRKI: SNID			HANNAS
			TEIKNAD
			VERK NR. 8713
MÆLIKV. 1:50			BLAD NR.
SIGURÐUR ÞORLEIFSSON	TEKNIFRÆÐINGUR F.T.F.I.		1-05
STRANDGÖTU 11	HAFNARFJÖRÐUR	SÍMI 54751	