



GRUNNMYND 1:50

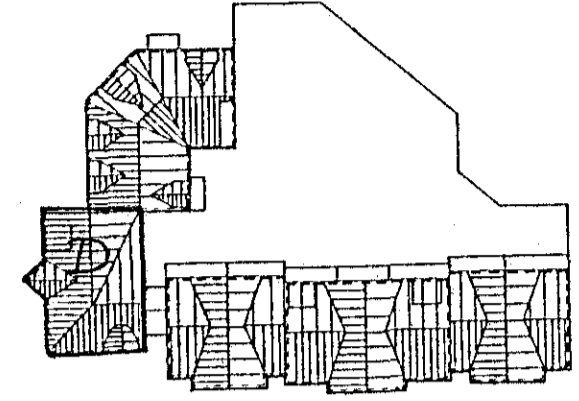


VEGLUR V-1
SJA TEKN. 2.18

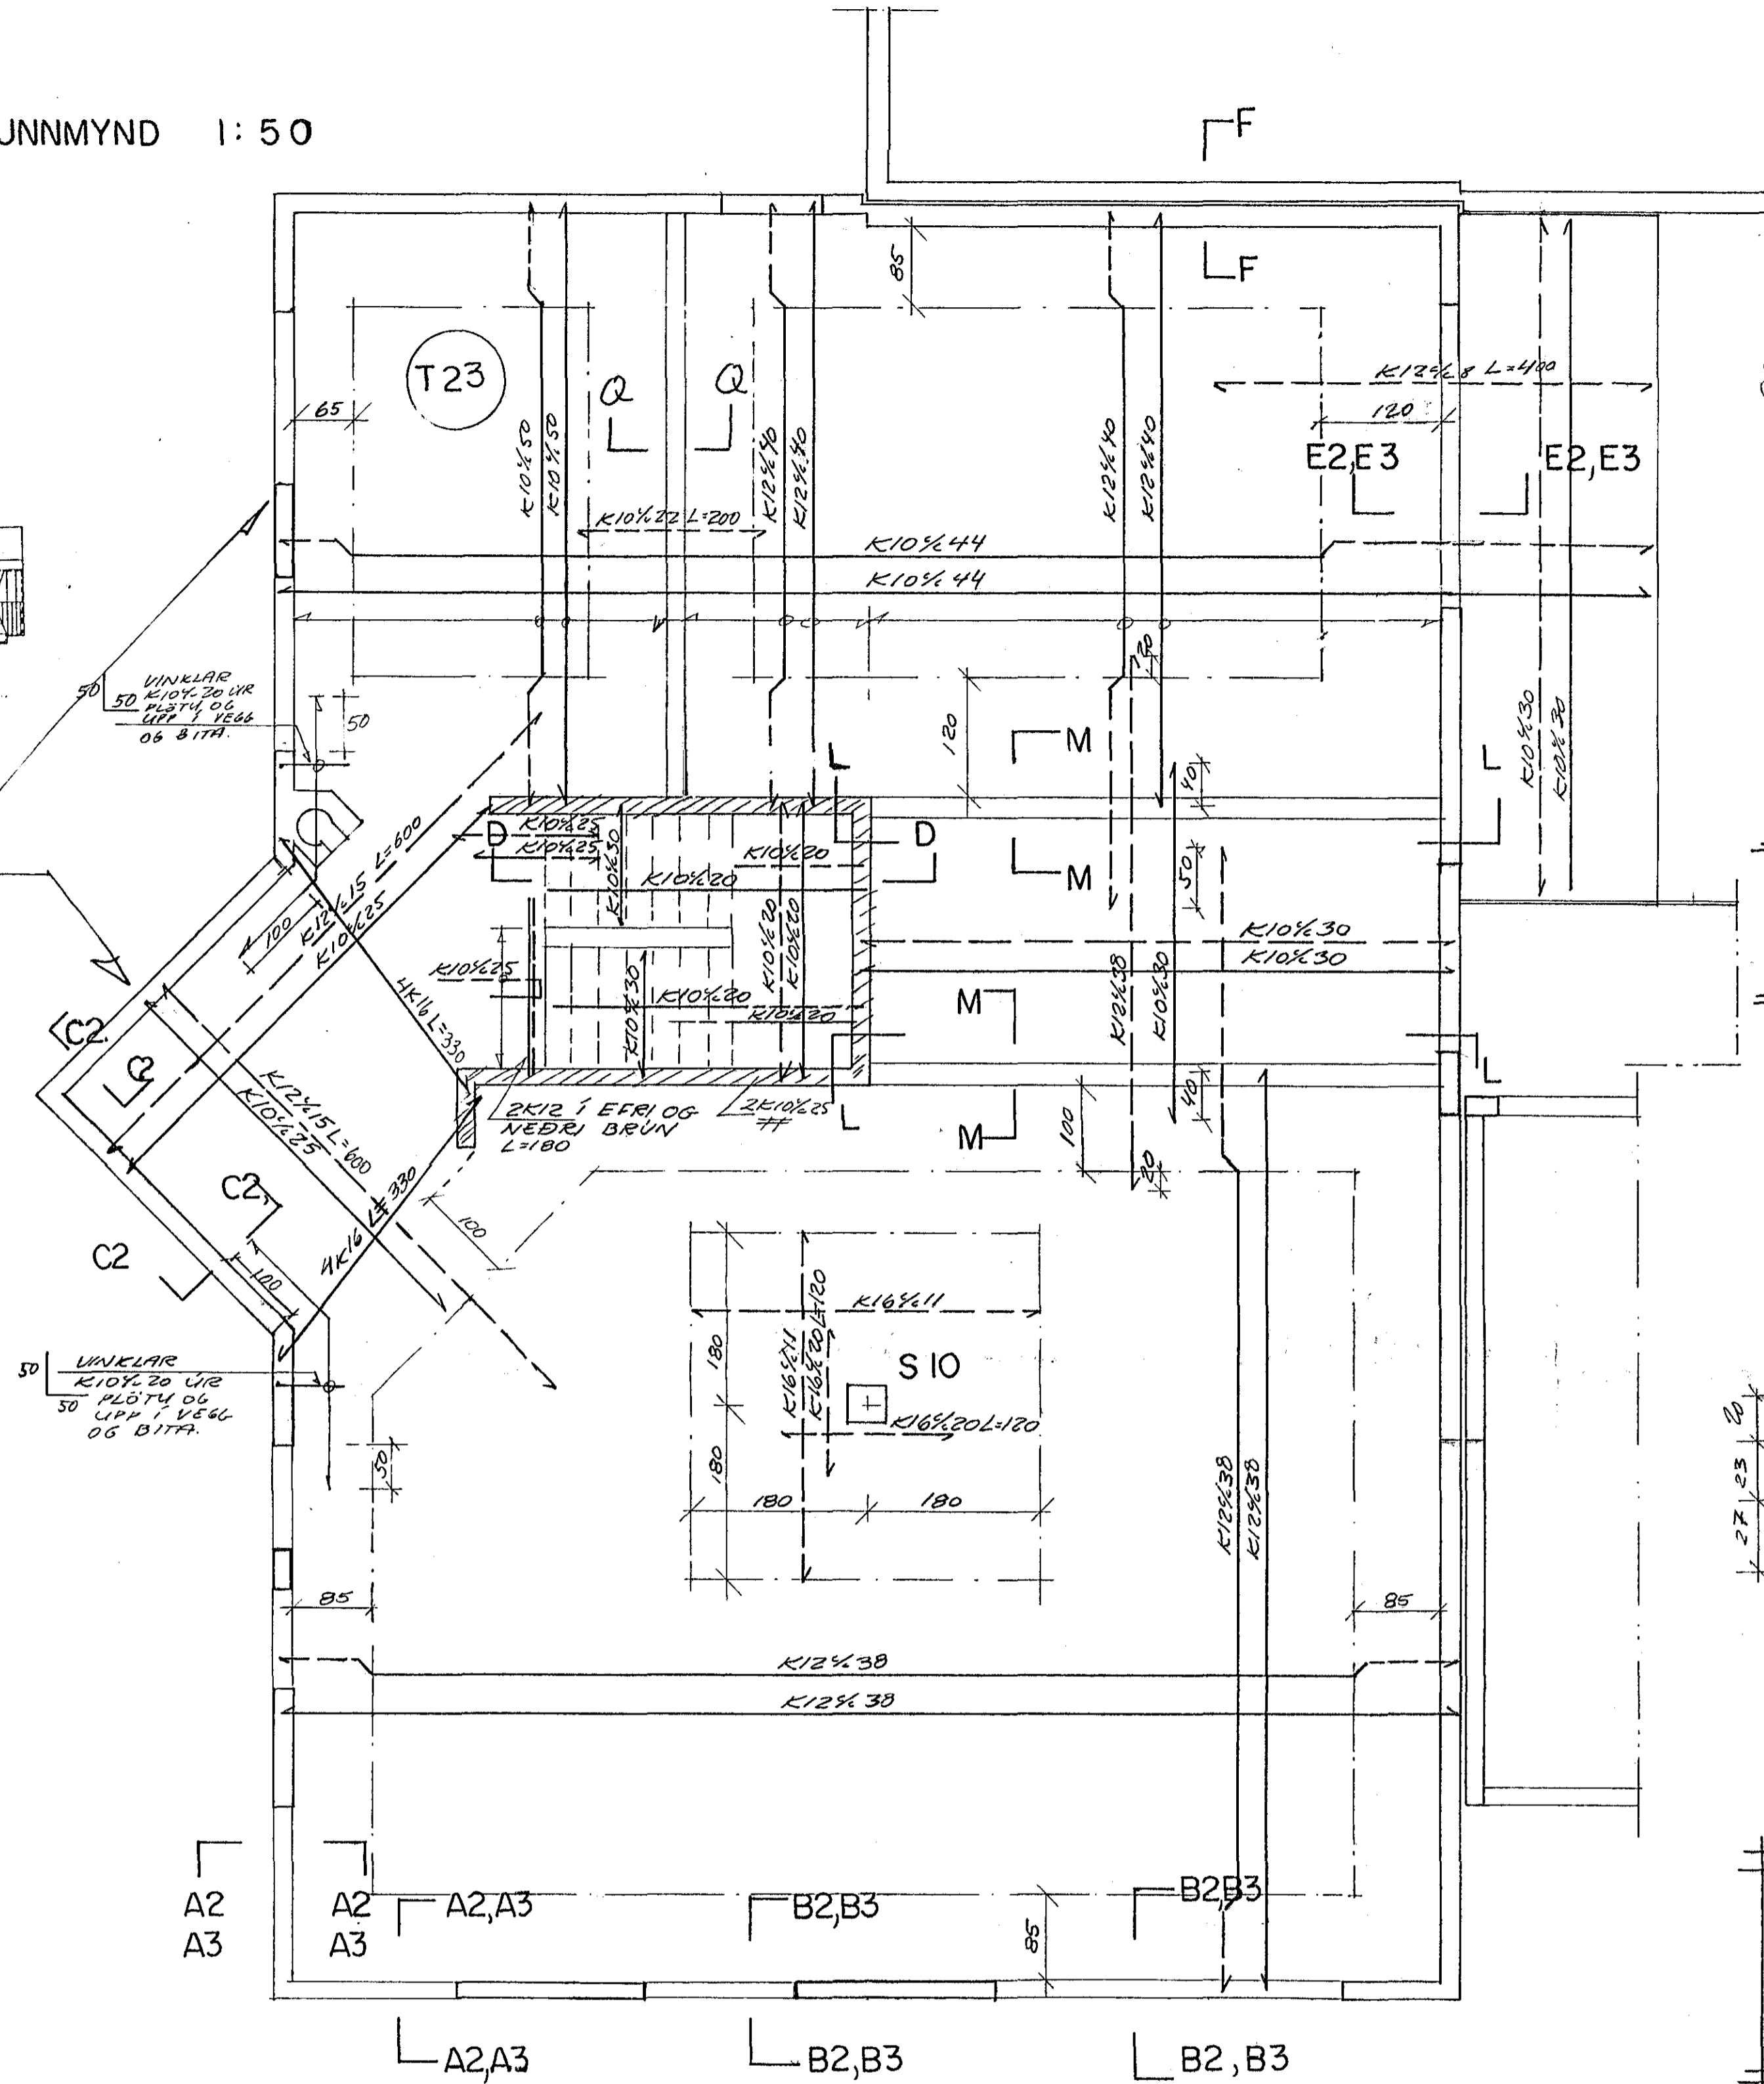

SNID A2-A2 1:20

SNID B2-B2 1:20


SNID C2-C2 1:20

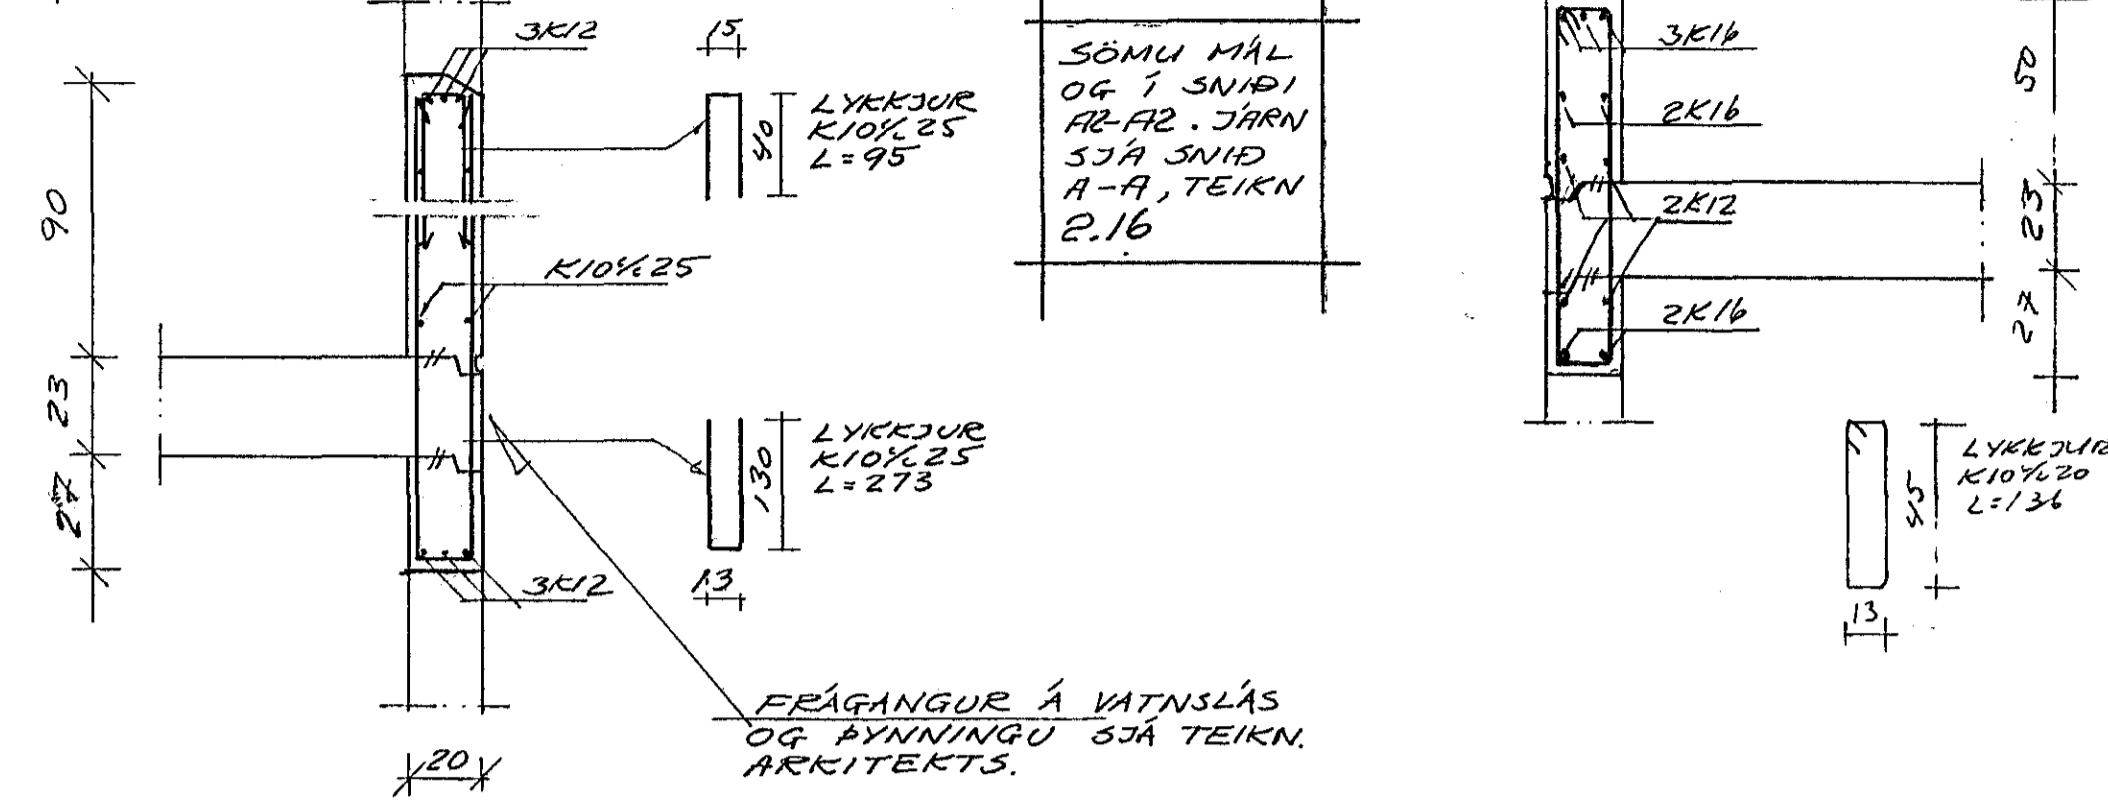

SNID D-D, F-F, L-L OG SNID M-M
SJA TEKN. 2.16


SNID E2-E2 1:20

SNID N2-N2 1:20

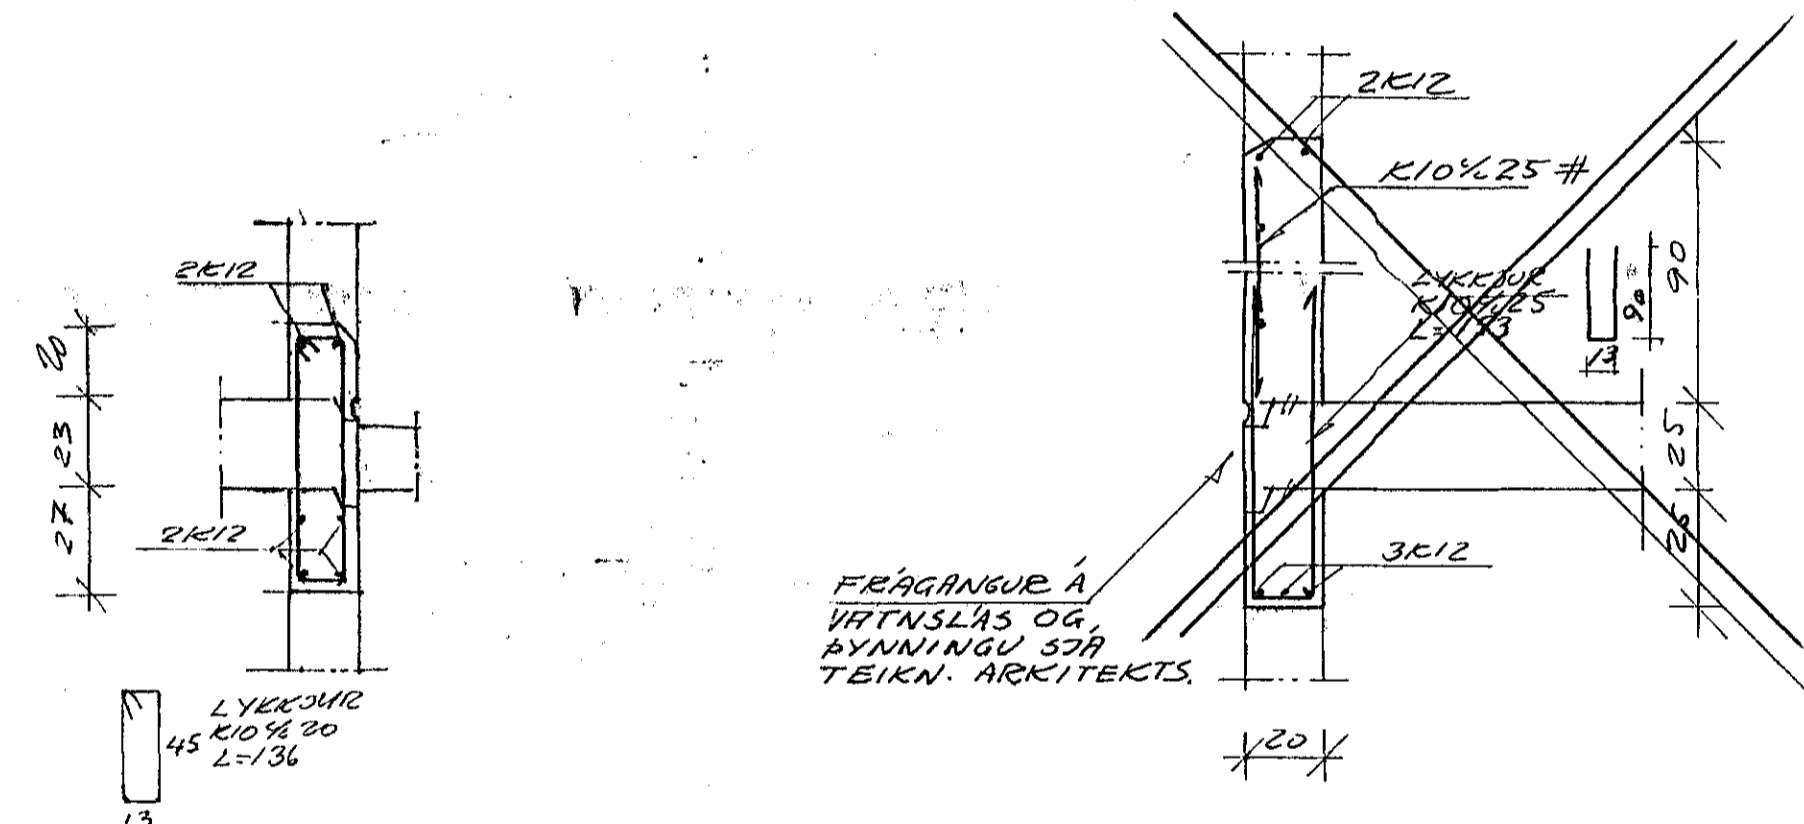


SNID A3-A3, B3-B3,
E3-E3 OG N3-N3
SJA TEKN. NR. 2.20


DEILI A₂ 1:10

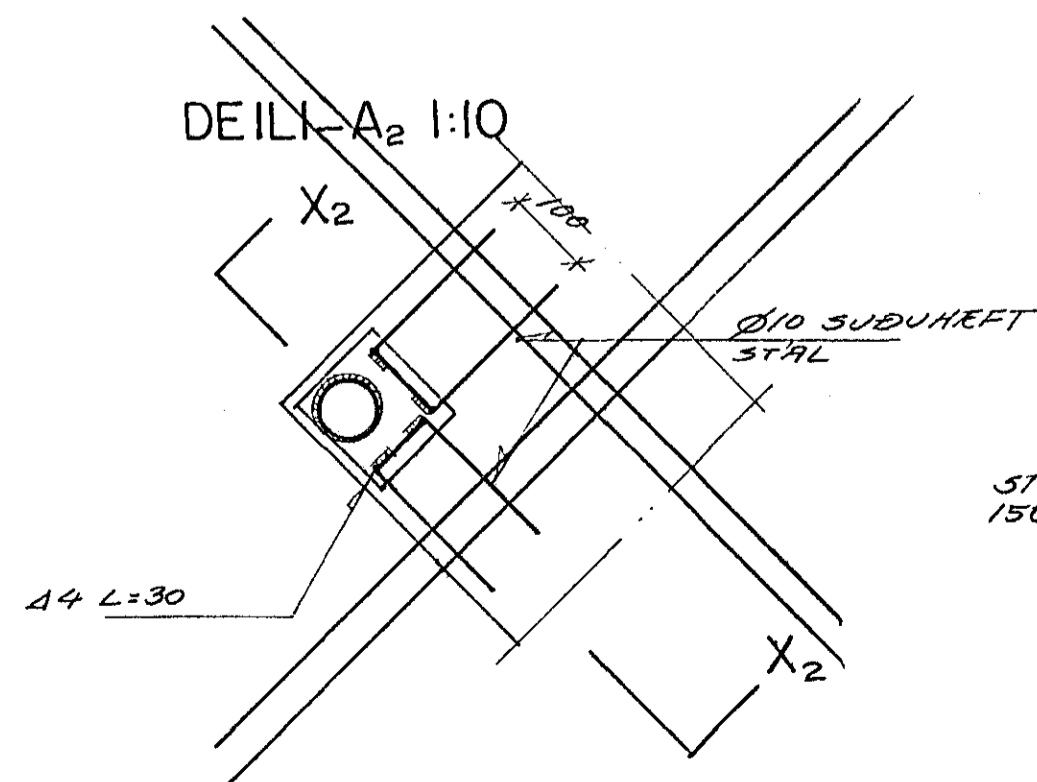


SNID X₂-X₂ 1:10

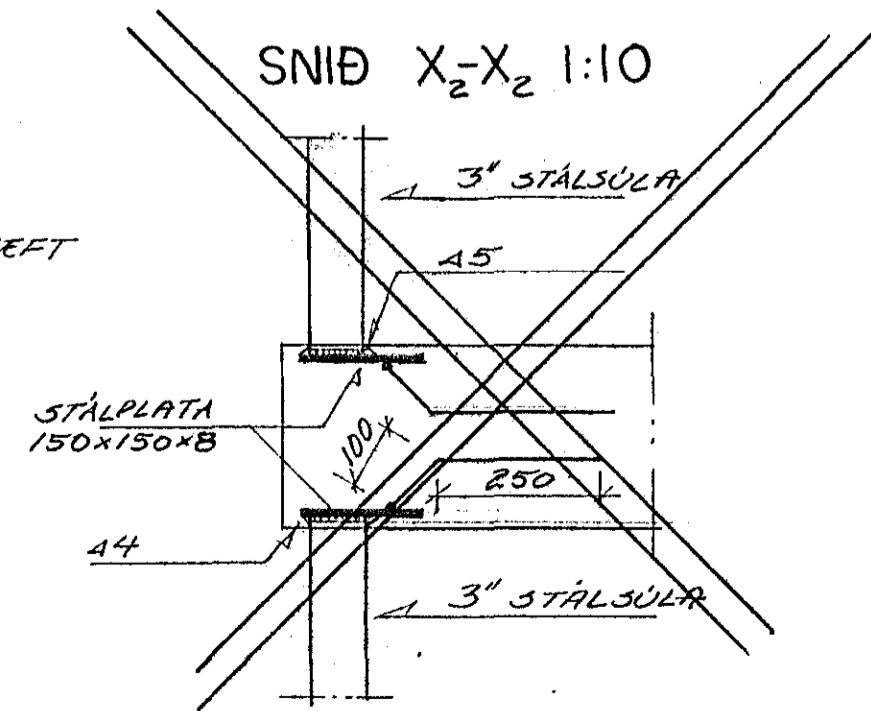

SNID Q-Q 1:20

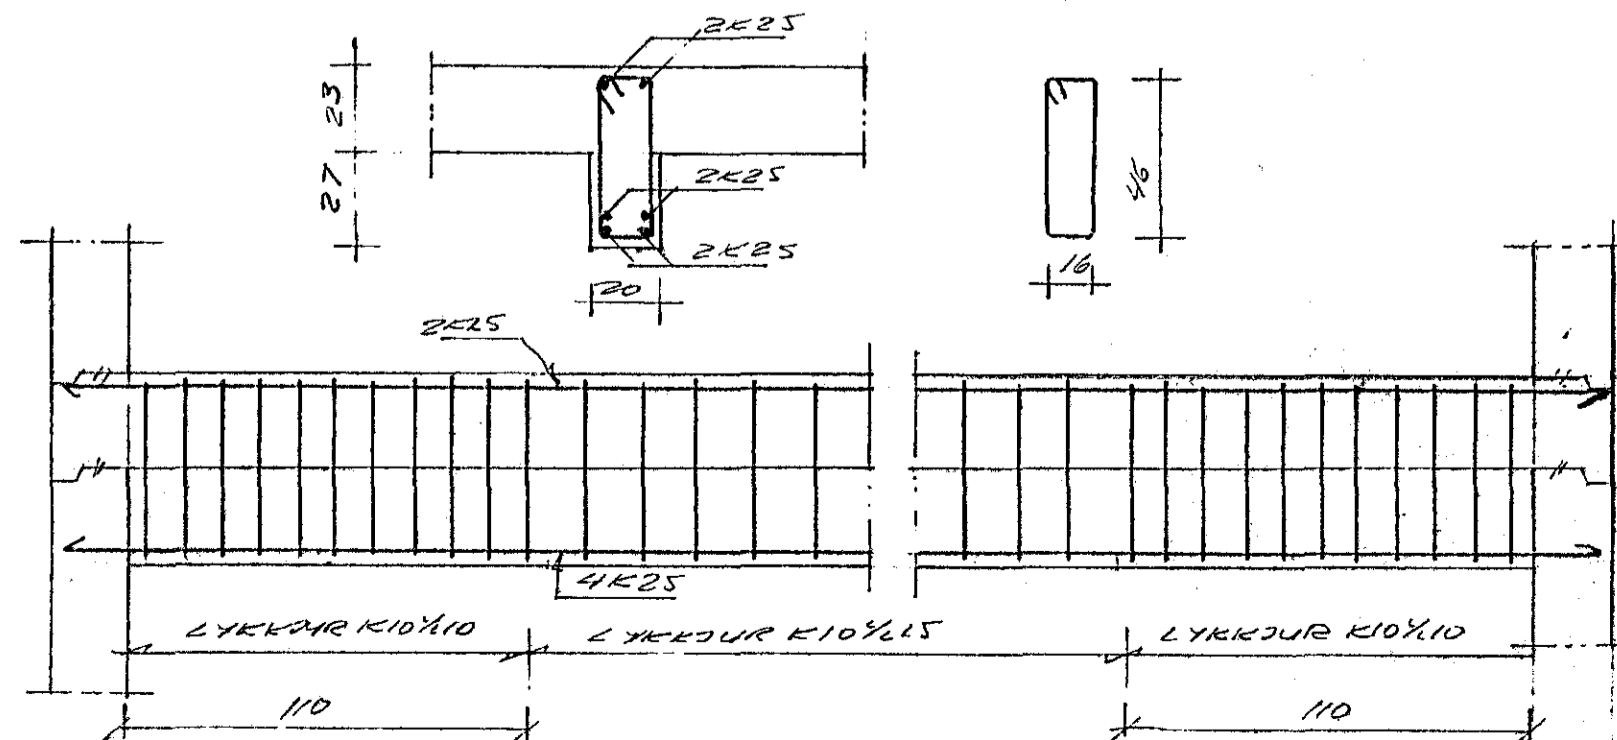

SKÝRINGAR SJA TEKN. NR. 2.01 OG 2.12
JÄRN Í SÖLU SIO SJA TEKN. 2.16

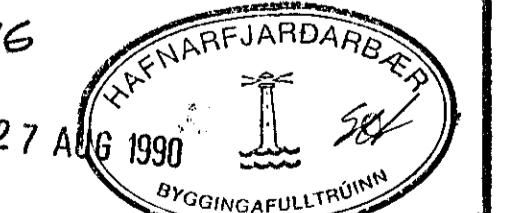

<p>TIKNIstofan RÖDULL ARMULA 36 · 108 REYKJAVÍK · Sími 33990 & 33577</p> <p>LÆKJARGATA 34 HAFNARF. PLATA YFIR 2. OG 3. HÆÐ HÚS-D</p>	TEKN: <i>Hh</i>	DAGS: FEB. 89
	REIKN: <i>Hh</i>	VERK:
	YFIR: <i>Hh</i>	BLÁD: 2.17
	MARK: 1:50, 1:20, 1:10	<i>Hh</i>