


KVISTUR

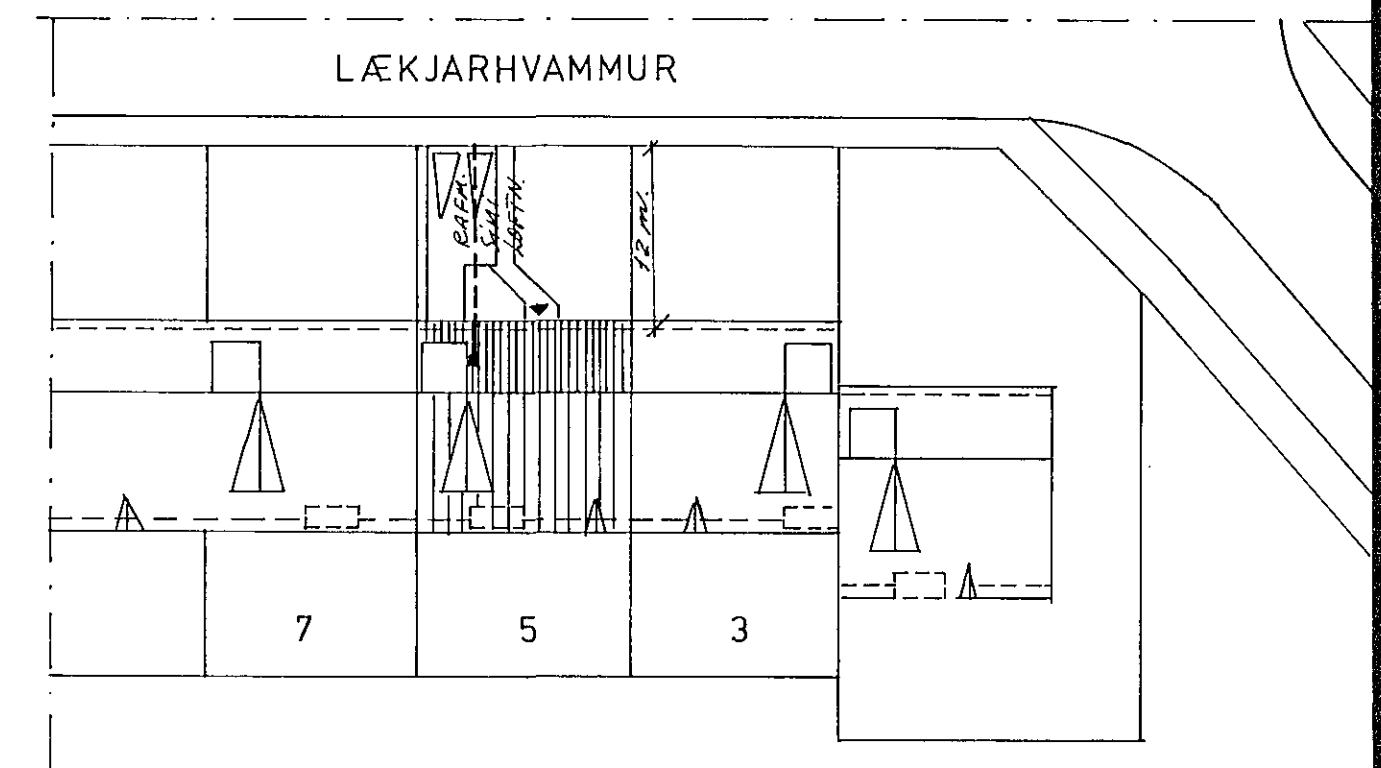

AFSTÖÐUMYND 1:500

<b>LIÓSTÆKNI</b> <small>Teiknistofa Skúlagötu 63 Reykjavík, sími 14041 Magnús Siguróddsson teknifræðingur ttfi</small>	<b>LÆKJARHVAMMUR 5. HAFNARF.</b>	
	<b>RAFLÖGN</b> GRUNNMYND HÆÐAR 1:50 AFSTÖÐUMYND 1:500 KVISTUR 1:100	
	VERK NR. <b>LT 655</b>	BLAD 2 AF 3 <small>AG 80 M. Siguróddsson</small>