


LÆKTJARKINN NR 24

24 1/2 83 hvernild á þrjúlagja reyklopium.
F. S. J.


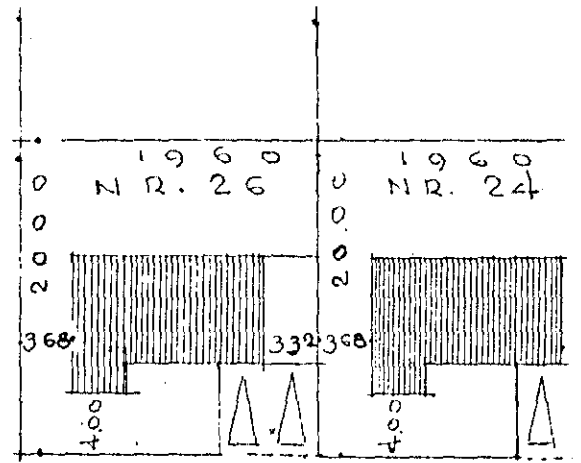


N O R D U R



M. 1
A

Stofn & fundi-byggingar
námstíð 16/6/82
BYGGINGA-ULLTILFIRN
I HAFNARFIRSI
E. S. J.

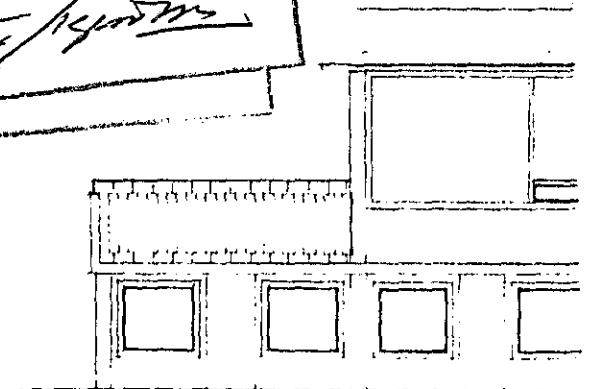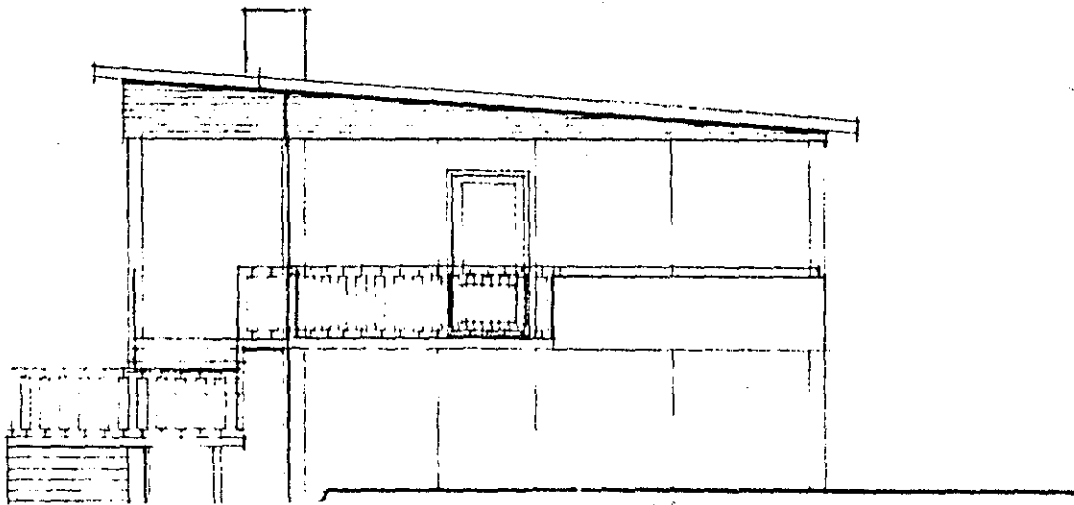

S U D U R