

sp 2/264

V E S T U R


# LÆKJARINN NR 24

4m<sup>2</sup> 10m<sup>3</sup>


1 5 9 2  
.88.164.77.164.73. 3 0 5 .68.106.77.10638106.80.10630

.88.164.77

Samþykkt á fundi bygginga-  
nefndar þ. 16/6 1982  
BYGGINGAUFULLTRÚINN  
I HAFNARFLODI  
*[Signature]*

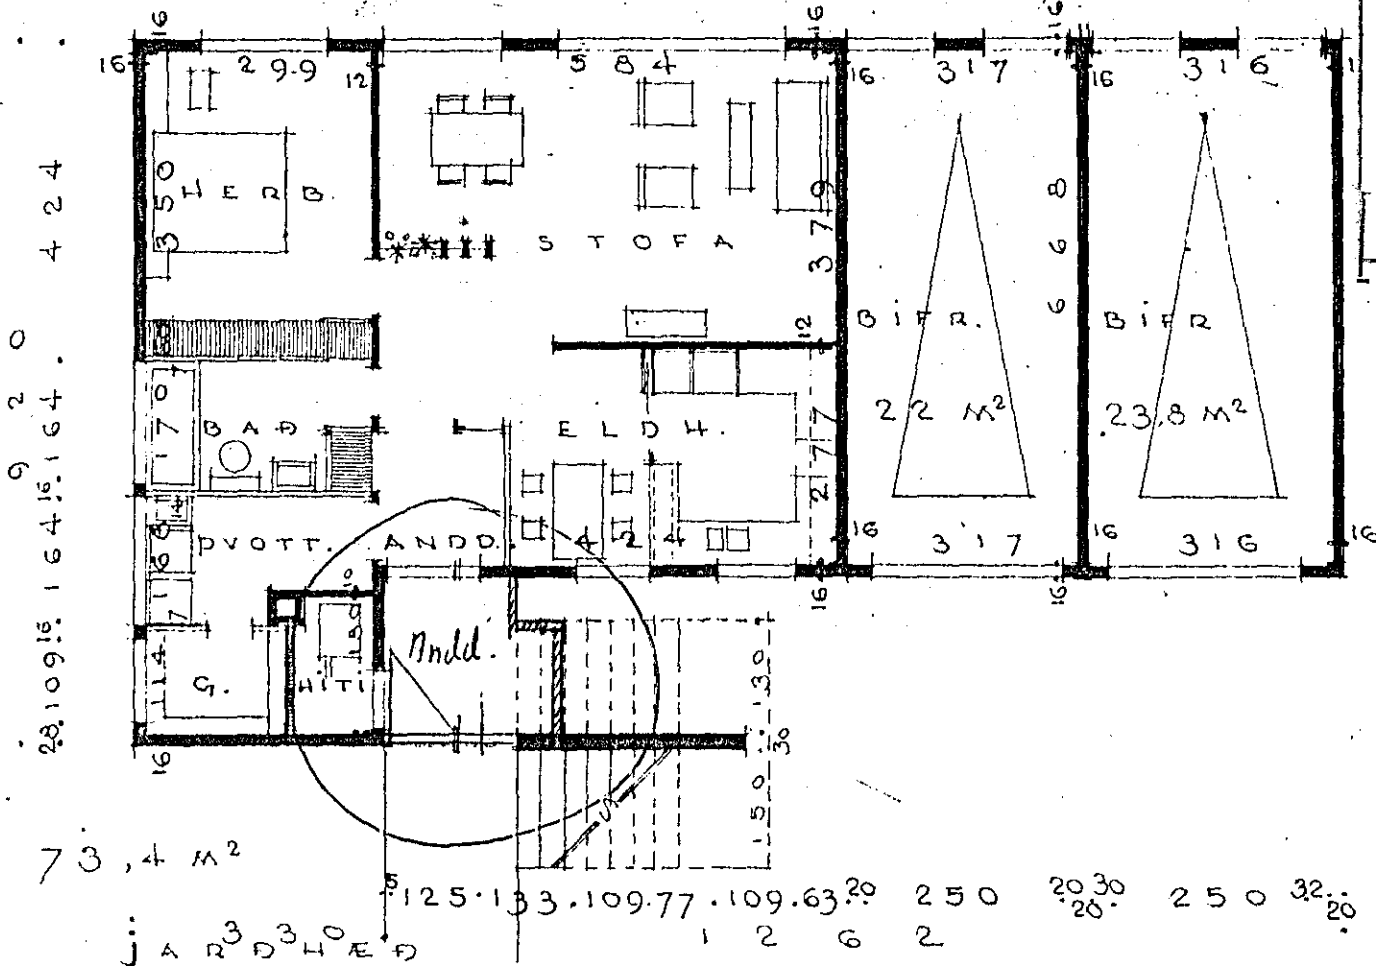

28.109.160. 2 2 0 .

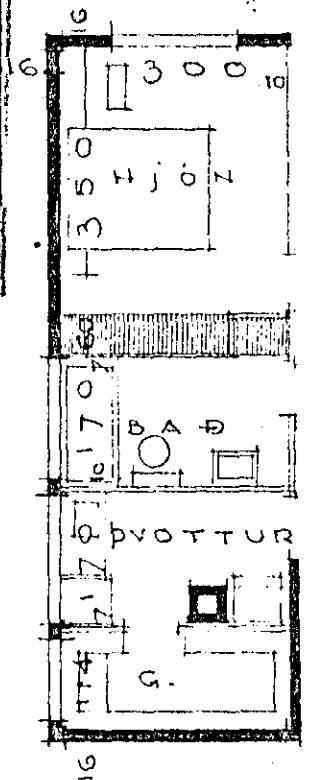

95.4 M<sup>2</sup>  
330  
2. H E D