

Sp 2/1254

V E S T U R


# LAKJARKINN NR 26

4 m<sup>2</sup> 10 m<sup>3</sup>

1 5 9 2  
.88.164.77.164.73. 3 0 5 .68.106.77.10638106.80.10630


.88.164.77

Samþykkt á fundi bygginga-  
nefndar þ. 3.11.1976  
BYGGINGAFULLTRUINN  
Í HAFNARFIRDI

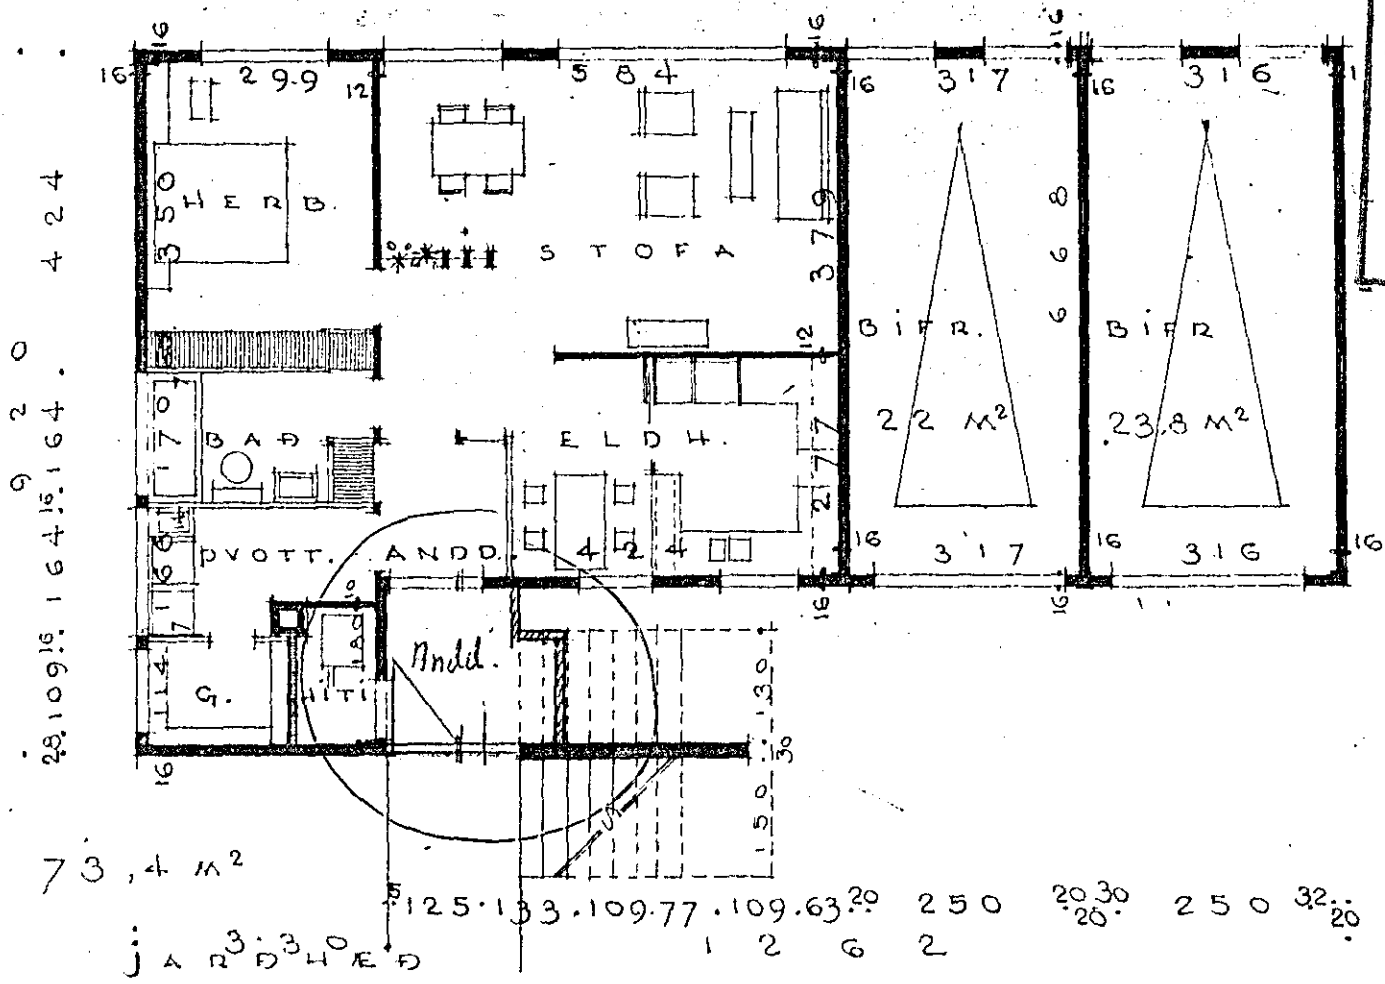

28109.100.

220.

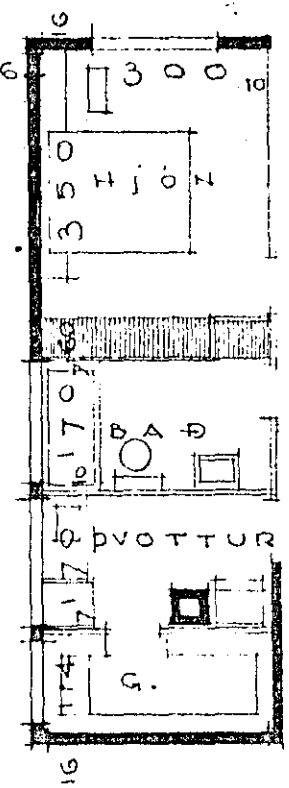

95.4 M<sup>2</sup>

330

2. HÉÐ