

Bárustál
10cm steinnúll
vindrappi

57/100
EYRU 1/2 60 X 120
ISTEYPT

RP 42/120

LOUN (KROSSV.)
57/125
1/2 SUITTEIUN
1/2 120.

DÆK BIRJÚT
BÁRUSTÁL

BREYTING:

ISTEYPT
FESTING.
1/2 120.

RP 42/120

K25 L=100


EYRA 50x150x5 mm
1/2 120 SÖBID Í ÞESTU

LJÓST BÁRUSTÁL

BÁRUSTÁL
HVITT

KNEKTI
1:10

10CM STEINULL
PAPP, UTAN OG INNAN.

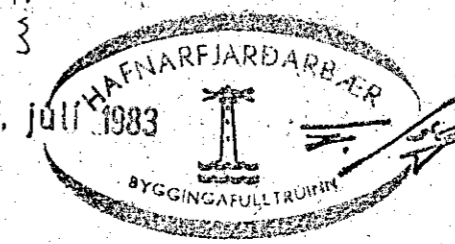

ALLIR NAGLAR OG FESTINGAR
GÁLV.
VINDPAPPI UJDIR ALT TRES
SEM SUERTIR STEIN.

FESTA VIÐ KNEKTI

LB 30/60




FESTA VIÐ SÚLU

LB 30/60

BREYTTIST SJÁ BLAÐ 39.

SÚLA
1:10

SNID Í VEGGE
1:10

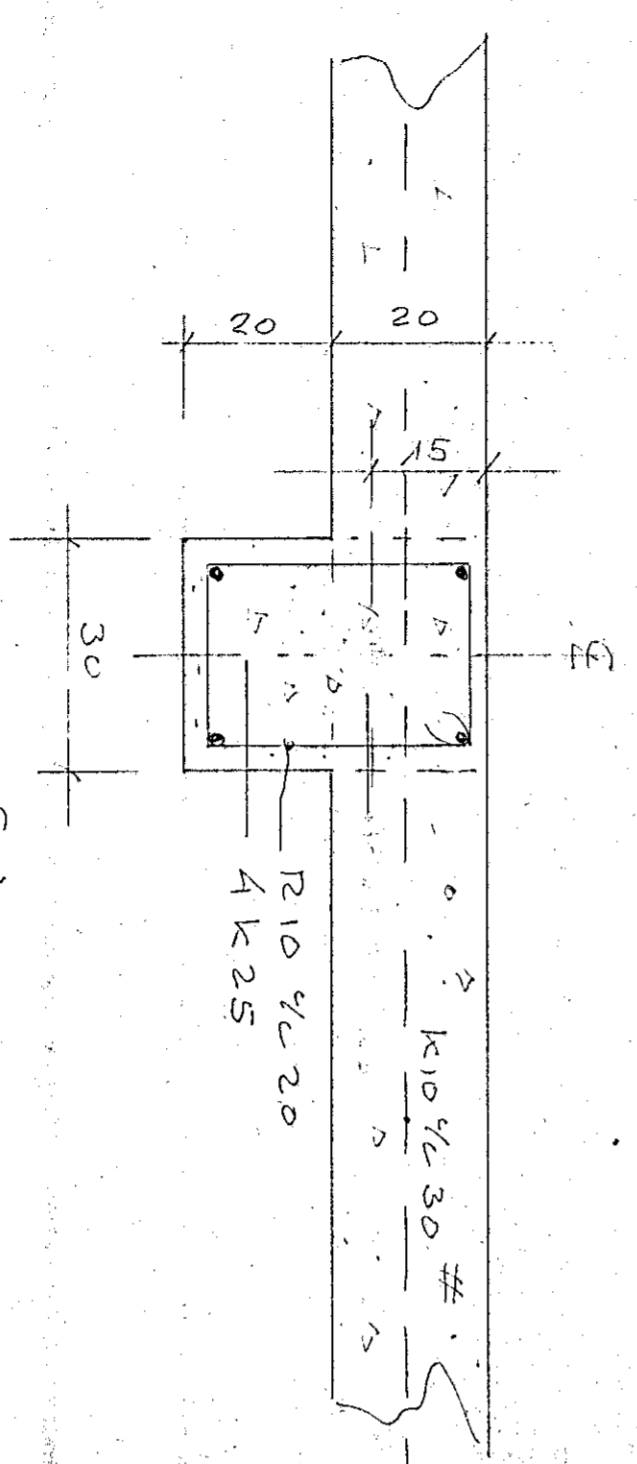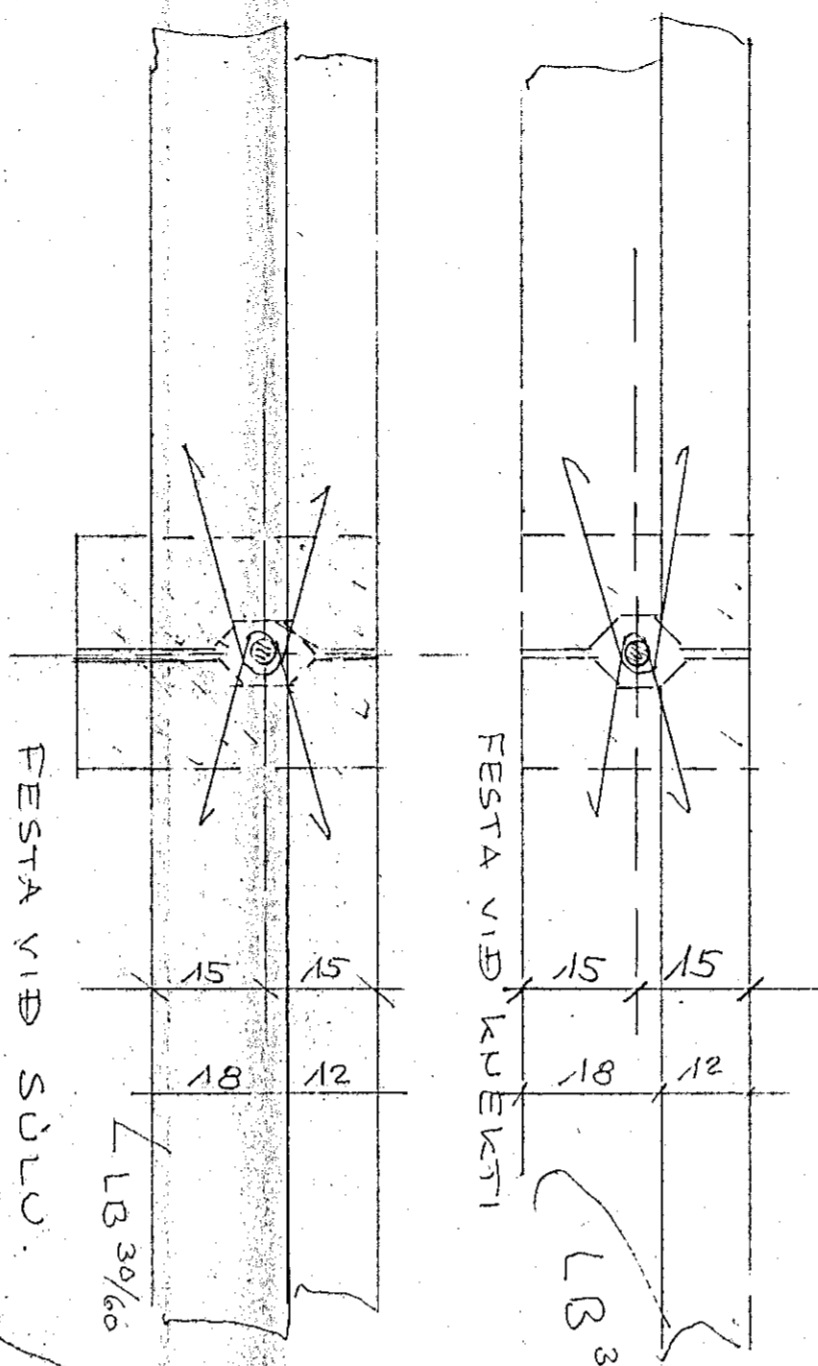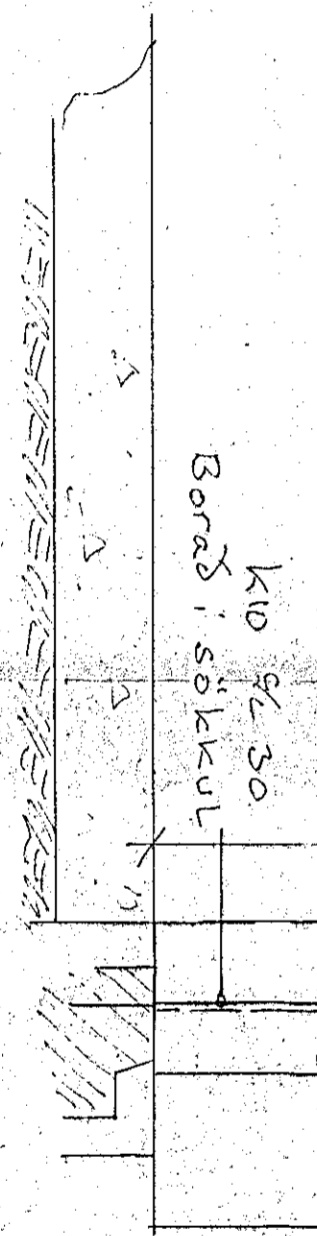

DAGS.	BREYTING		GJORT
HANNAÐ JB	JÓN BERGSSON DIP. ING.	VERKFR. M.V.F.I.	BLAÐ. 37
TEIKNAD JB	MELABRAUT 19.		VERK.
YFIRFARID JB	ÞVERSNIÐ		
SAMÞYKKT	M=1:10	DAGS. APRIL '83	