



GRUNNMYND 1:50

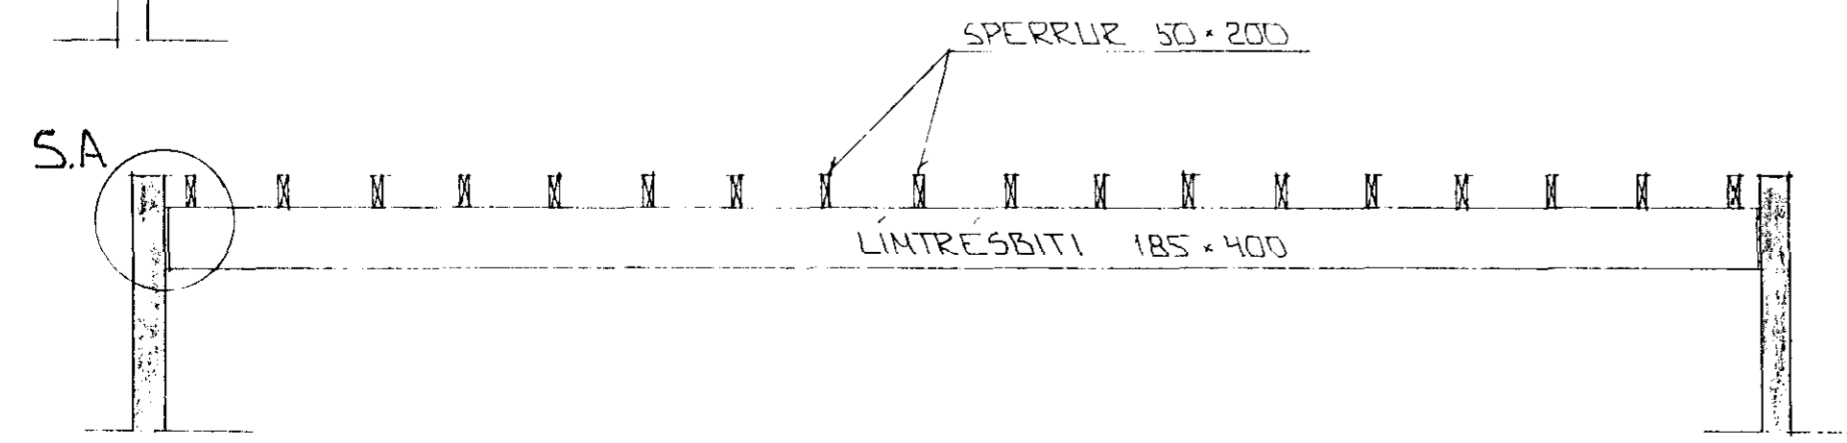

SNID 1-1 1:50

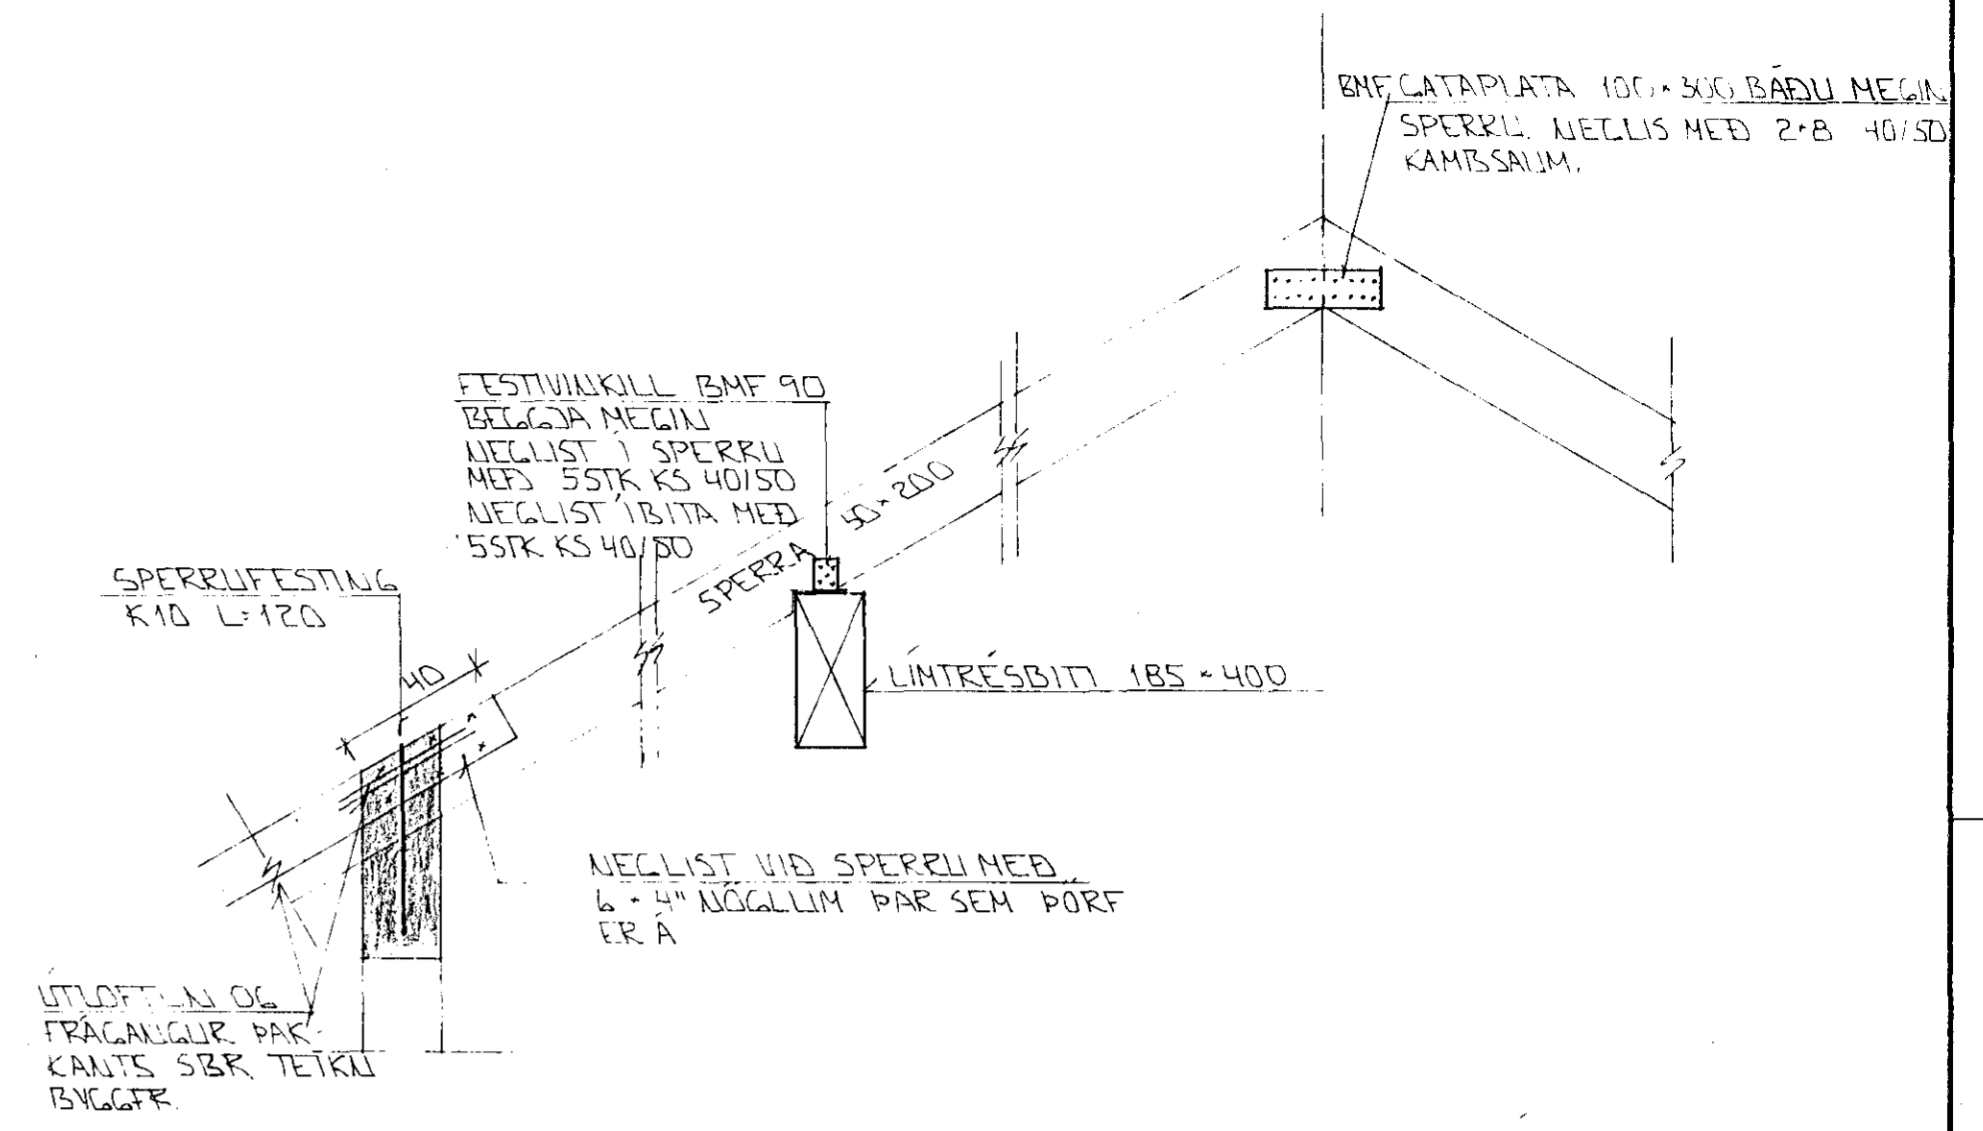


SNID 2-2 1:20


SKYRINGAR

LEIÐRÉTTAR LAGFERÐAR OG
STADFERÐAR TEIKNINGAR
GUDJÓNS Þ RAGNARSSONAR T.F.R.

SNID 4-4 OG SÉRMYNDIR SB OG SC
SJA BL. NR. 1-02.

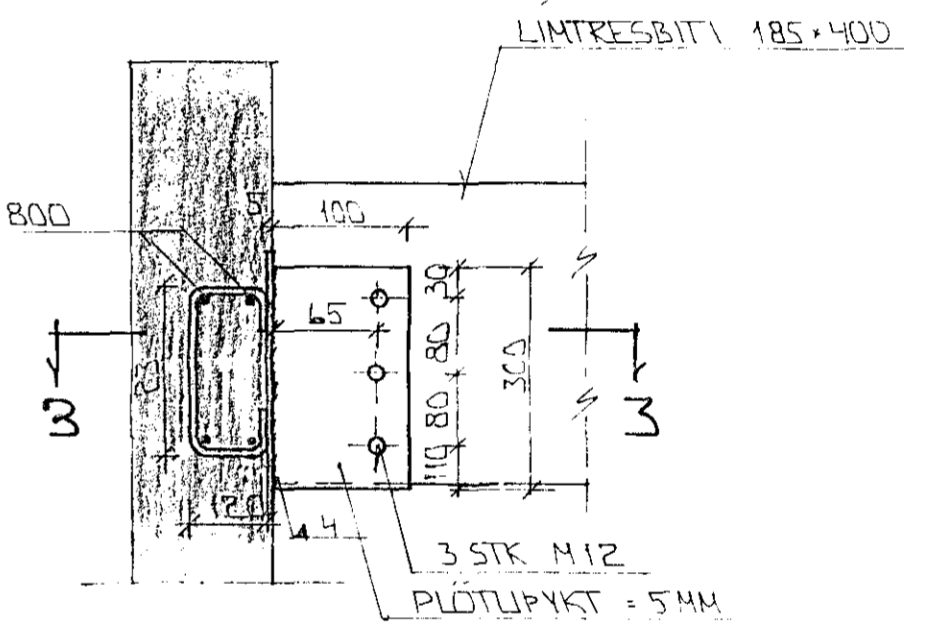

SÉRMYND A. FRÁGANGLUR BITA Í
VEGG 1:10

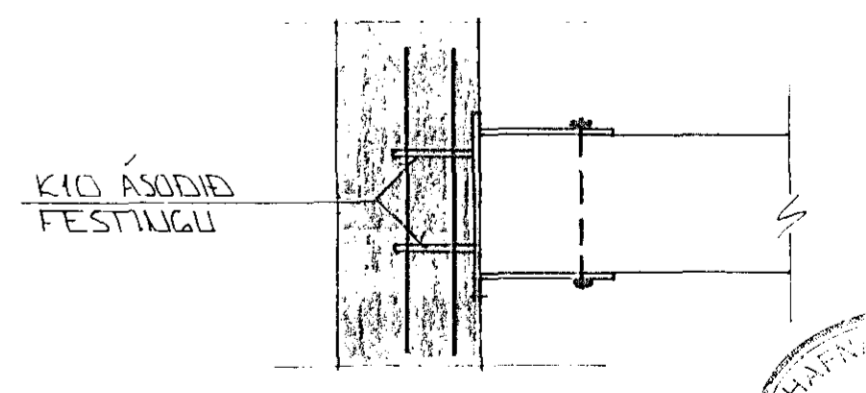

SNID 3-3 1:10

16 NOV 1992			
Hafnarfirði			
02	13.11.92	SÉRMYND D LINTRESBITI KVIS?	GH
01	AGUST'92	SETTUR KLUSTUR	GH
BR NR	DAGS	EBLI BREVTINGAR	SIGN
MÓBERG & HAFNARFIRÐI			DAGS APRIL '92
GRUNNMYND - ÞAKVIRKIS			HANNAÐ
MELIKV. 1:50 + 1:20 + 1:10			TEIKNADGH
SIGURÐUR ÞORLEIFSSON			VERK NR 9214
STRANDGÖTU 1 HAFNARFIRÐI SÍMI 54751/54255			BLADNR. 1-01