

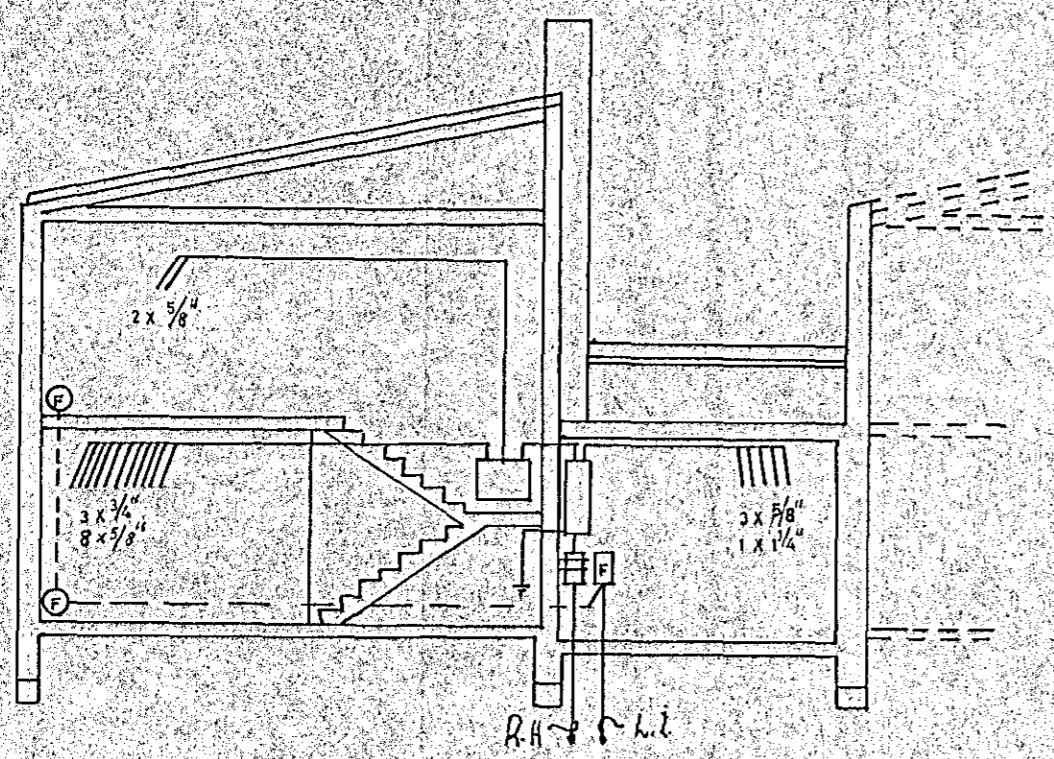
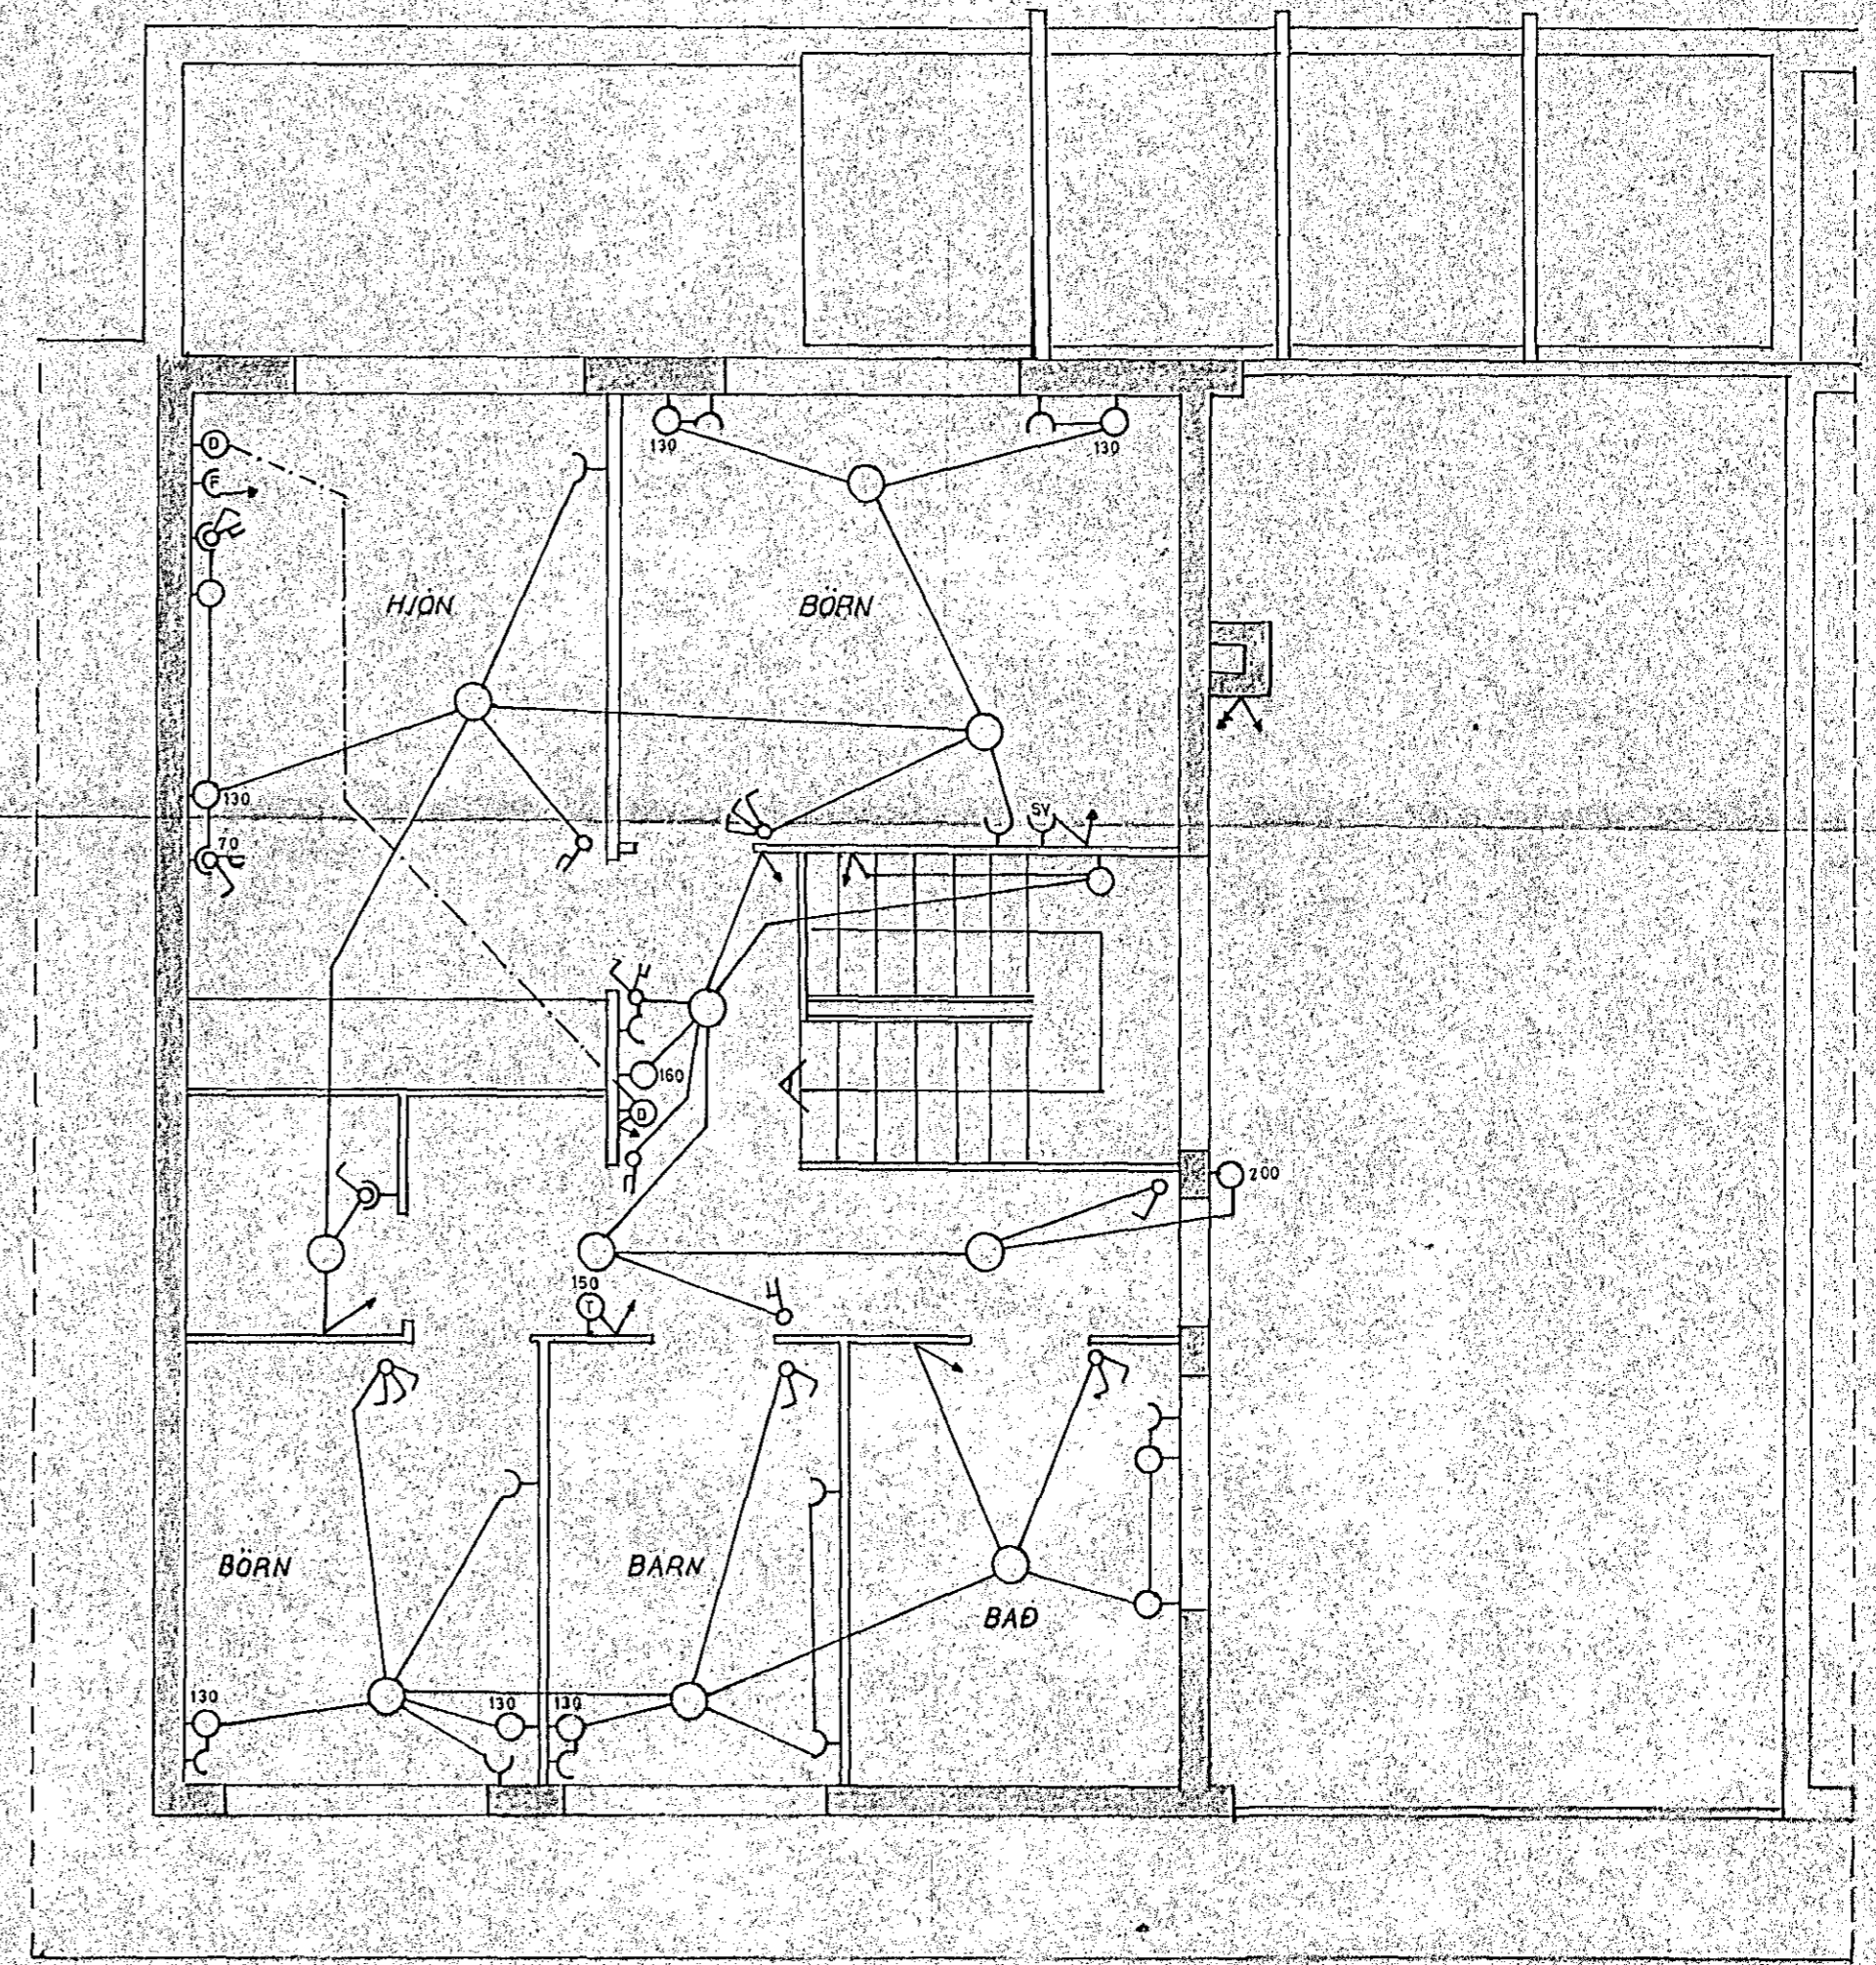


Húsvætt nr. 2065 Teikning nr. 1239
 Samþykkt þ. 45 1971
 l.h. RAÞVEITU HAFNARJARDAR
 Eðrlitamaður rálagna

Inntök samþykkt 31.12. 1971
 l.h. RAÞVEITU HAFNARJARDAR
 Verkfrófi

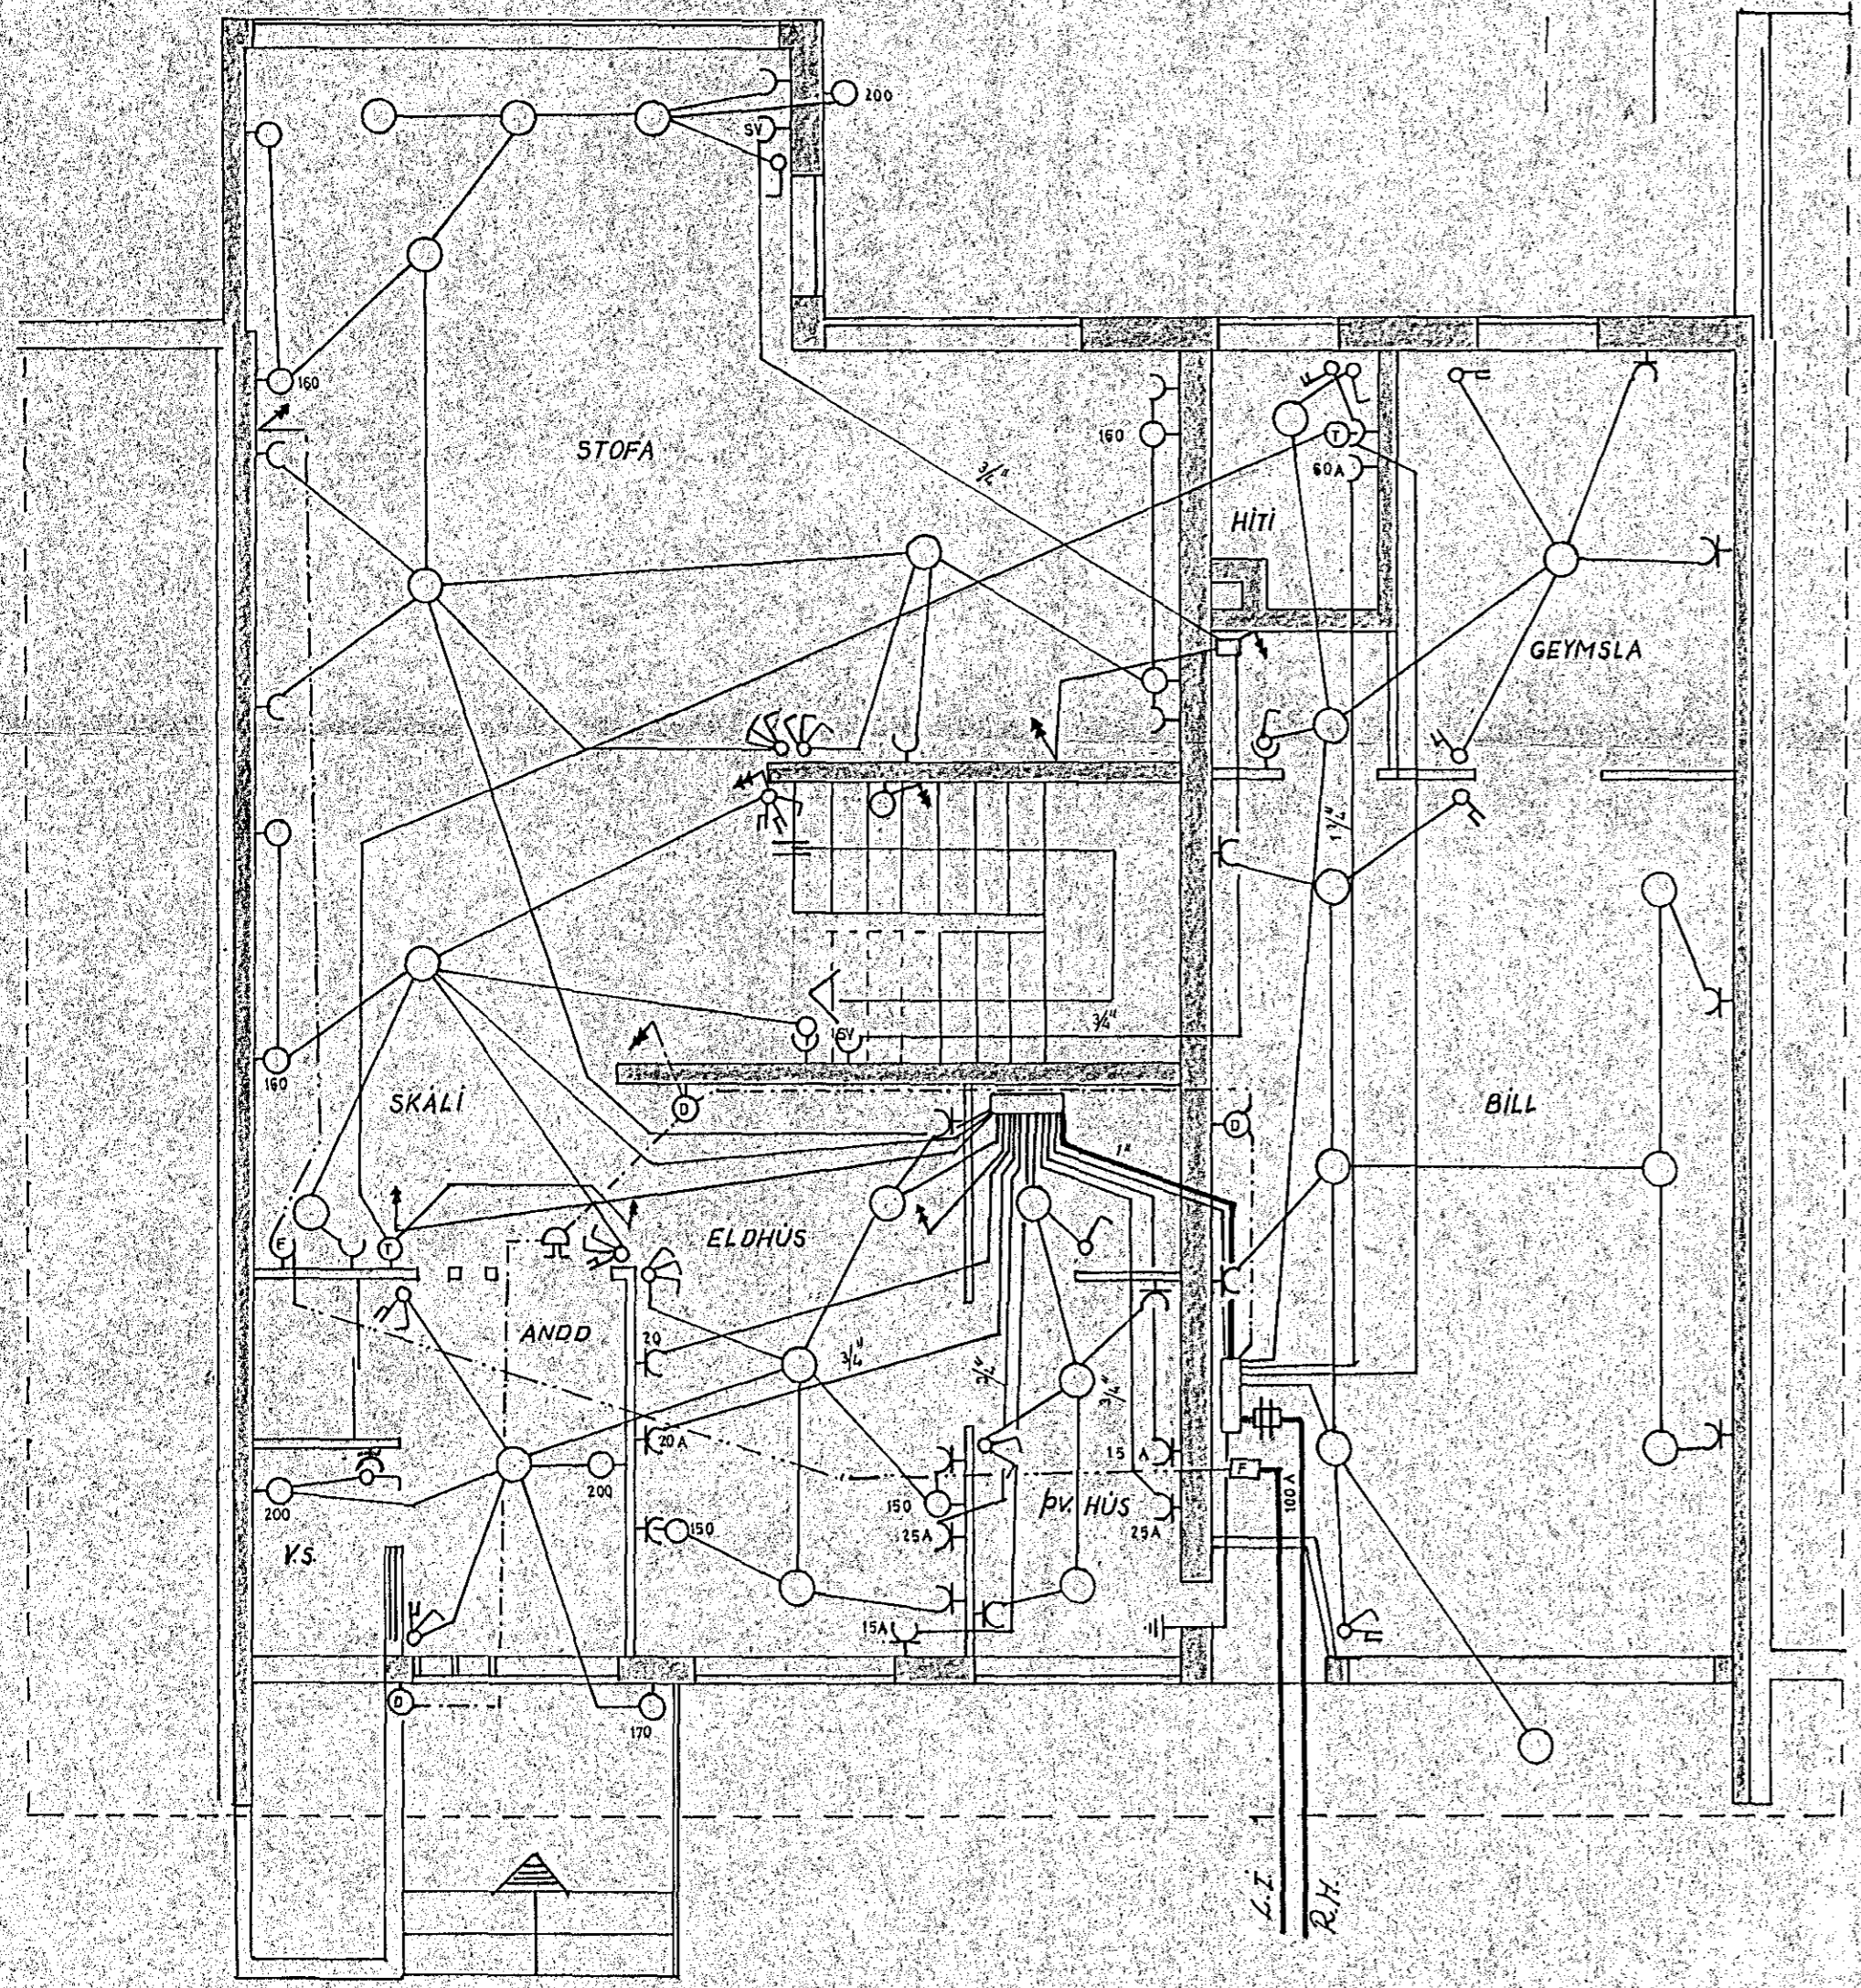

MÍÐVANGUR

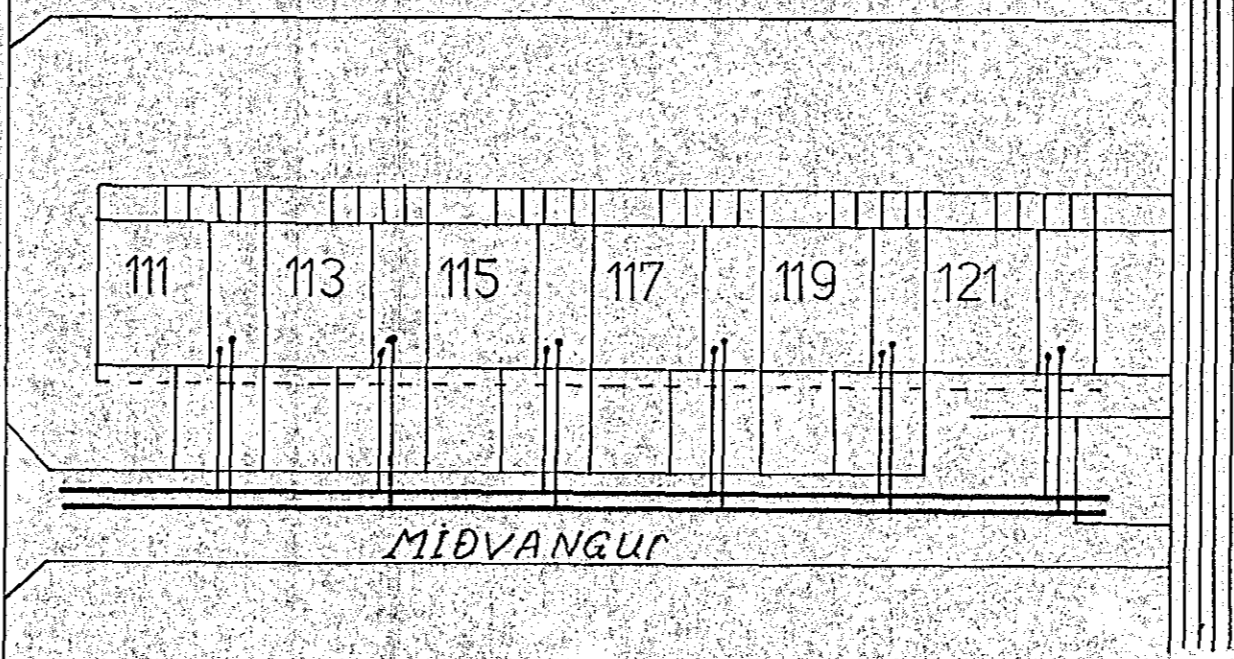

Utgáfu nr.	Dags.	Breyting.	Teikn.	GA.
19/11				
Róbjón Arnbjörnsson Erlubrauni 9 Sími 50887		RAFLAGNATEIKNING. MÍÐVANGUR, NR. 113		
				001/10
				NR.