
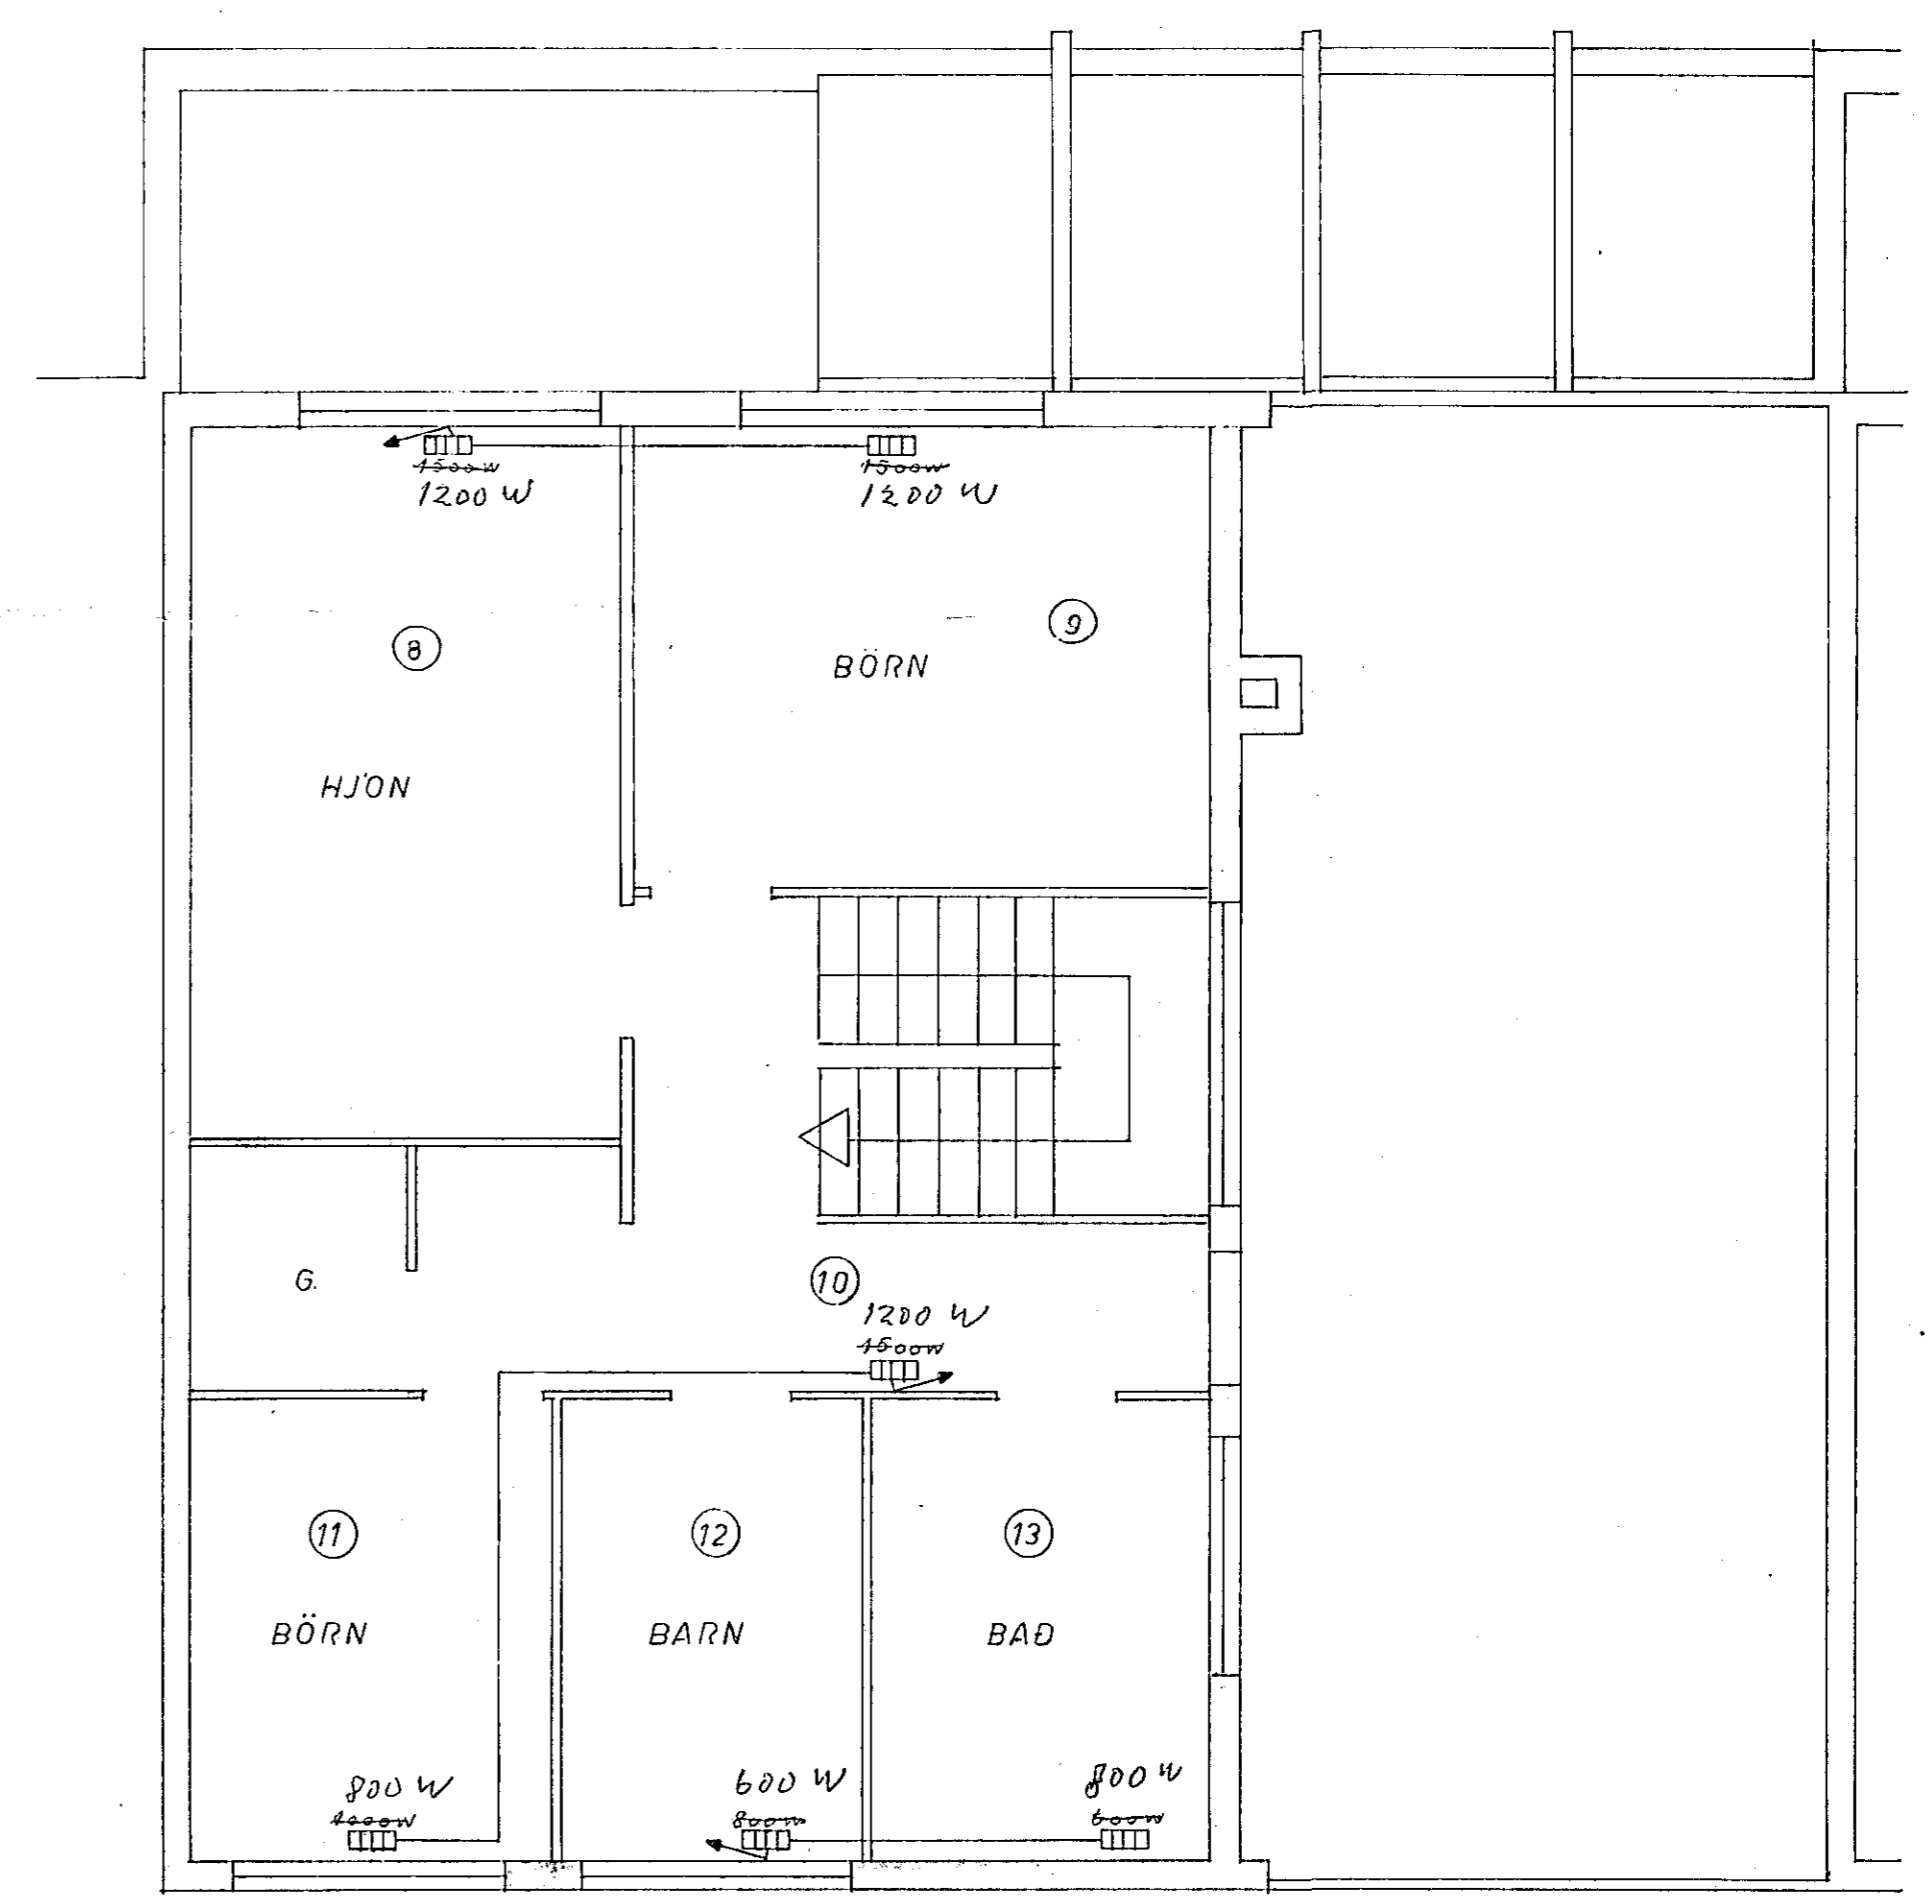
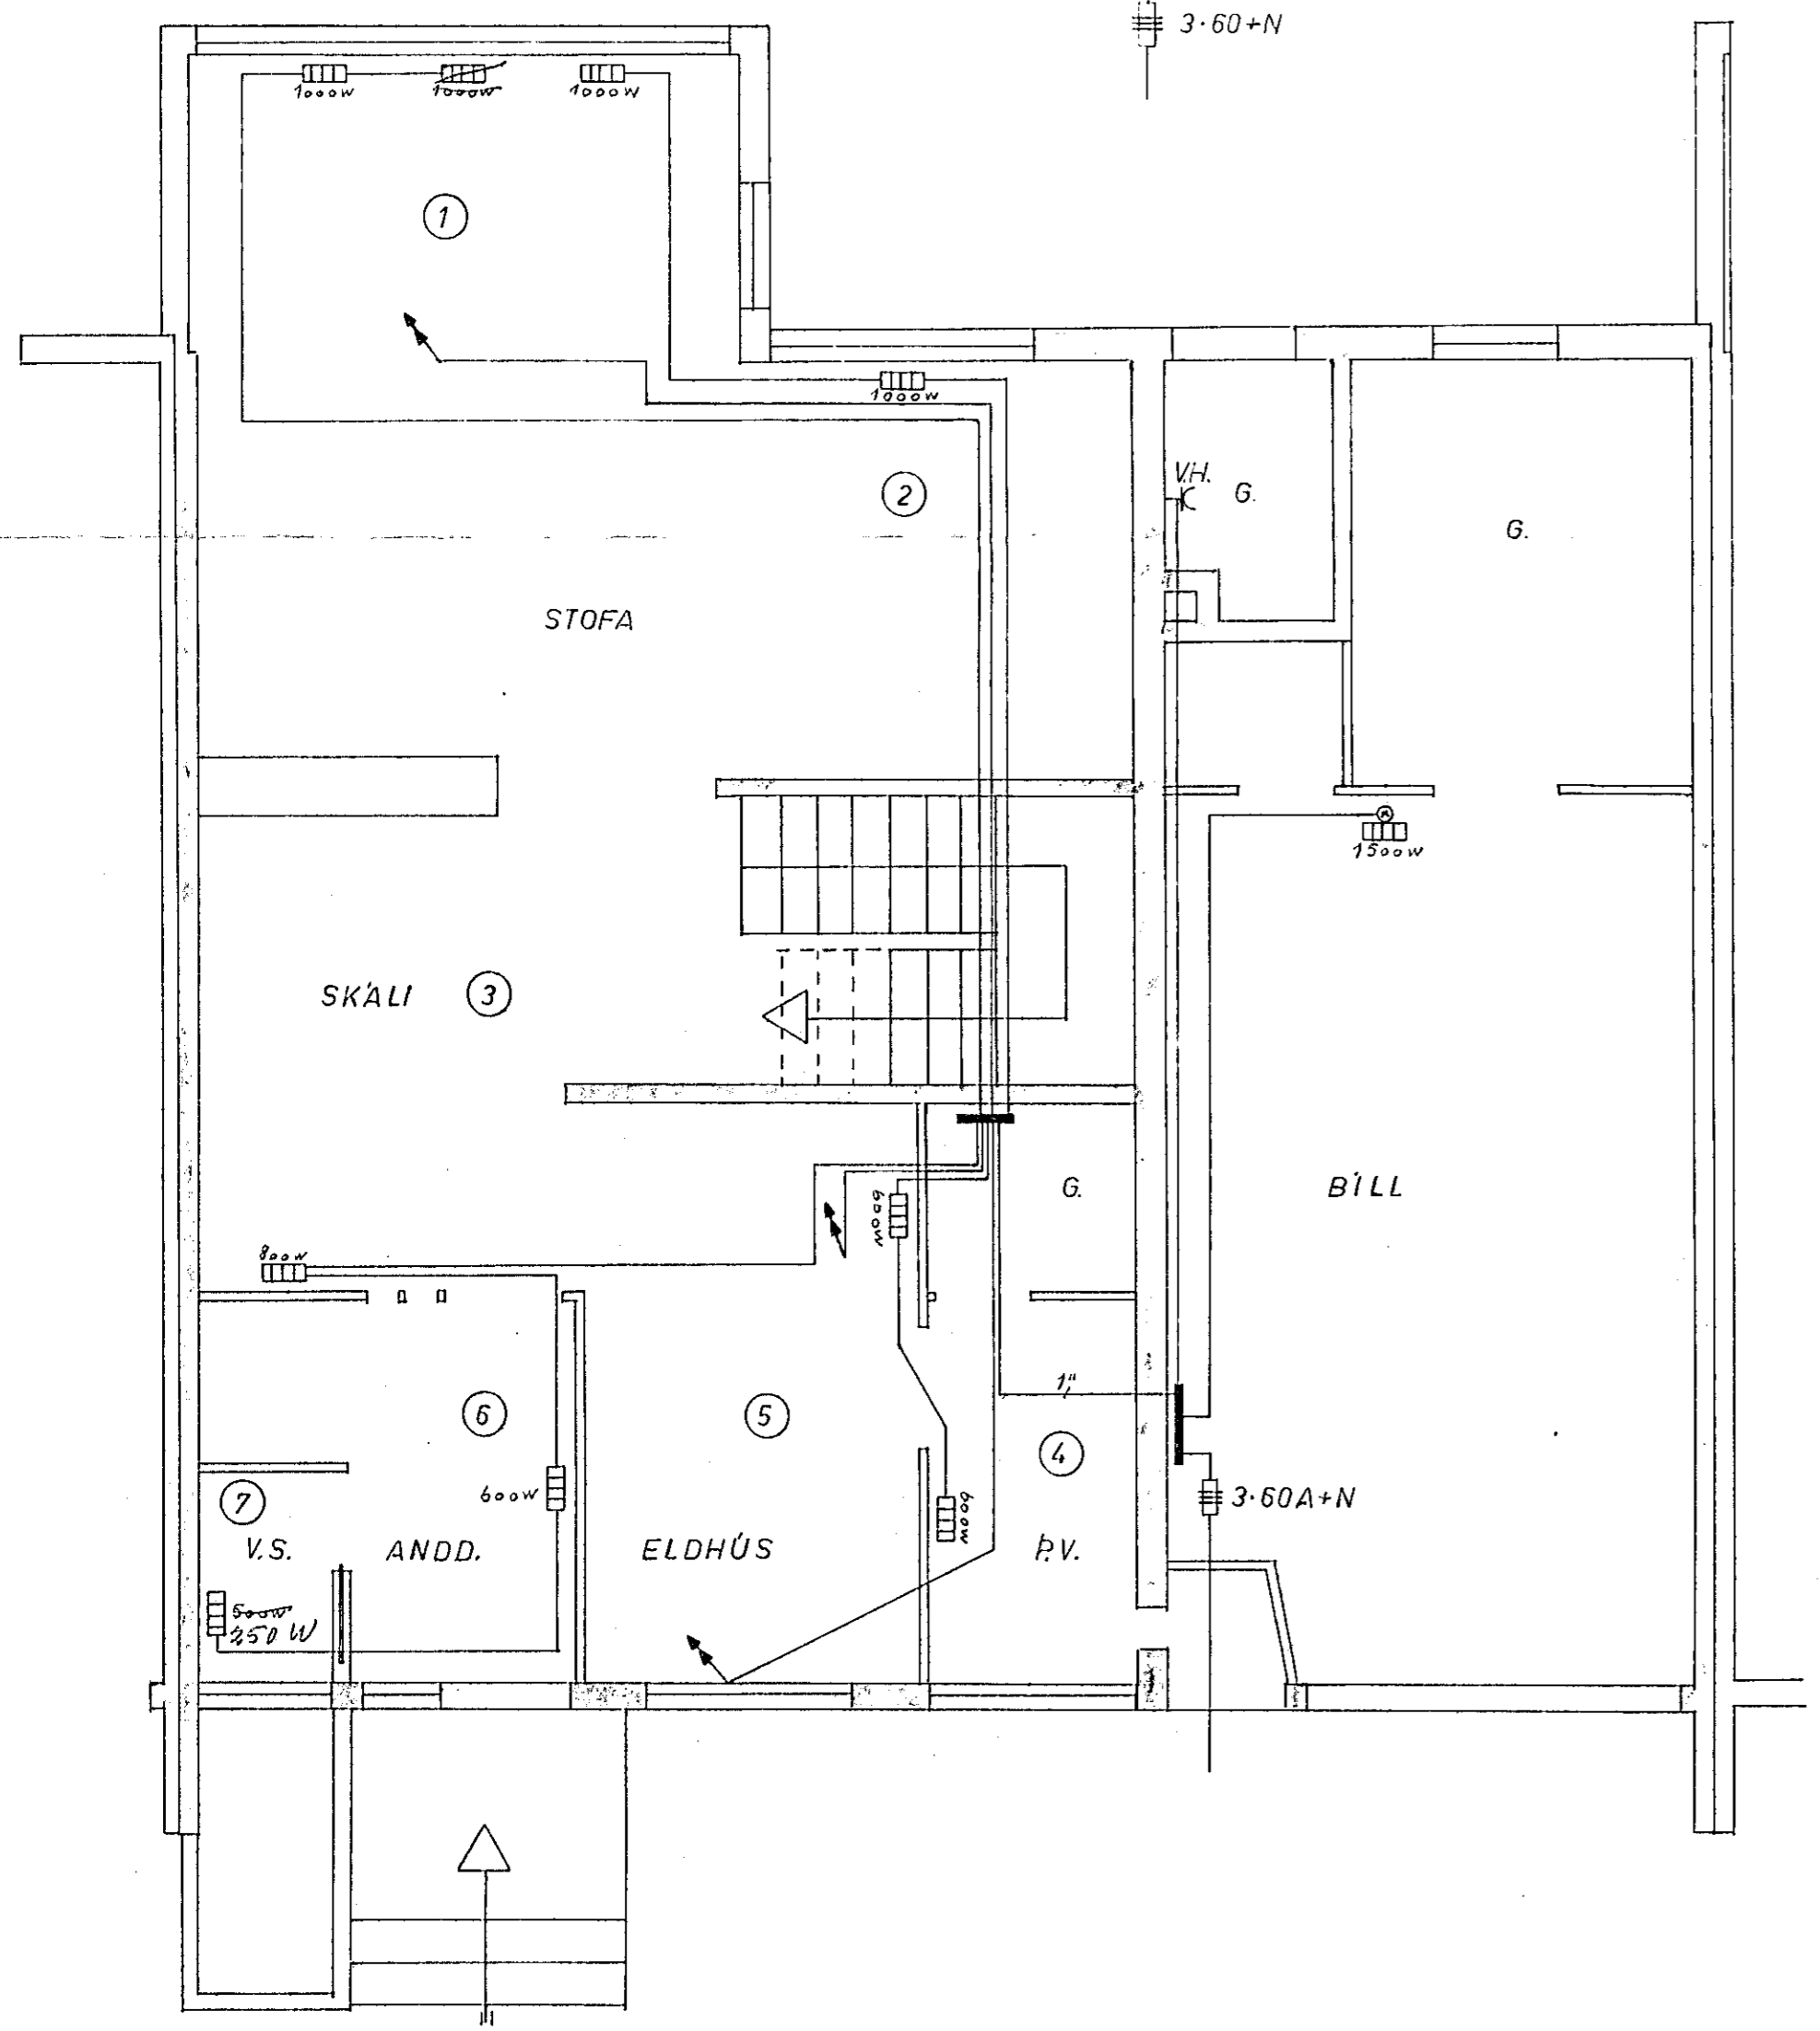


MÍÐVANGUR NR 139
 RAFHITUN

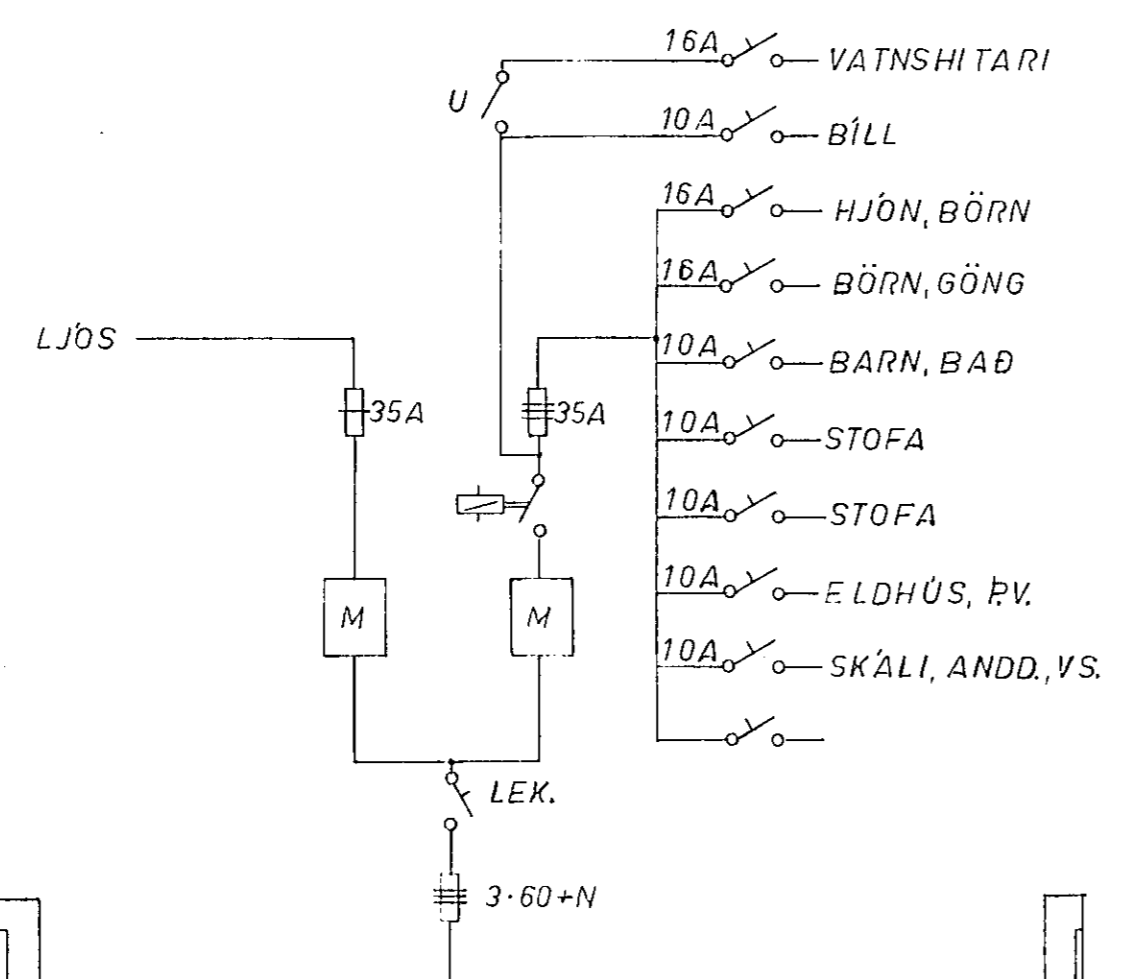

HAFNARFIRÐI 1 NÓV. 1971

Pósti Jónsson