


KVERKSPERRUR 50/150
 SPERRUR 50/125 c/c 600
 KLÆDNING 25/150
 PAPP
 ISÁRJAÐN

REYKHÄFUR OG ÞAKKANTUR
 SKV. SÉRTEIKNINGU ARKITEKTS.

18 NOV 1991

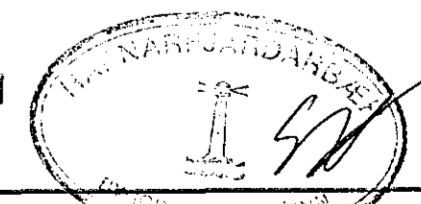

NOV '91	MENIR LEKKADUR UM 400mm	J.B.
DAGS	BREYTING	GJORT
HANNAÐ J.B.	JÓN BERGSSON VERKFR. VERKFRÆÐIHÖNNUN DIPL. ING. M.V.F.I. SMÁRAHVAMMI 4, HAFNARF. S. 51974	BLAD 6
TEIKNAD J.B.	SAMÞYKKT J.B.	M=1:50
YFIRFARID J.B.	VERK ÞAK	DAGS OKT '91