




Austurgafi Mkv. 1:50

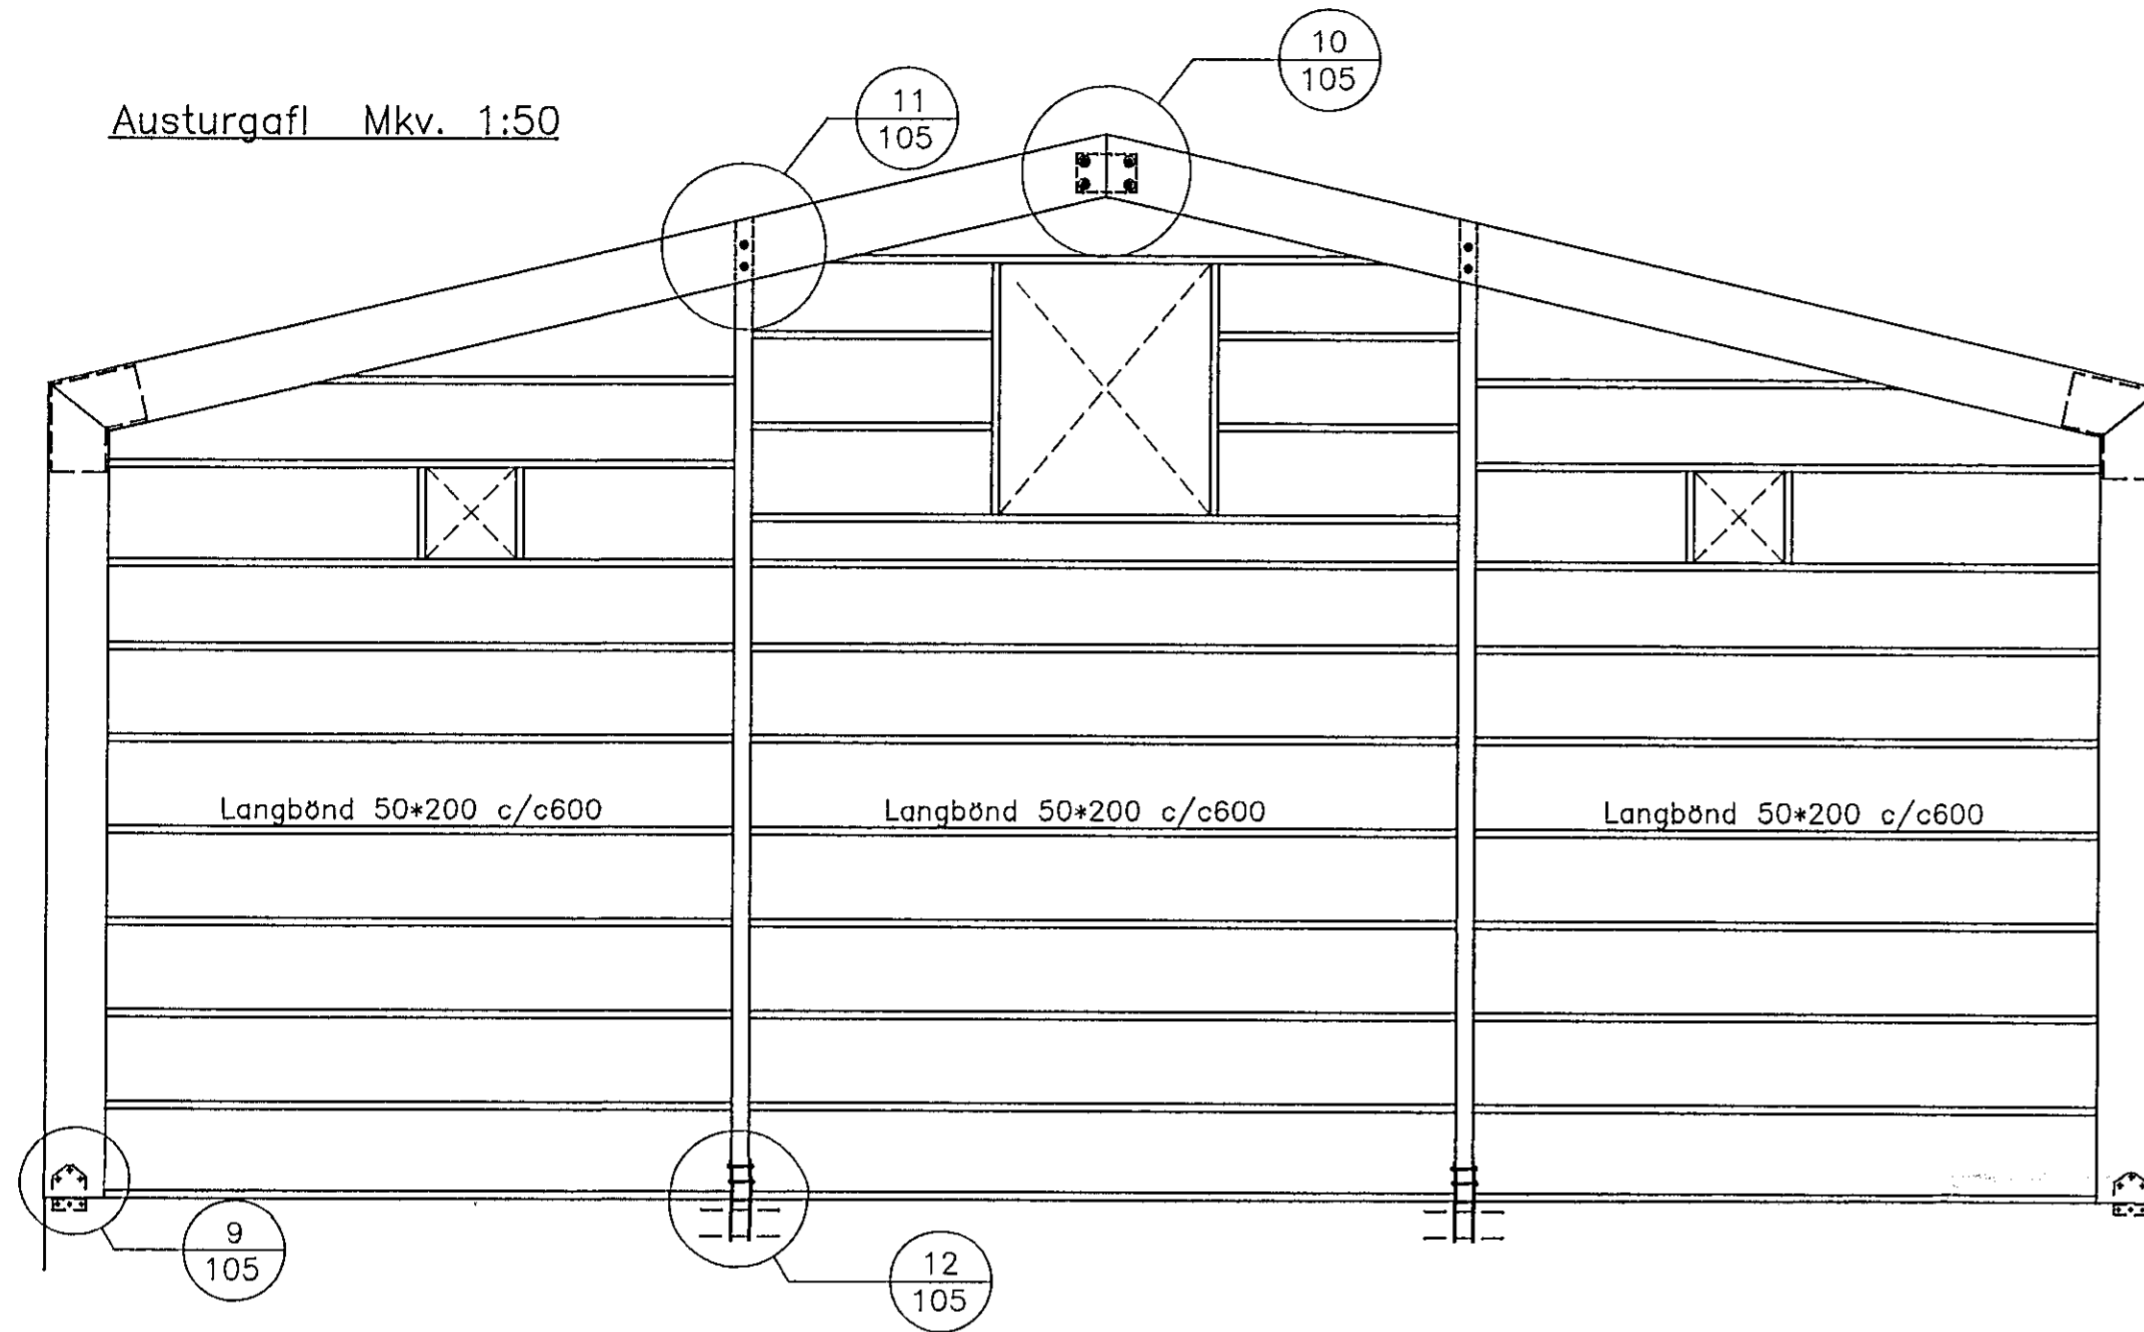


Sérmynd 11/105 Mkv. 1:10

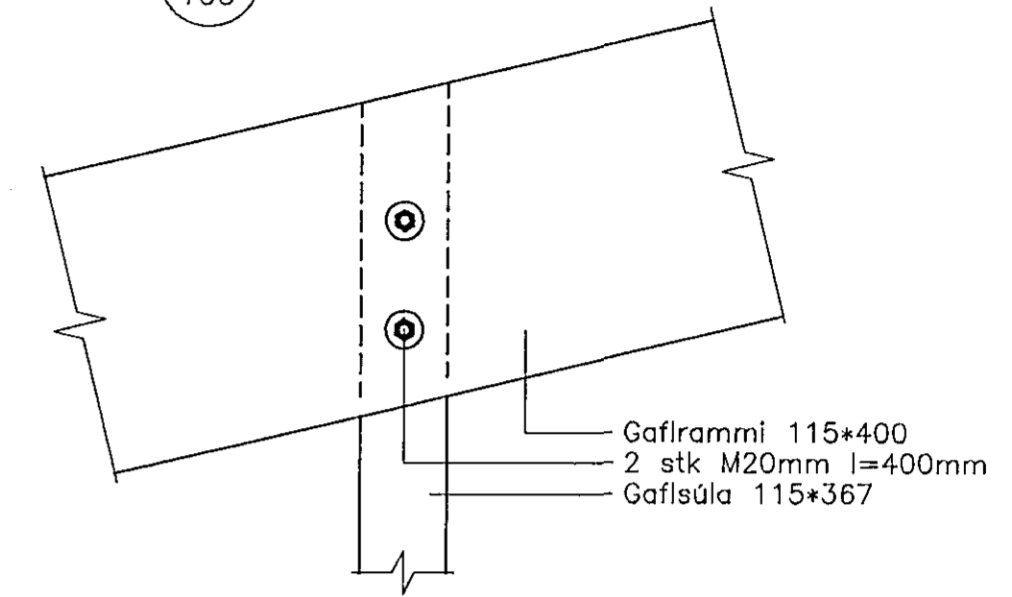


Sérmynd 12/105 Mkv. 1:10

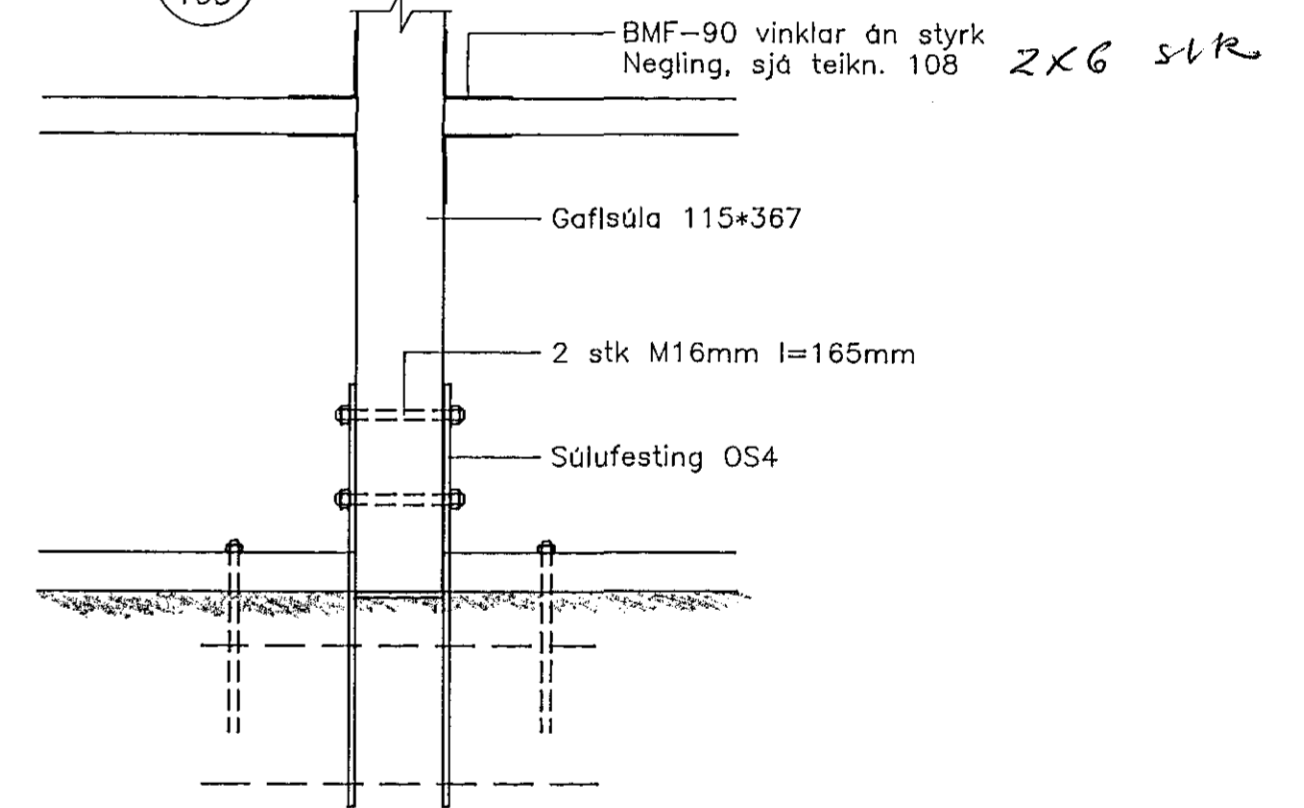


Sérmynd 9/105 Mkv. 1:10

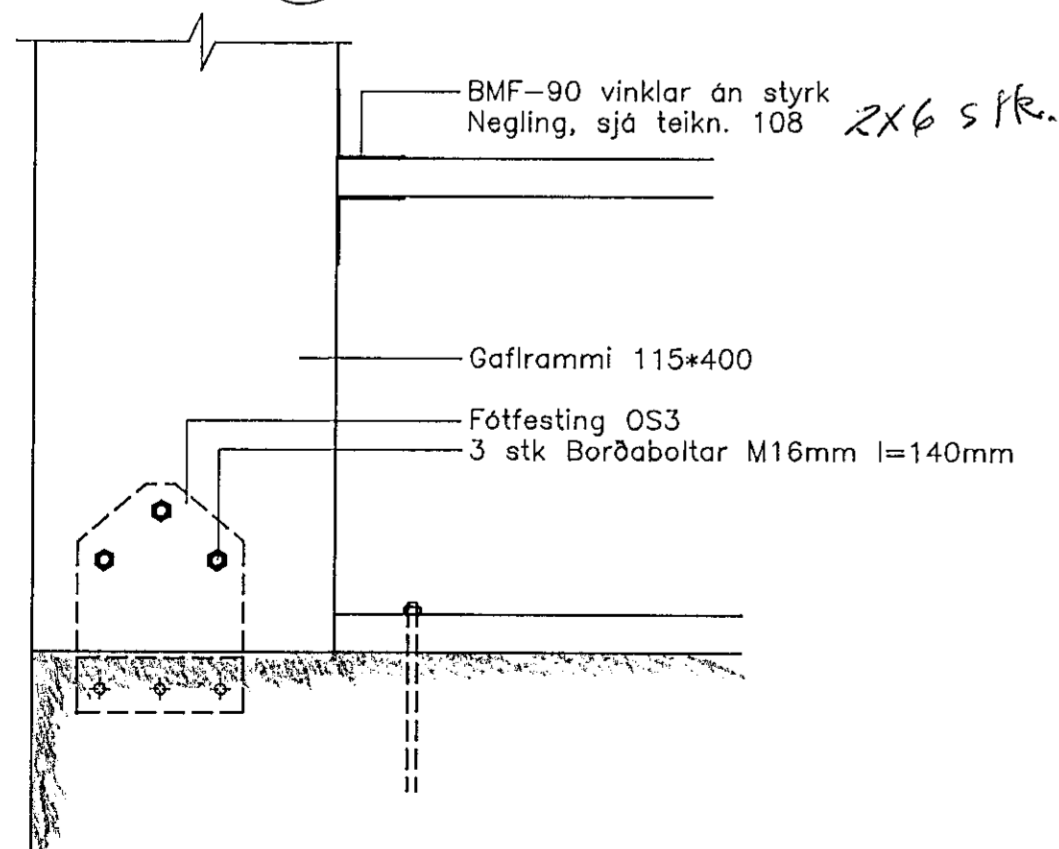

Sérmynd 10/105 Mkv. 1:10

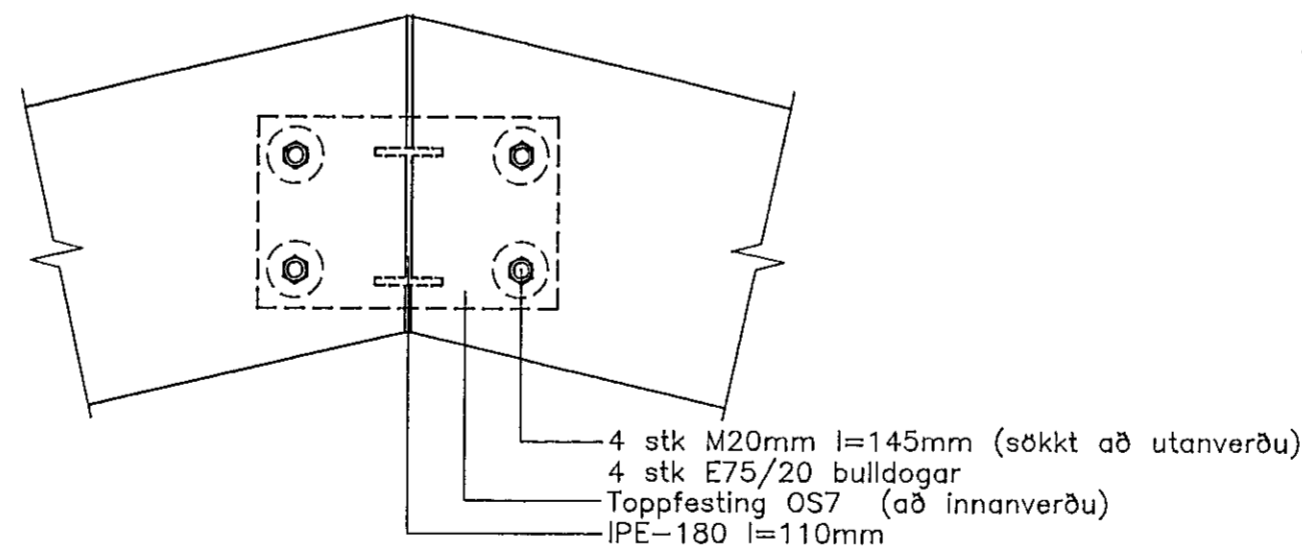

OSEY-105.DWG

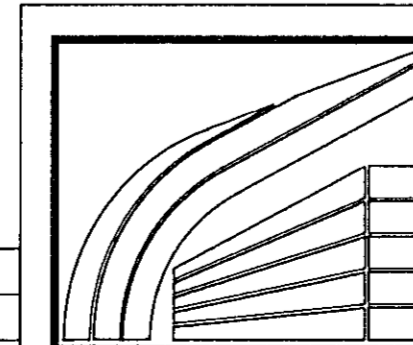

LÍMTRÉ HF. FLÚÐUM S: 98-66750
REYKJAVÍK S: 91-687202

Óseyrarbraut 4, Hafnarfirði

Austurgafi - sérmyndir

TEIKN.	DAGS.
REIKN.	VERK
YFIRF.	BLAD
MKV.	1:50, 1:10
105	

[Handwritten signature]

Breyting	Dags.	Skýring	Br.