




GRUNNMYND 1:50

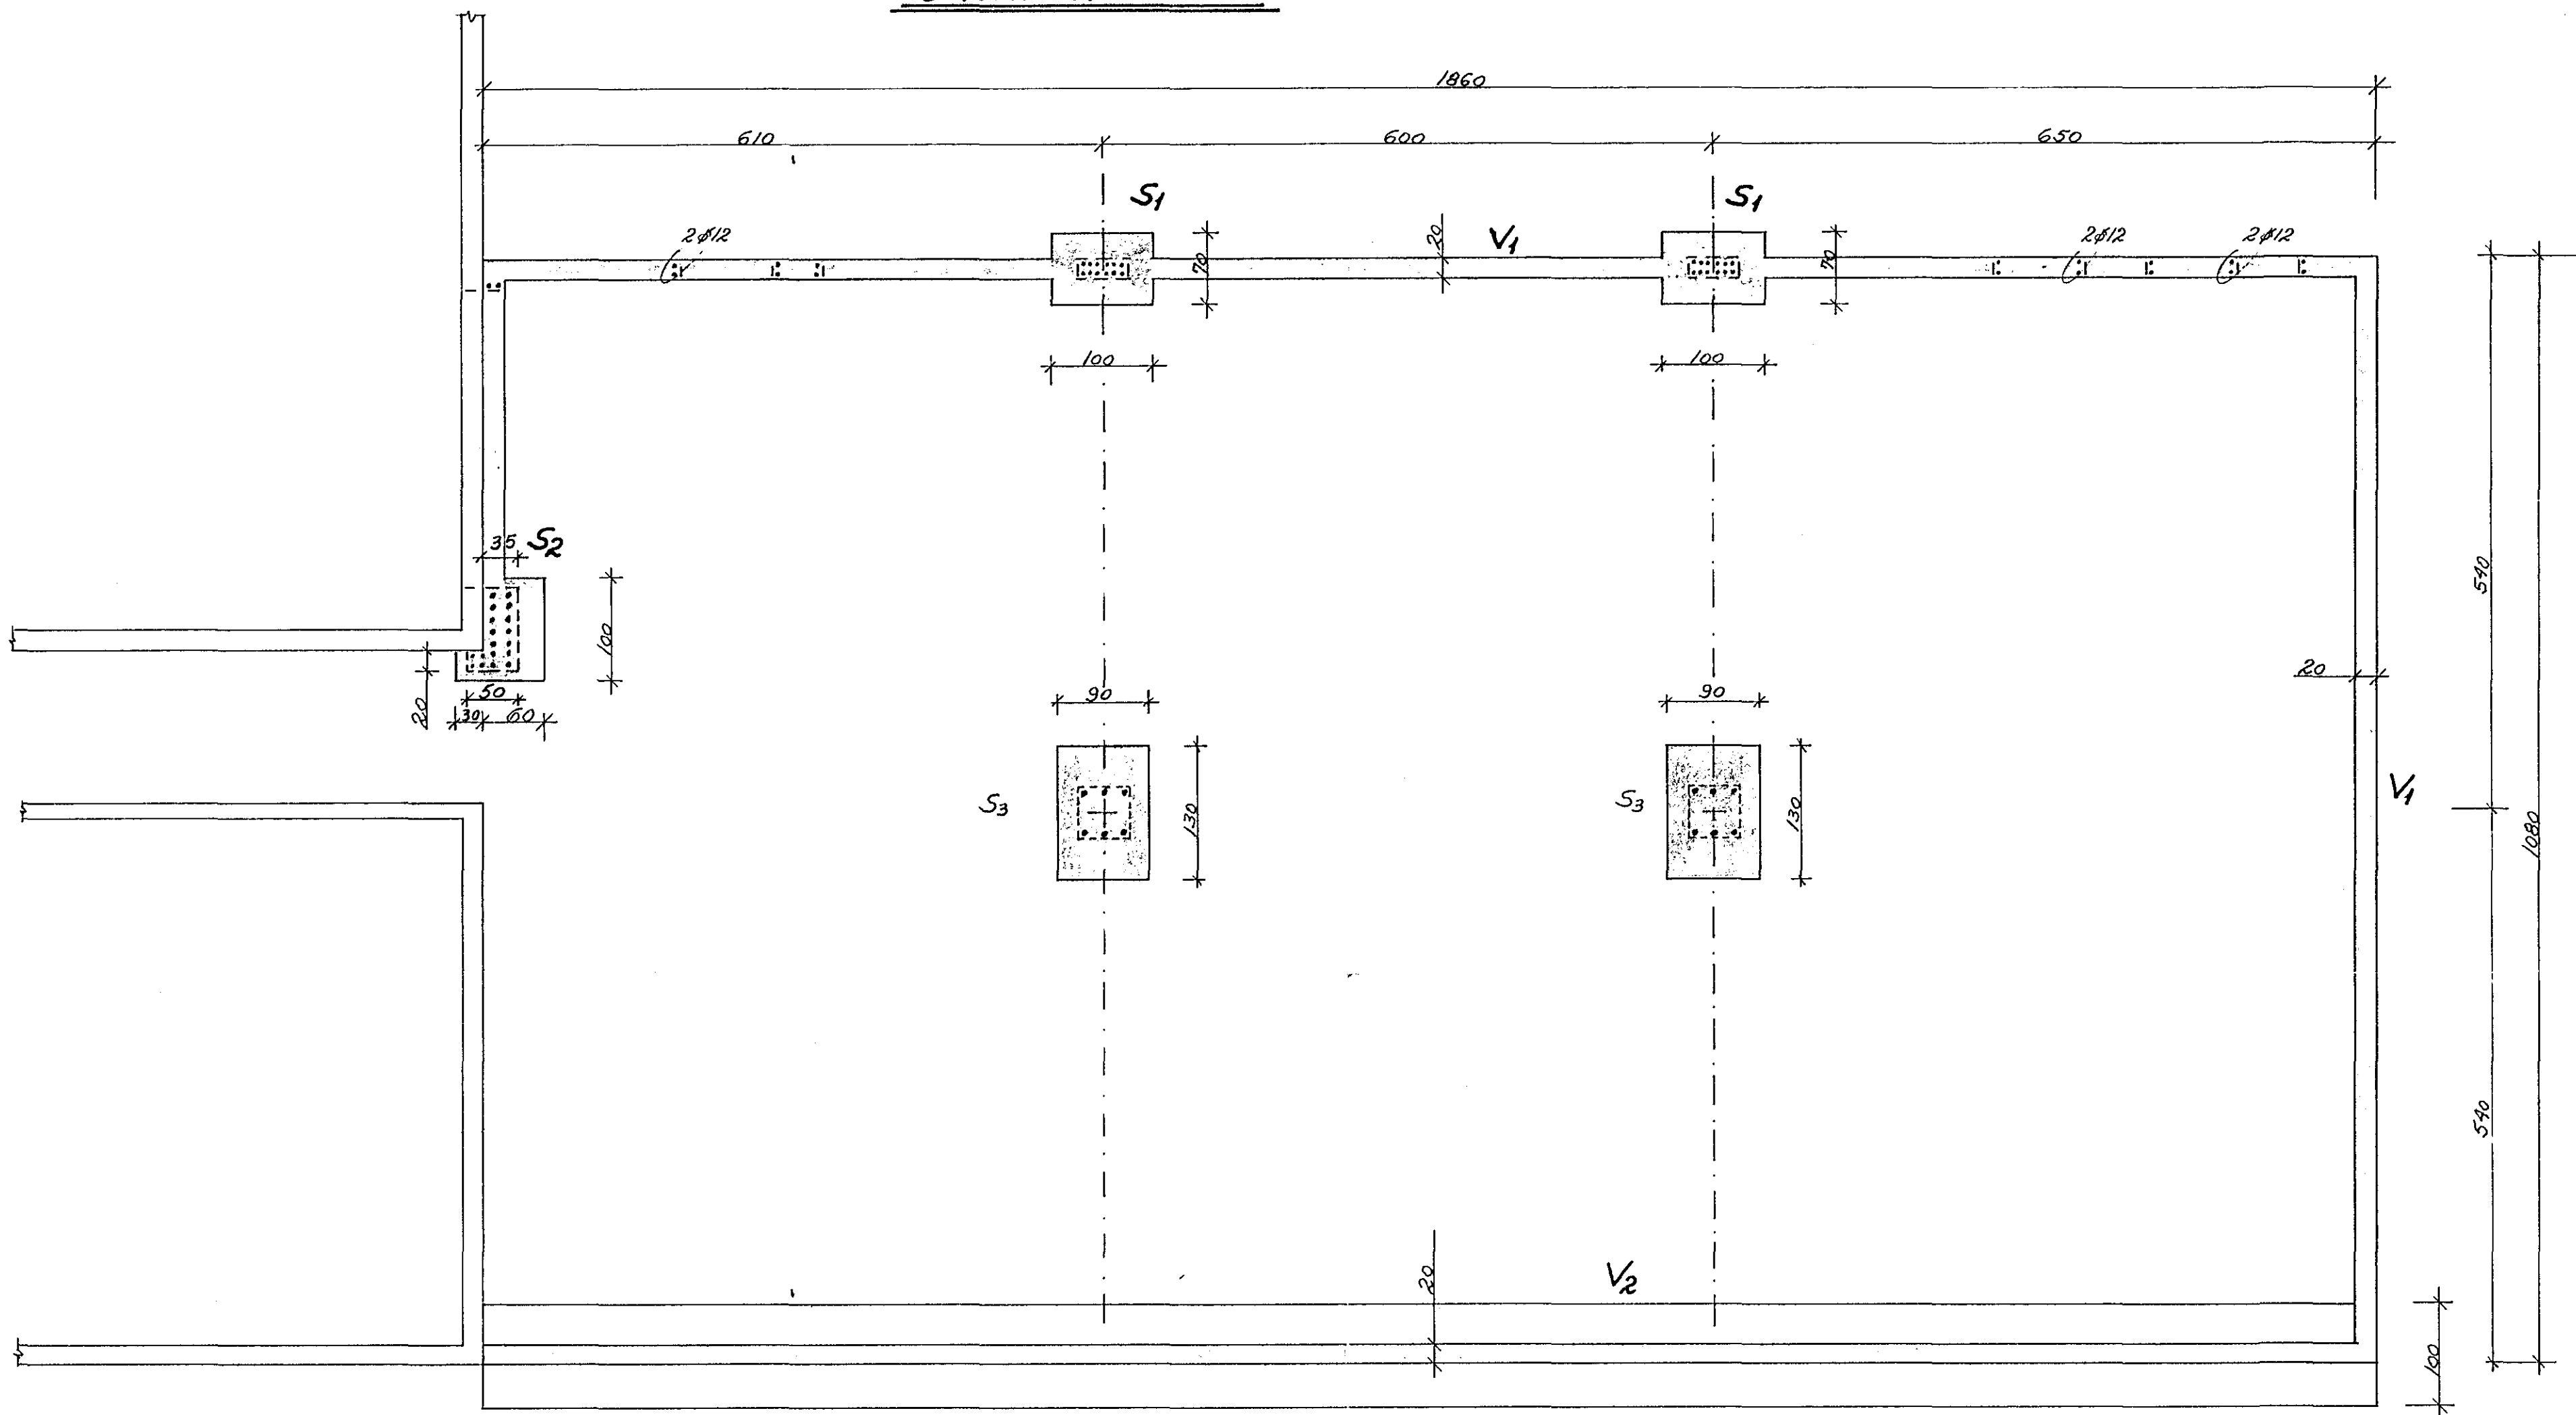

UNDIRSTÖÐUR SÚLNA S3, GRUNNMYND OG SNID 1:20

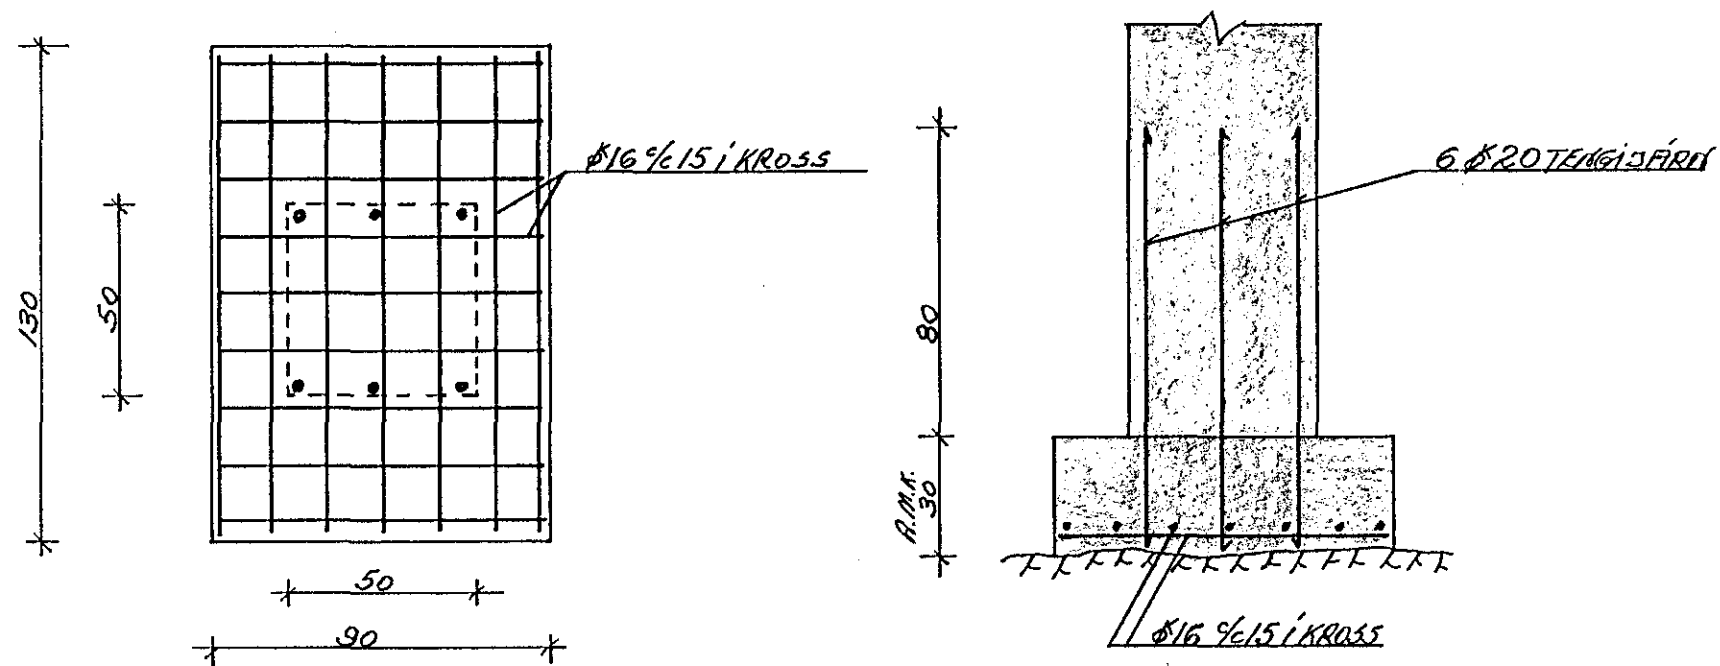

ÖNNUR SNID OG SKÝRINGAR
SJÁ TEIKN. NR. 1.2.

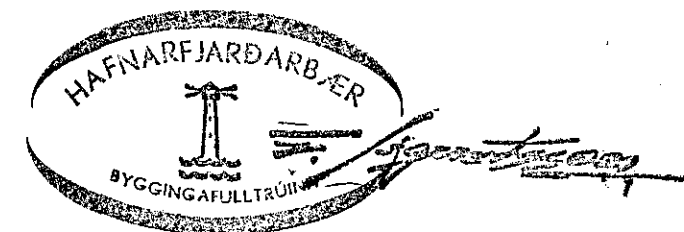

Breytt í des '79
H.V.

REYKJAVÍKURV. 64 HAFNARFIRÐI	VERK	BL. NR.
	H:79-2	1.1.
VIÐBYGGING UNDIRSTÖÐUR GRUNNMYND	HAFNARF. OKT. '79	
	MKV. 1:50	REIKNINGAR TEIKNINGAR
HALLDÓR HANNESSON BYGG. VERKFR. GUNNARSSUNDI 10 HAFN. S. 53423		