


Skýting á lundibýggingu
 29.4.1985
 ÚTGAFA
 I HAFNARFIRÐI
 E. Sigurðsson

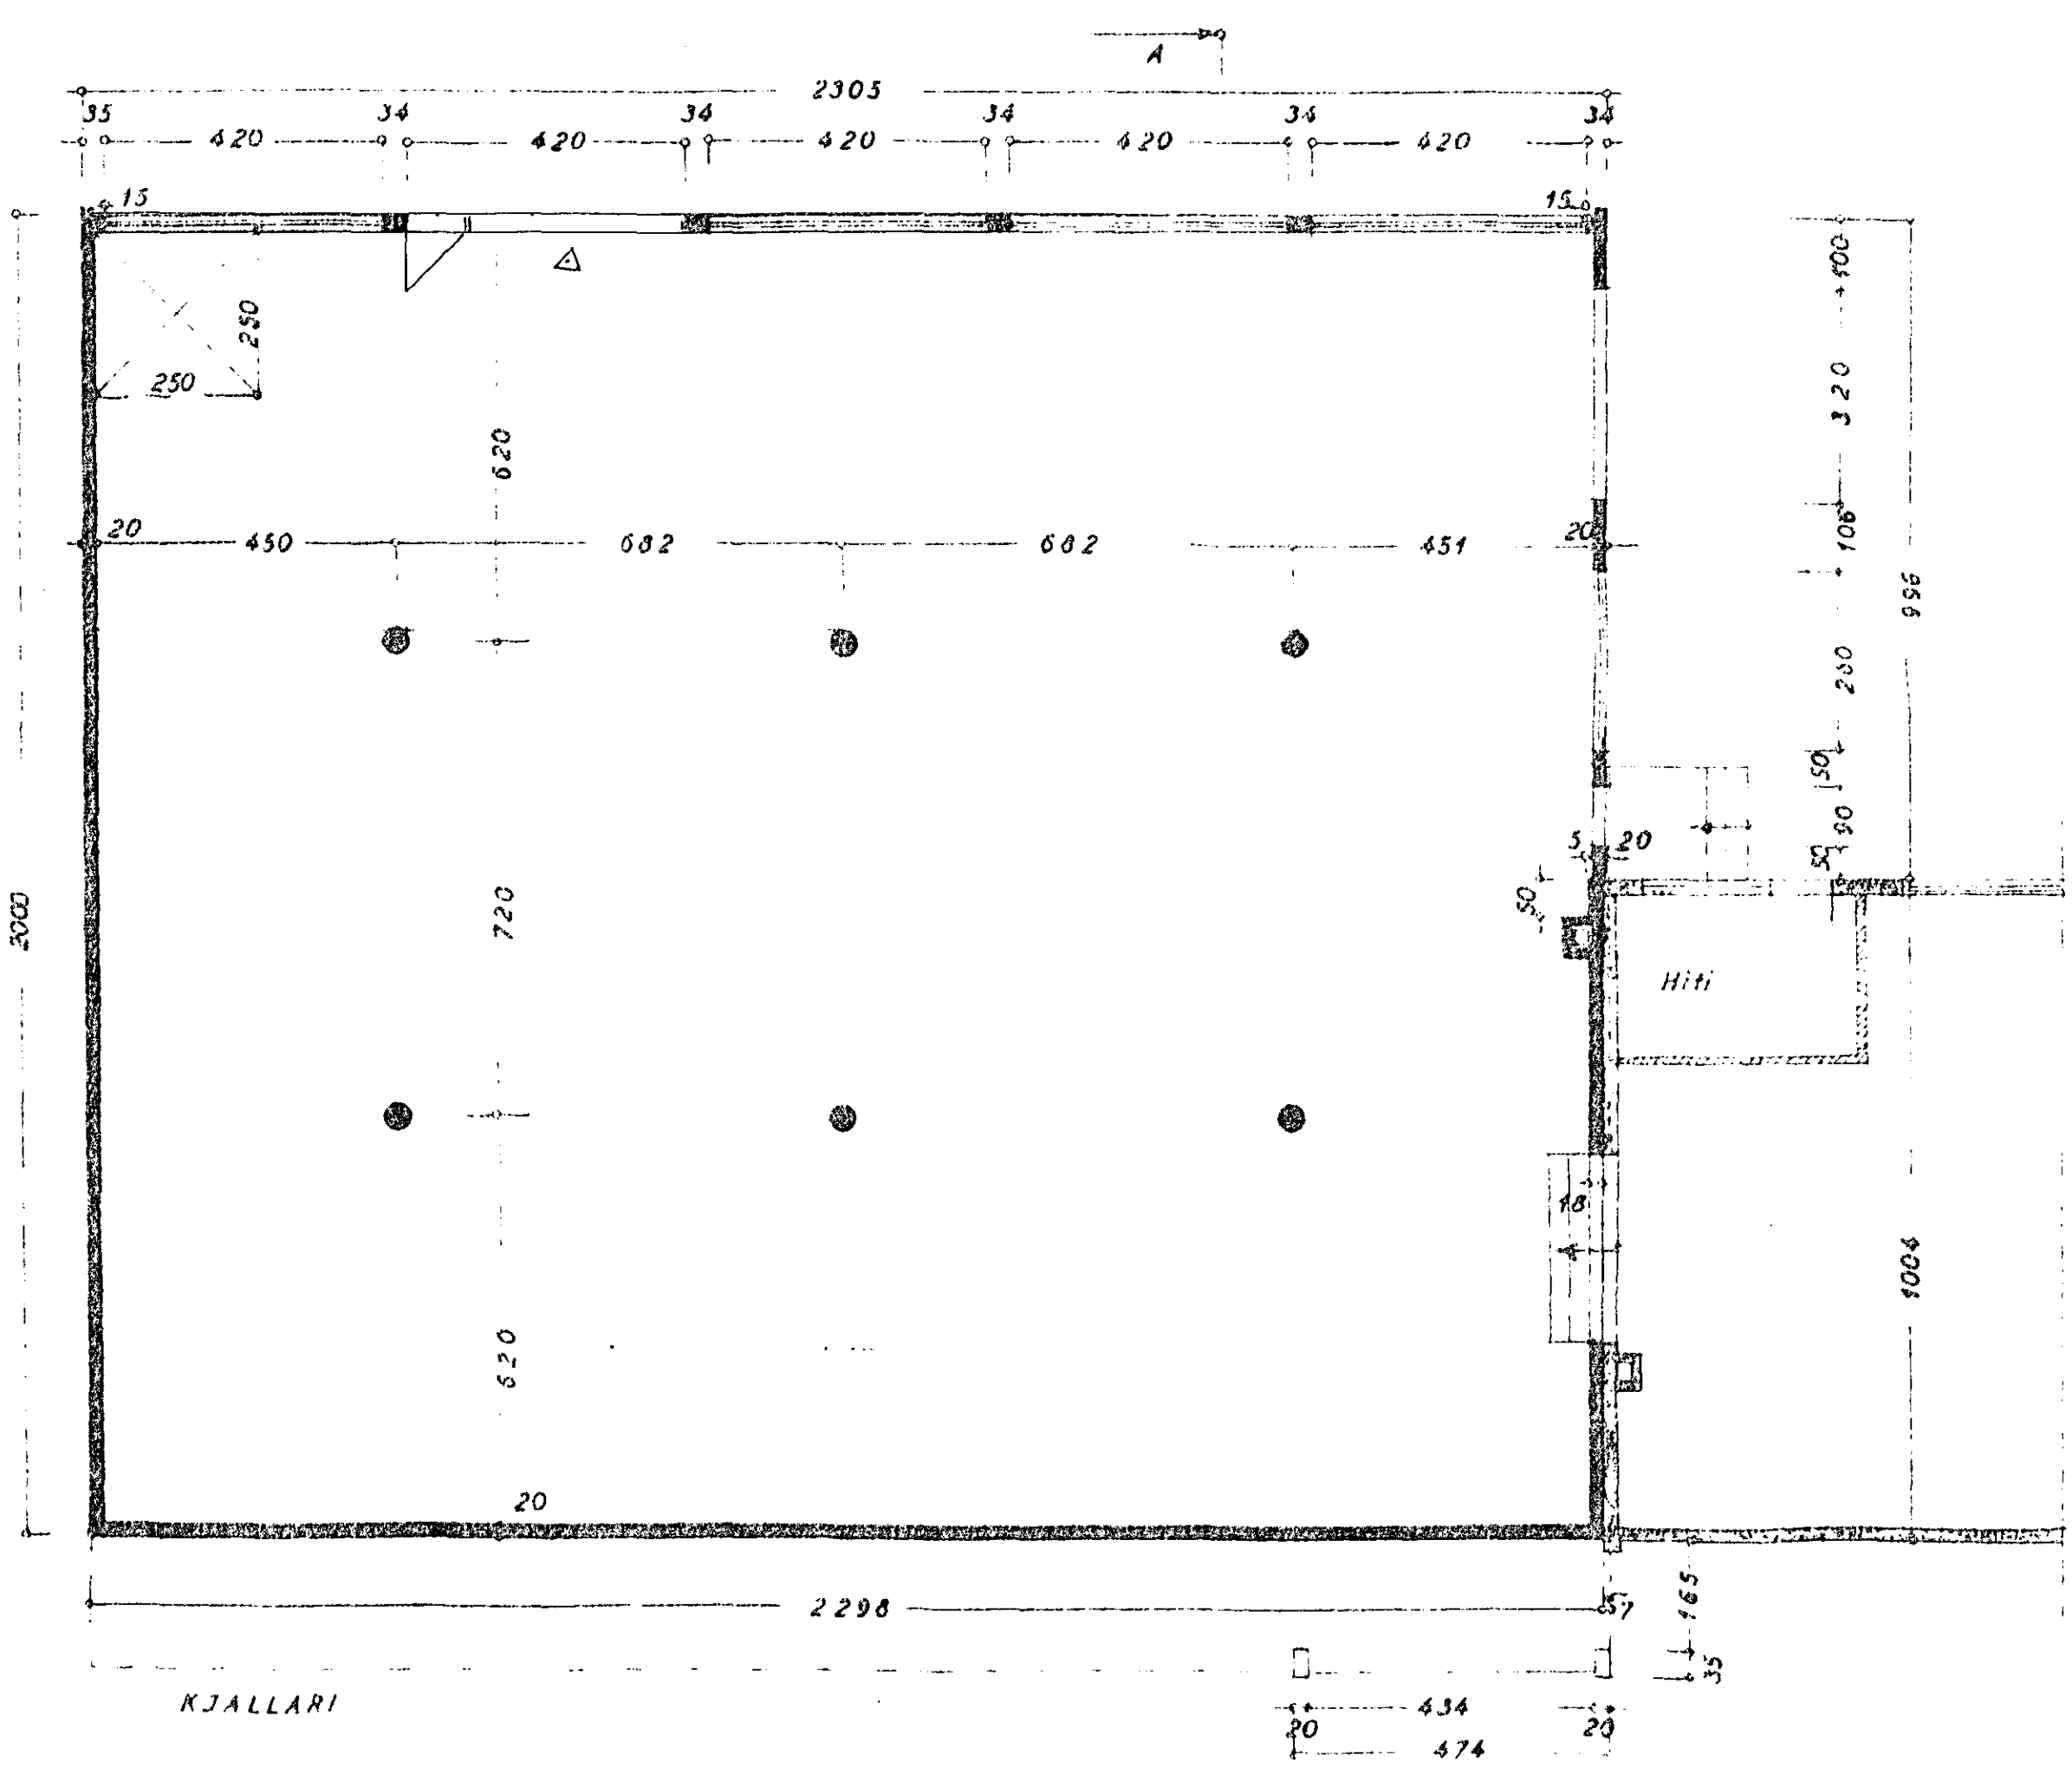

REYKJAVÍKURVEGUR 64
 Δ Breyting
 Hafnarfirdi 3 apríl '85
 E. Sigurðsson

KJALLARI