


Sandberg  
24/4 85  
/Sigurdsson

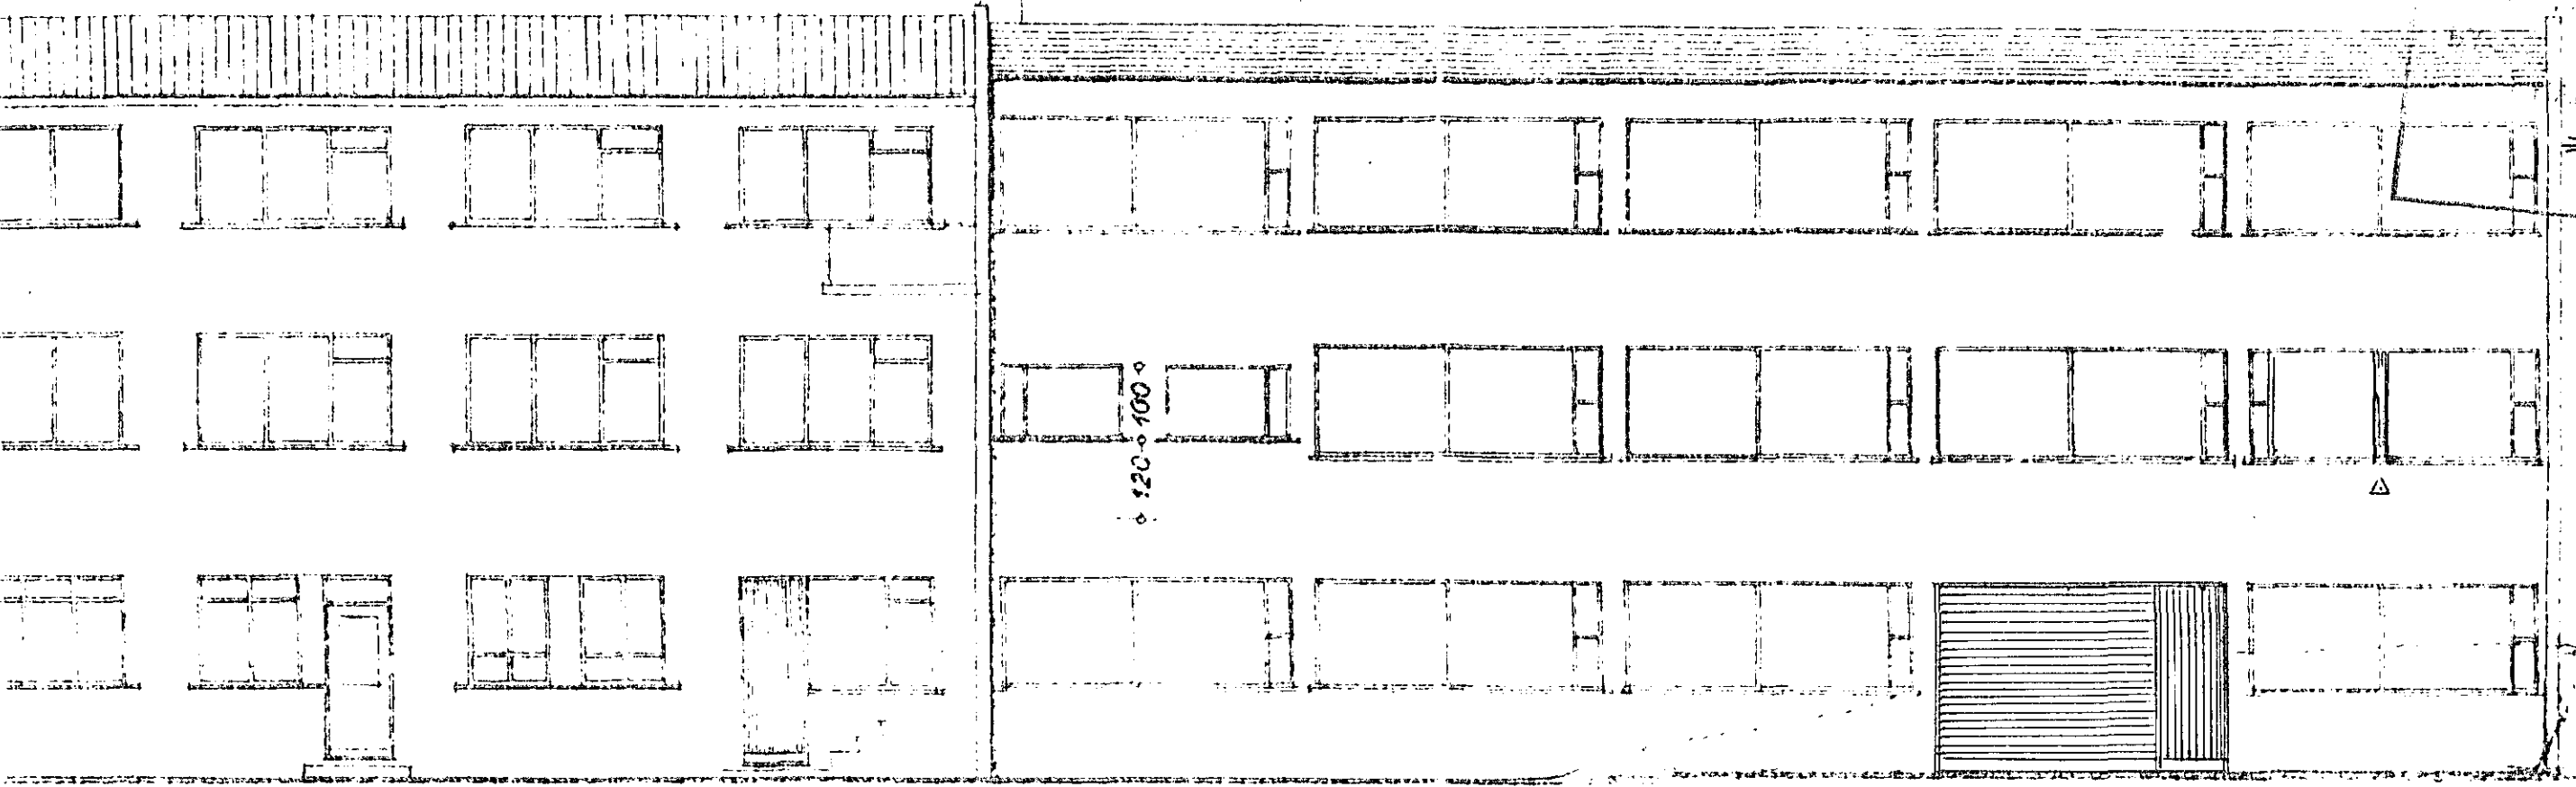


△ AUSTUR

REYKJAVÍKURVEGUR 64

△ Breyting.

Hafnarfirdi í apríl '85

/Sigurdsson

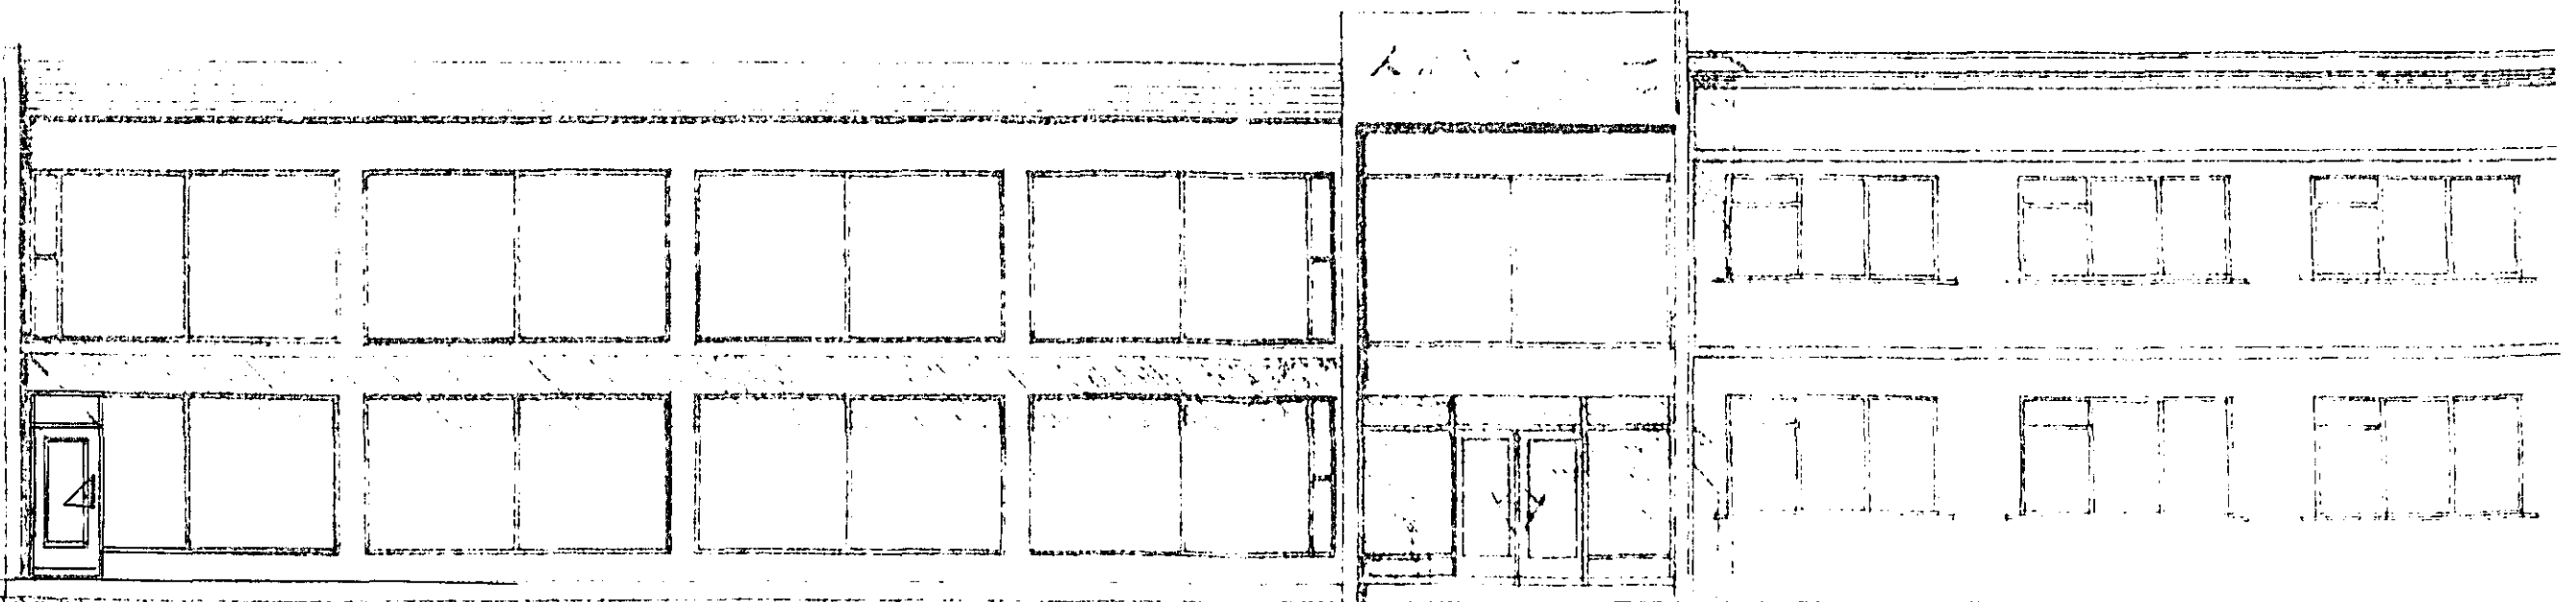

VESTUR