




A-A 1:20

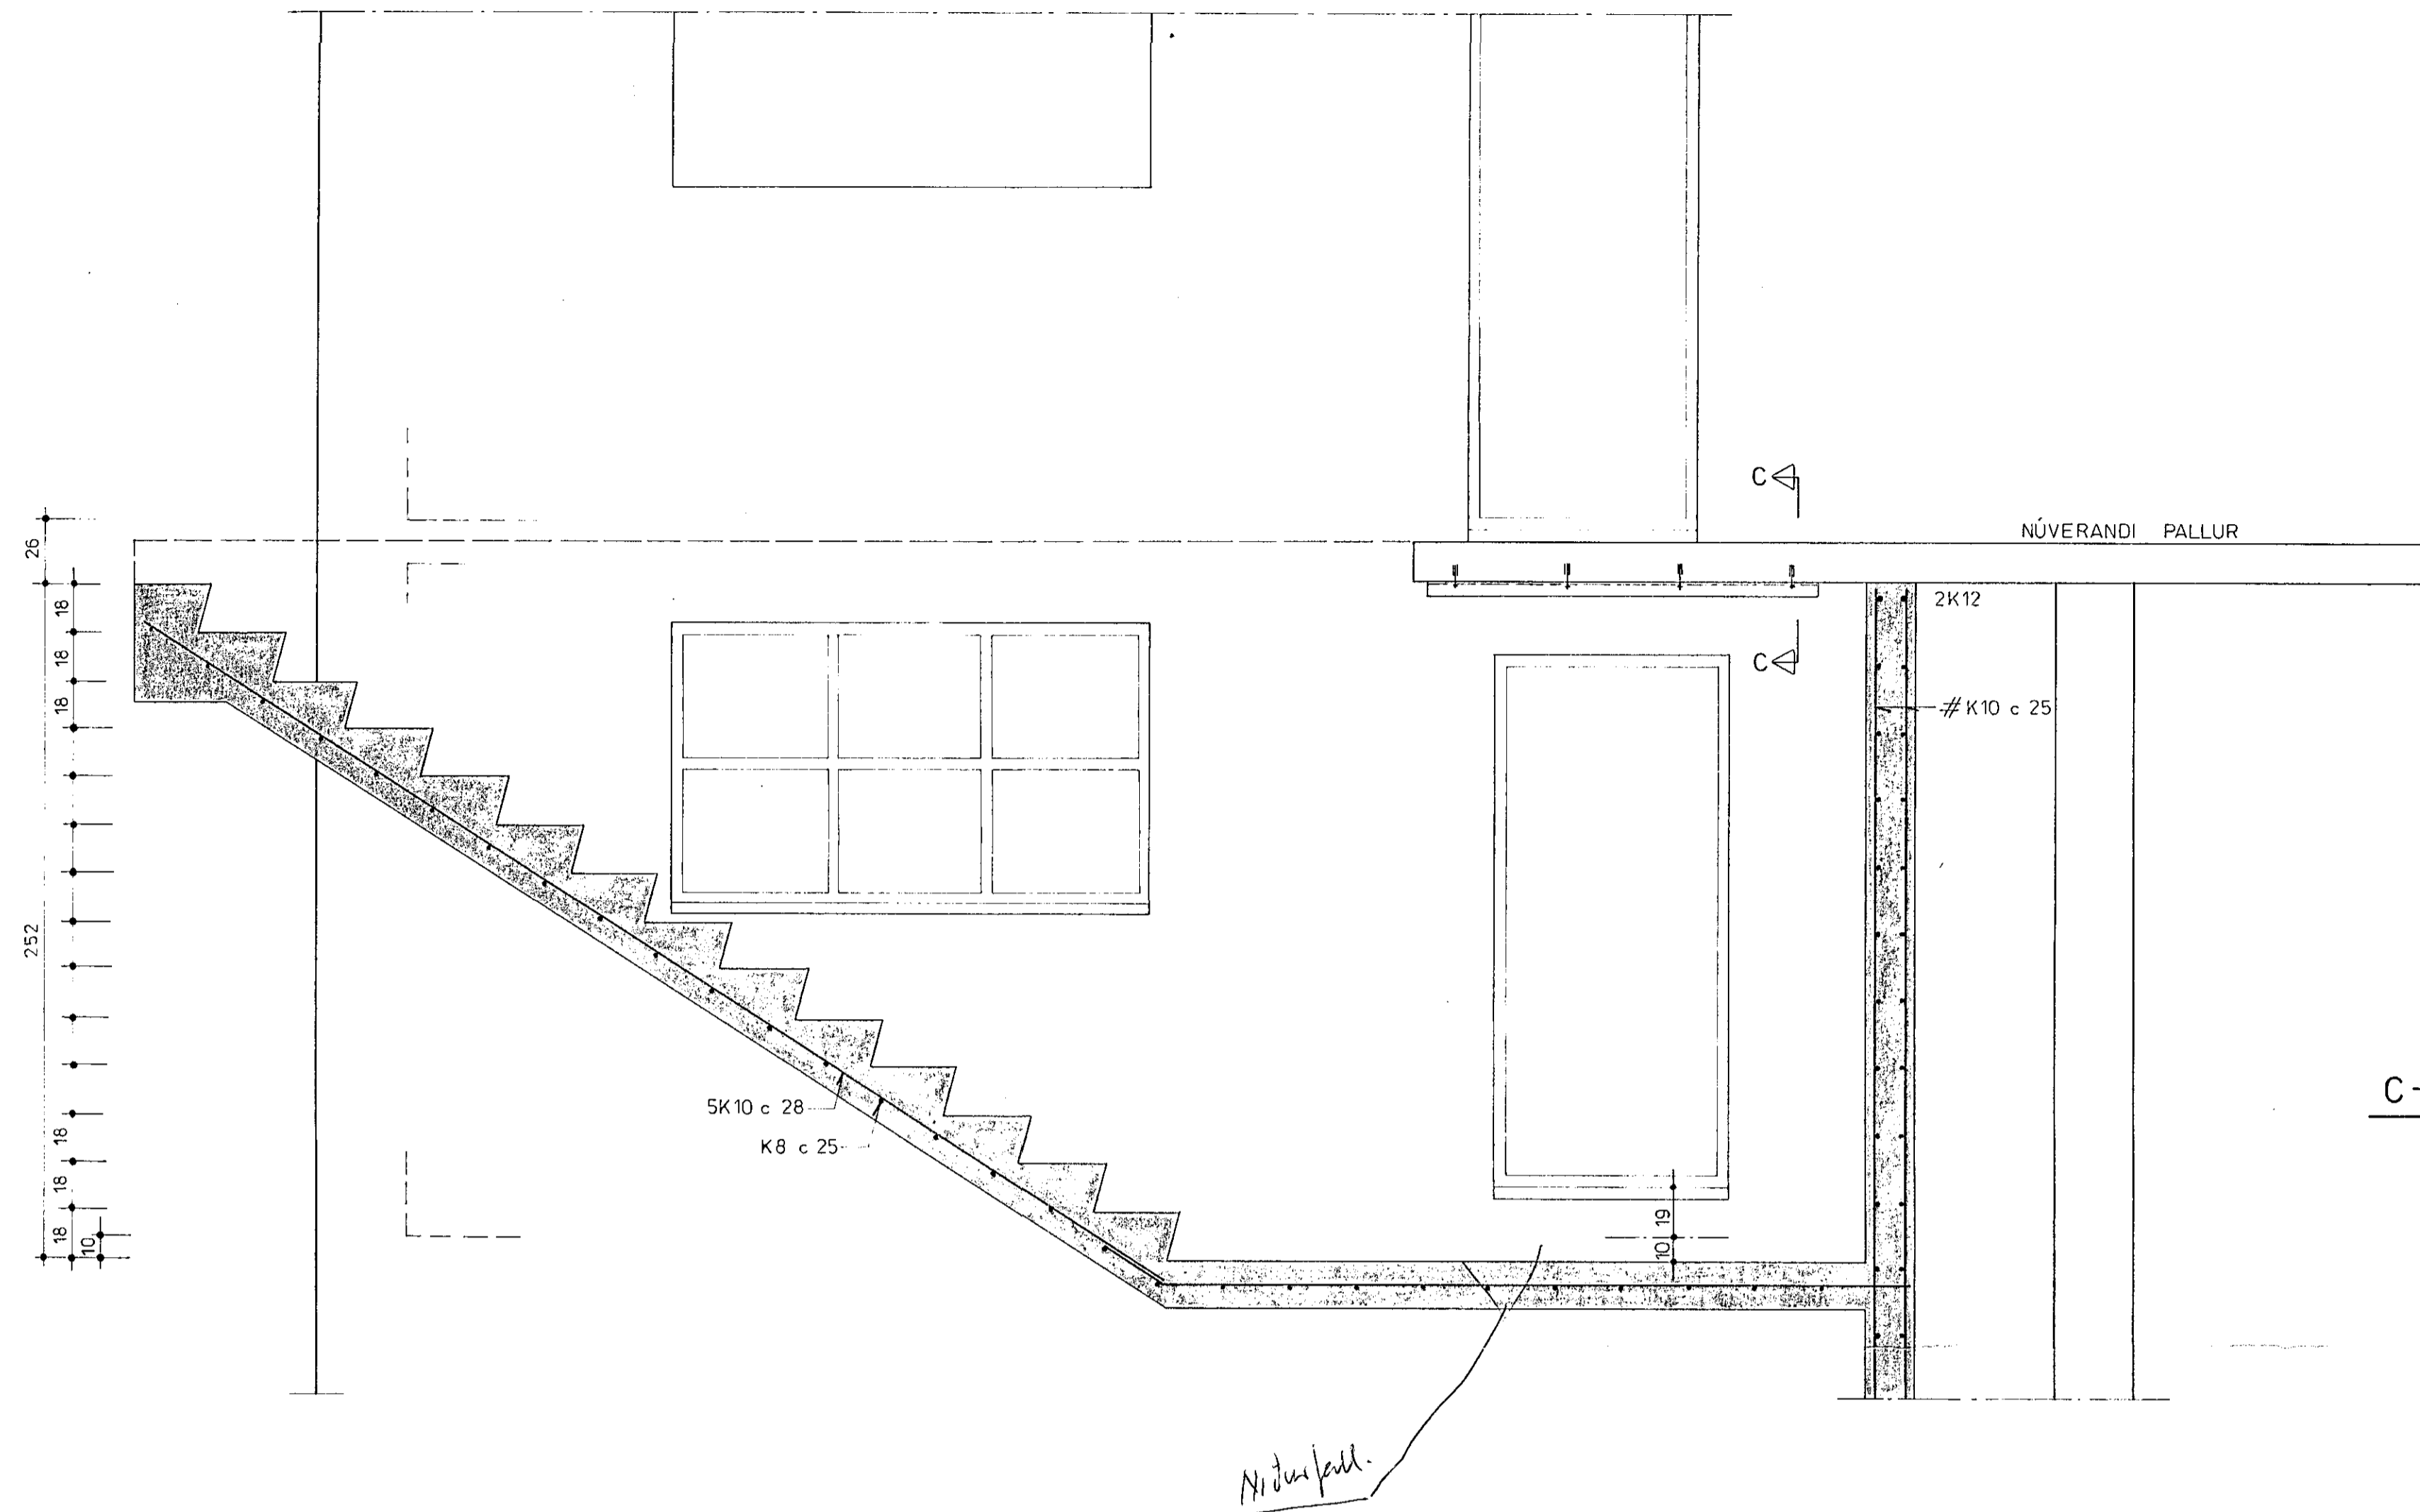




B-B 1:20

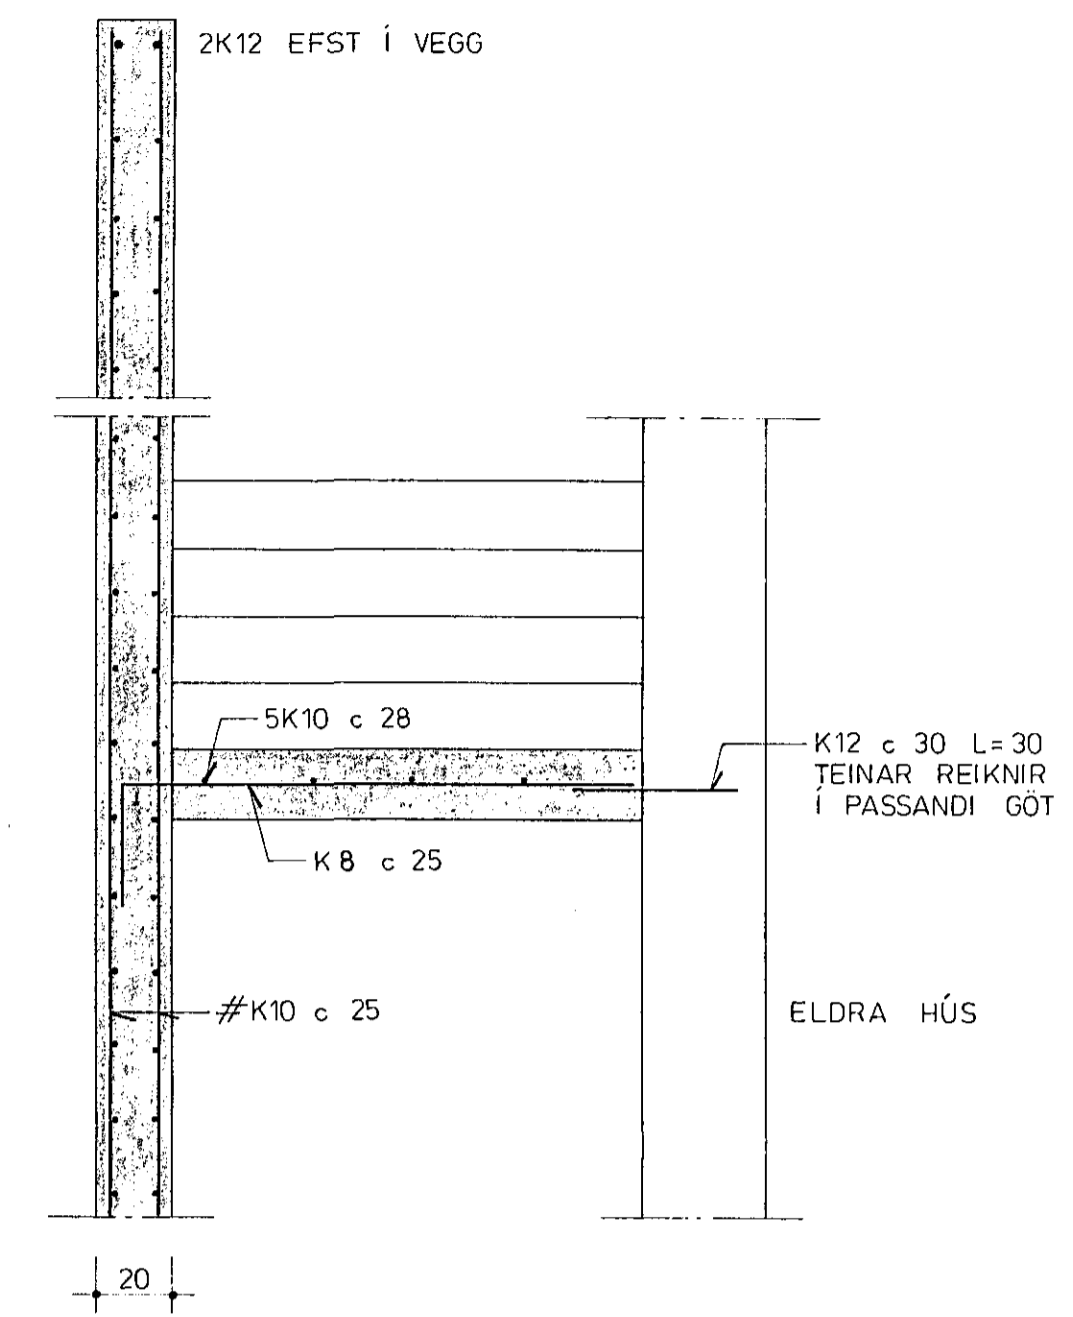

1 1:20

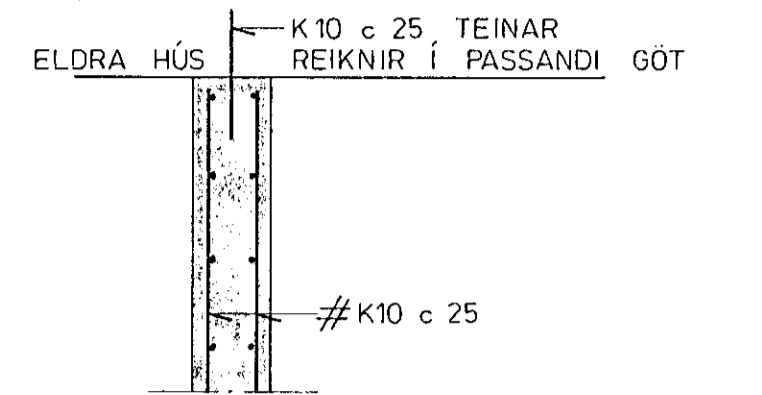

C-C 1:20

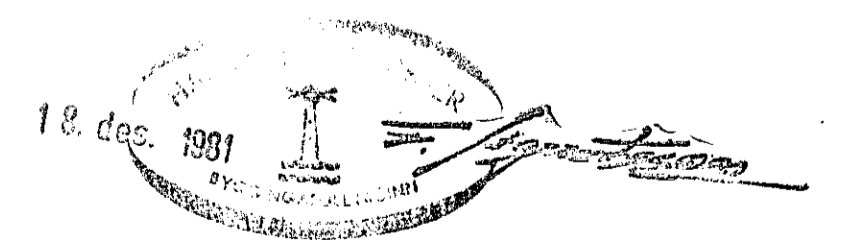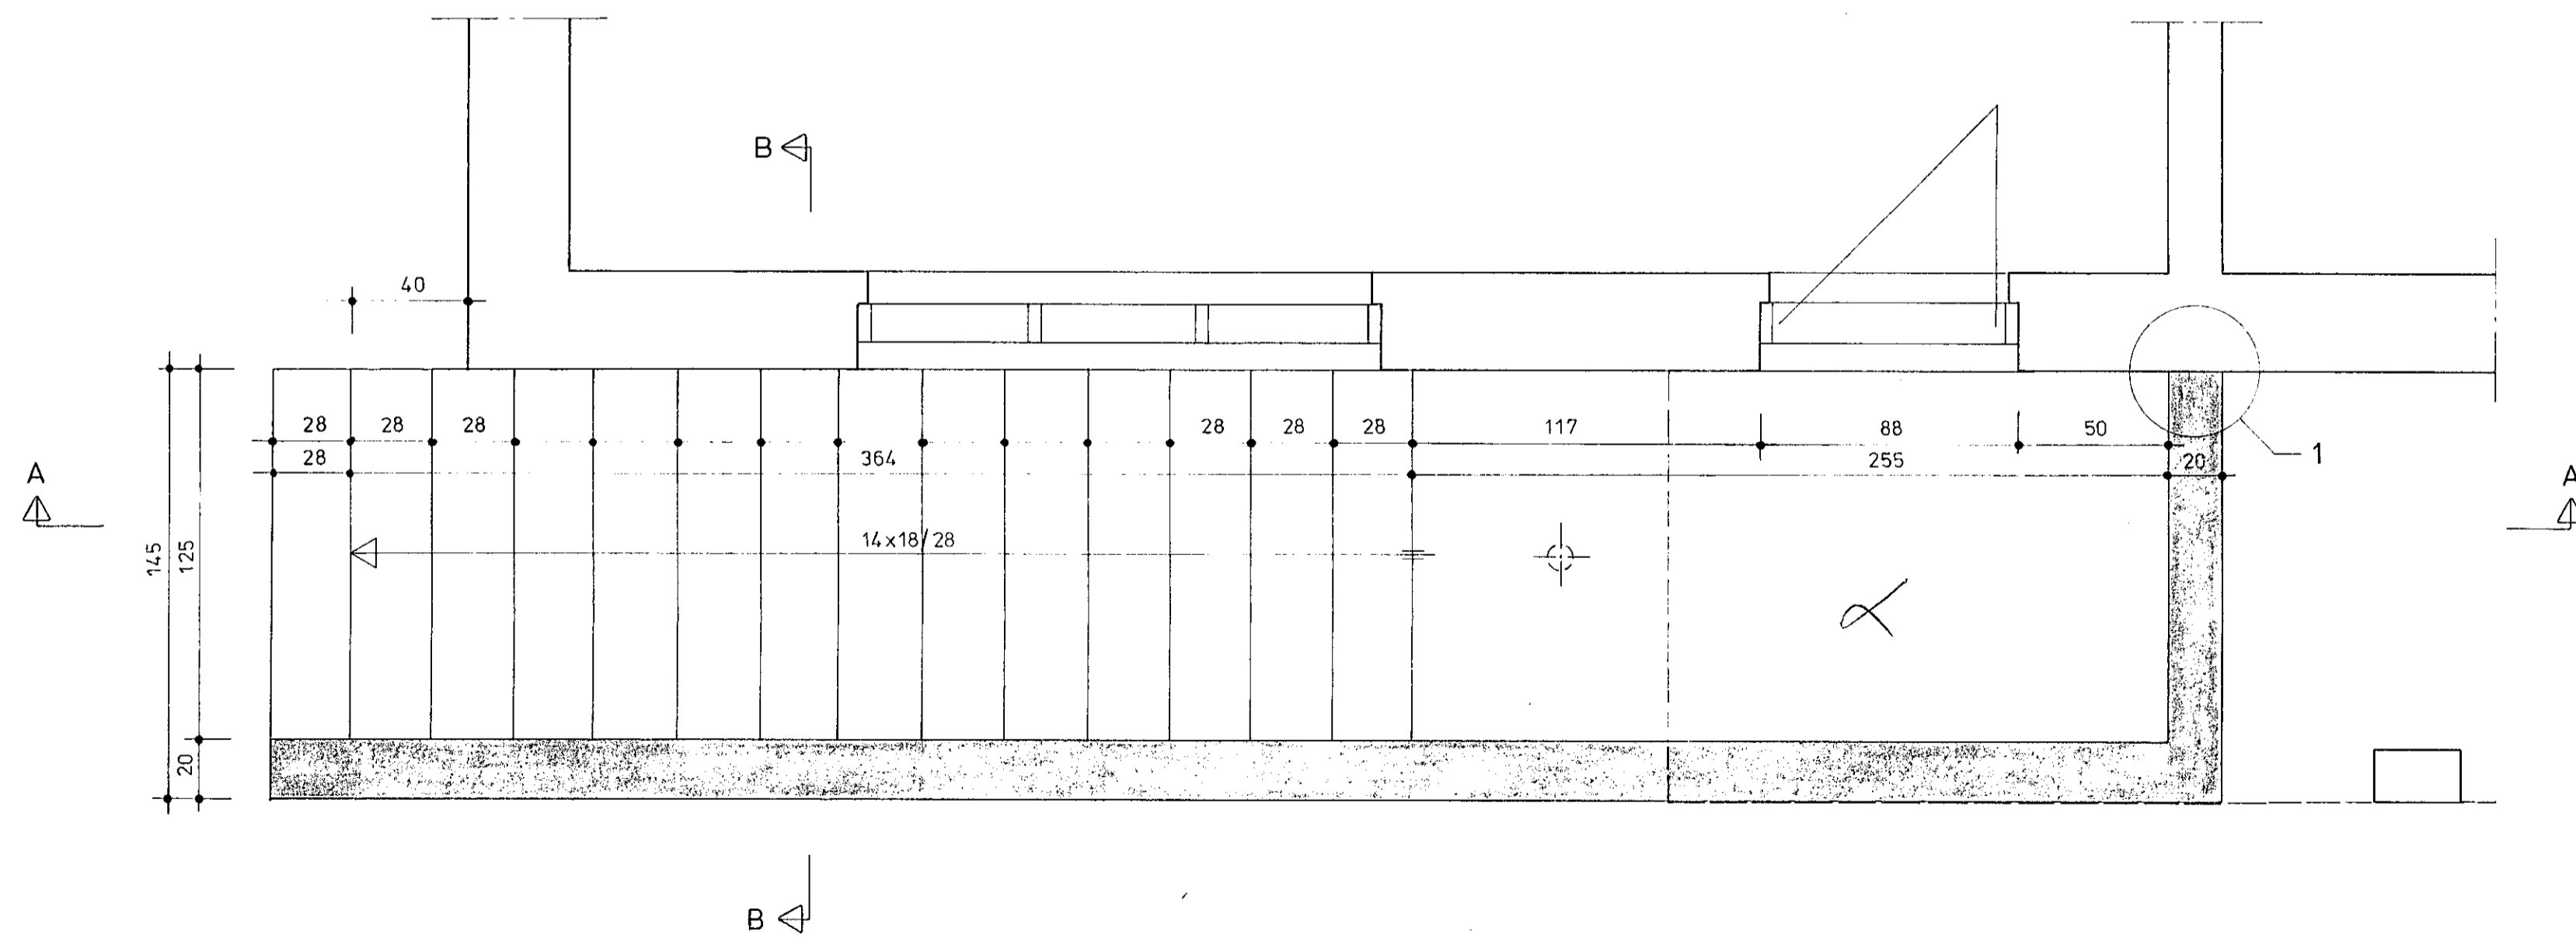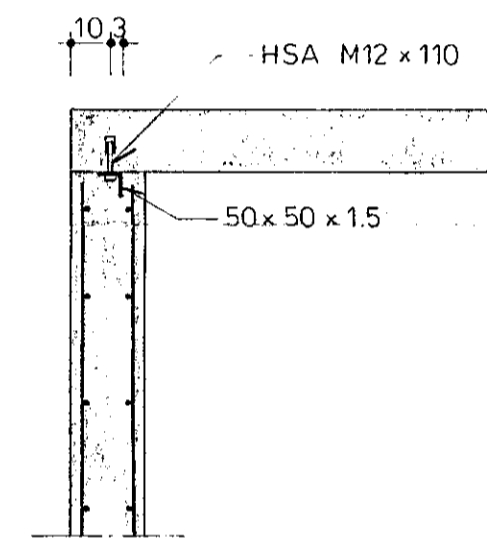

VINNUSTOFAN KLÖPP HF
 ARKITEKTAR-VERKFRÆÐINGAR
 Laugavegi 26 - Pósthólf 76B
 121 Reykjavík - Sími 27777

PHARMACO HF REYKJAVÍKURVEGI 78 HAFN	VERK NÚM. 81-502
HÚS 1	TEIÐING NÚM. B 02
STIGI VÍÐ NORÐURGAFL	
PROJ. HVS, PIG	GRD
DRÖG 81.12.11	KV. 1 20