



GRUNNMYND - HÆÐAR 1:50

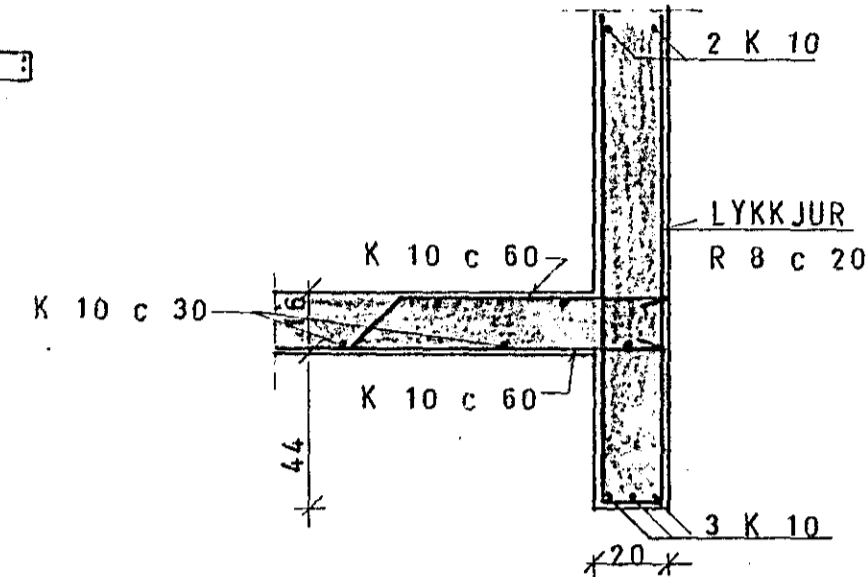


SNID A 1:20

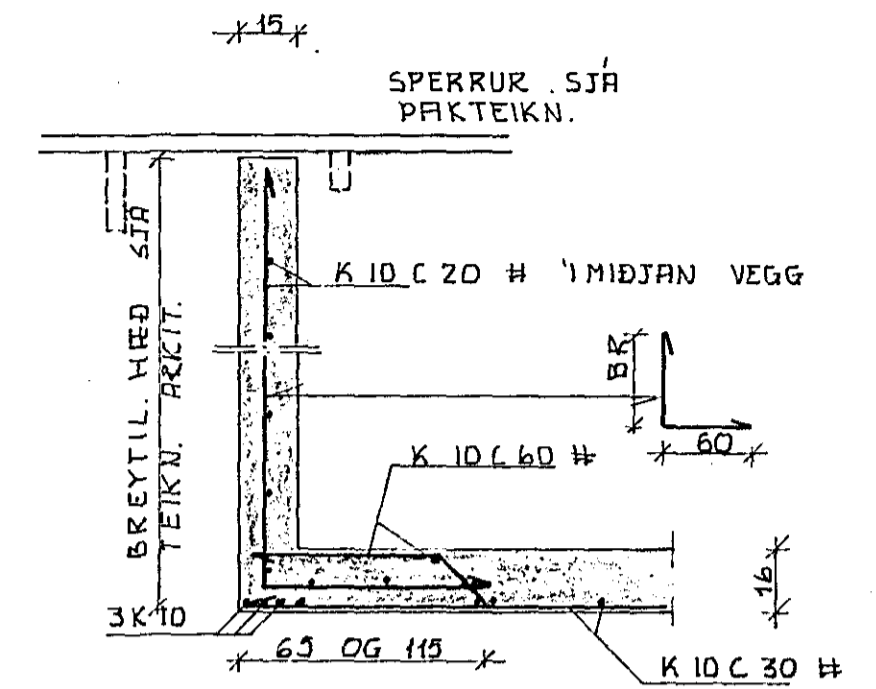


SNID B 1:20

EINFÖLD GRIND 'I MIDJUM VEGG K 10 c 25 #

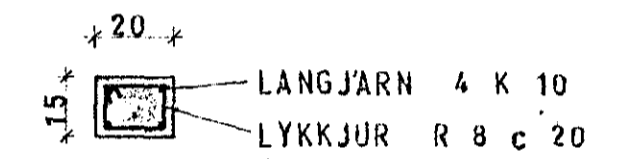

SÚLA S 1 1:20

YFIR GLUGGUM KONI BITI EINS OG 'I SNIDI A

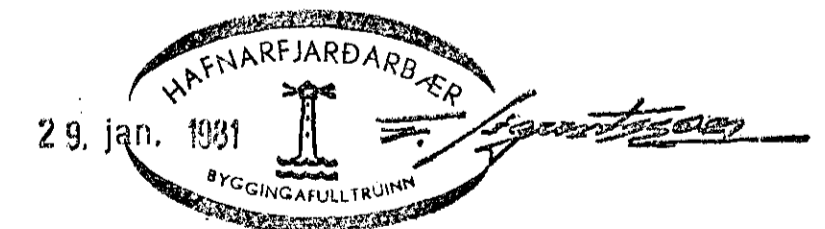

SKÝRINGAR SJA TEIKN. NR. 10.

HÚS C I

BREYTING, SLEPPT STEYPTRI PLÖTU YFIR STOFU

TÚNHVAMMUR 12	MÆLIKVARDI 1:50 1:20	VERK 8001	TEIKN NR 1.3
PLATA YFIR 1.HÆÐ	Hannað Teiknað: <i>dw.</i>	Yfirfarið: Samb:	DAGS JÚN: '80
JÓHANN GUNNAR BERGPÓRSSON VERKFR MVFI STRANDGÖTU 11 - HAFNARFIRÐI - Sími 53315	BREYTT 29. 81. 83.		