
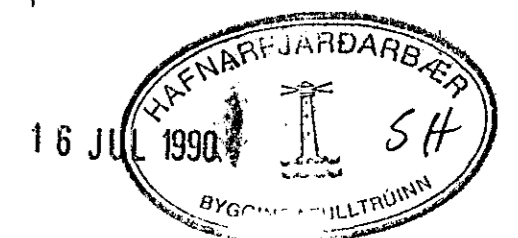
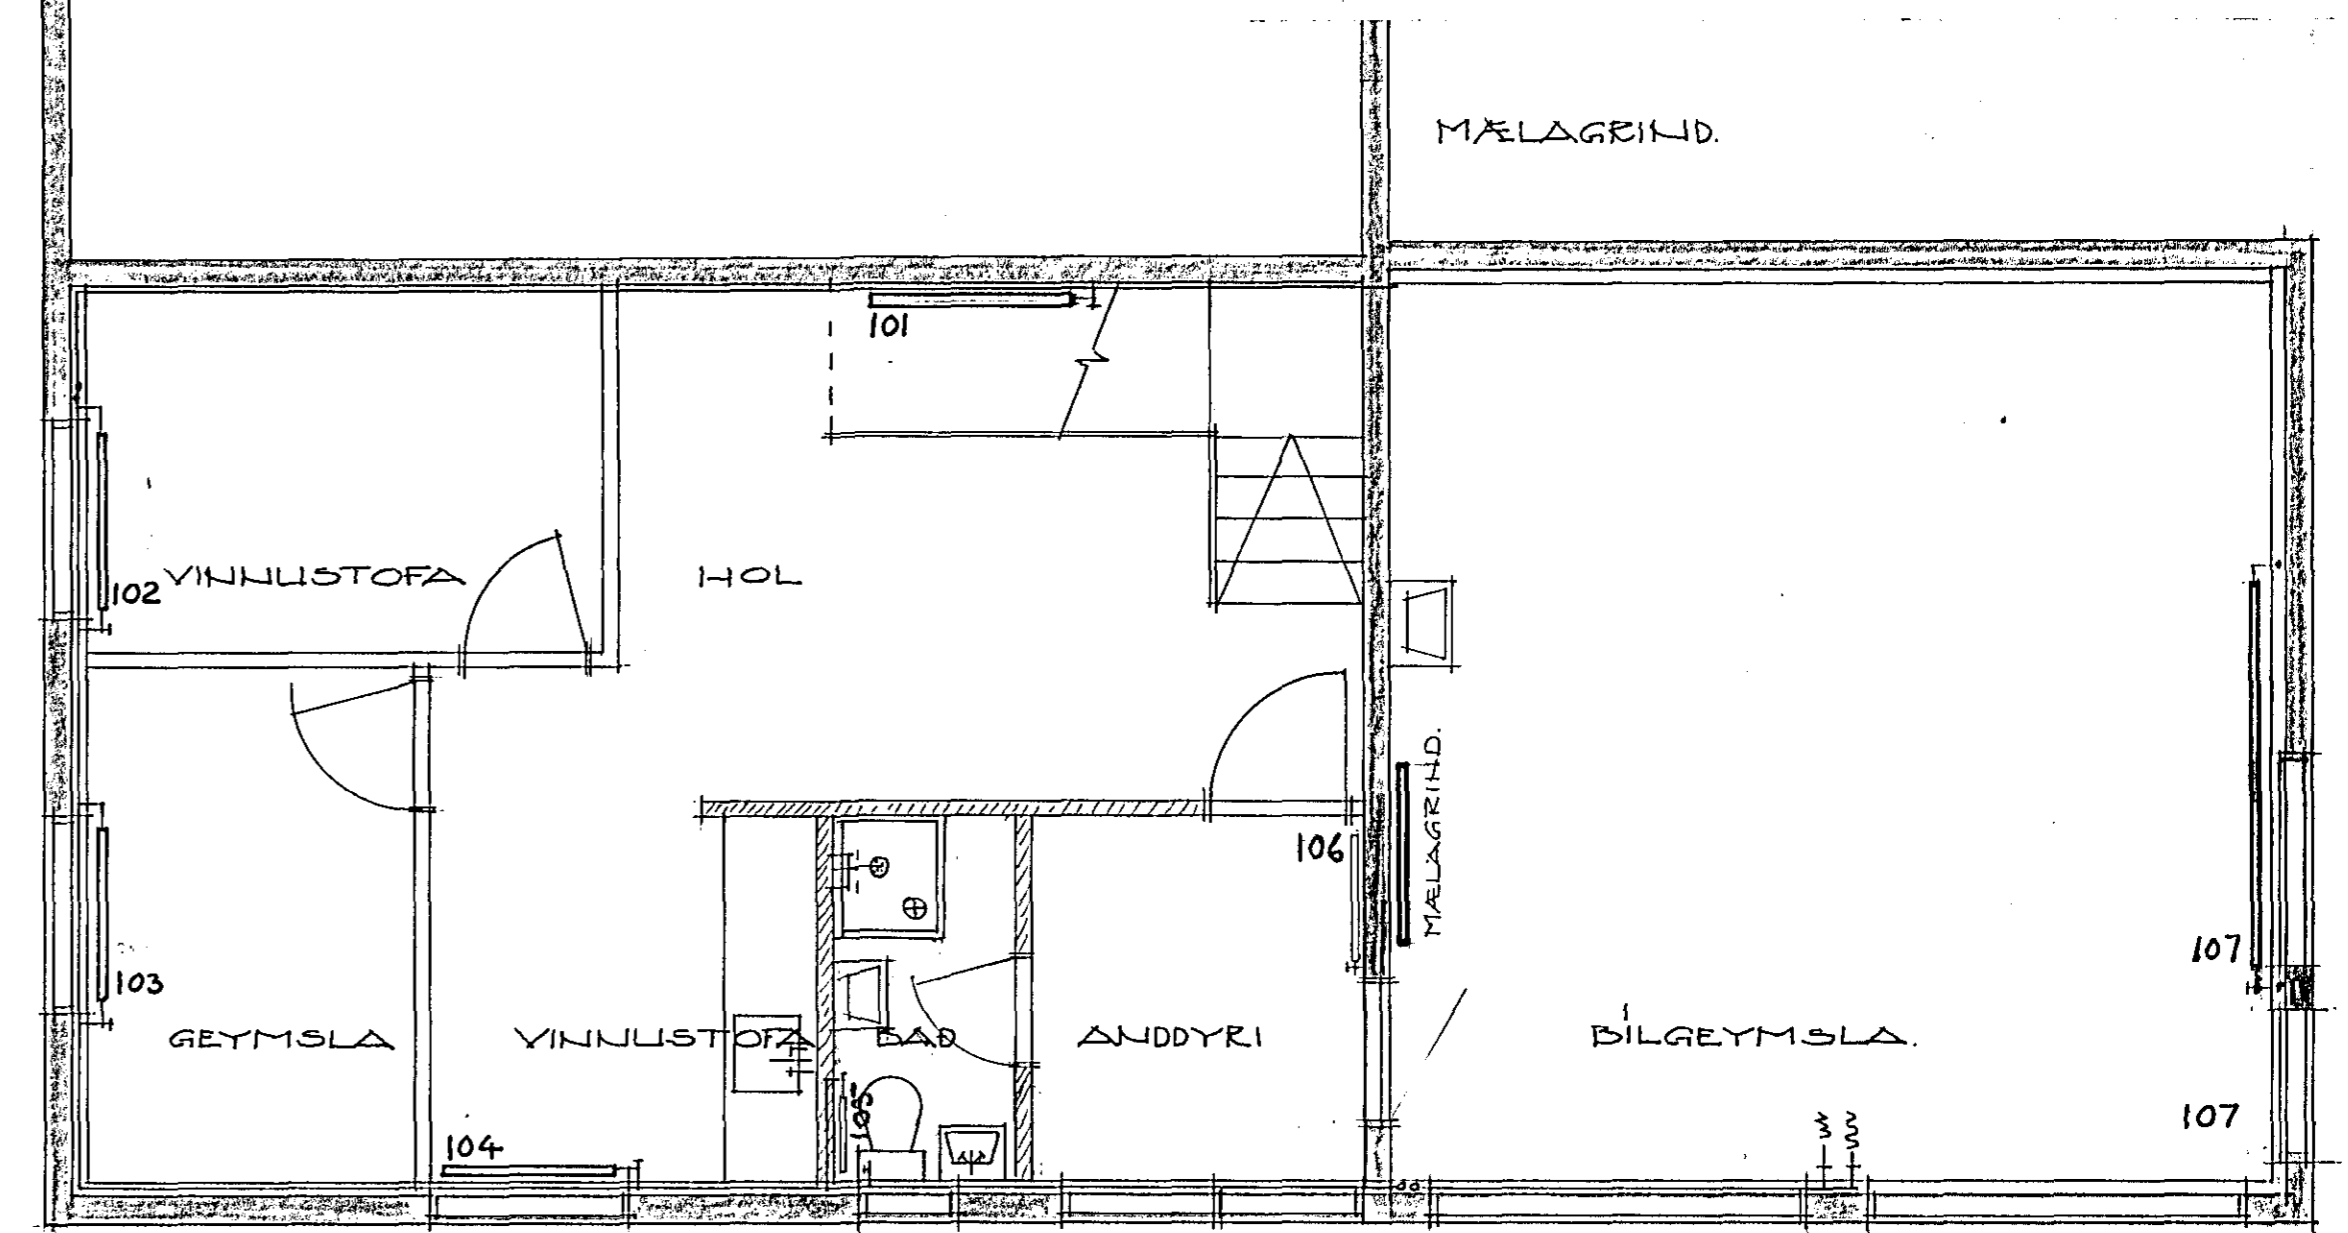


OFN NR.	KCAL ORKUDRÖF	VALINN OFN.		
101	1600			
102	700			
103	800			
104	600			
105	400			
106	700			
107	2000			
201	1300			
202	900			
203	300			
204	1000			
205	400			
206	1300			
207	1000			
208	1000			
209	500			
210	1000			
211	900			
212	900			
213	1500			
214	1300			
SAMT. 20900 kcal.				

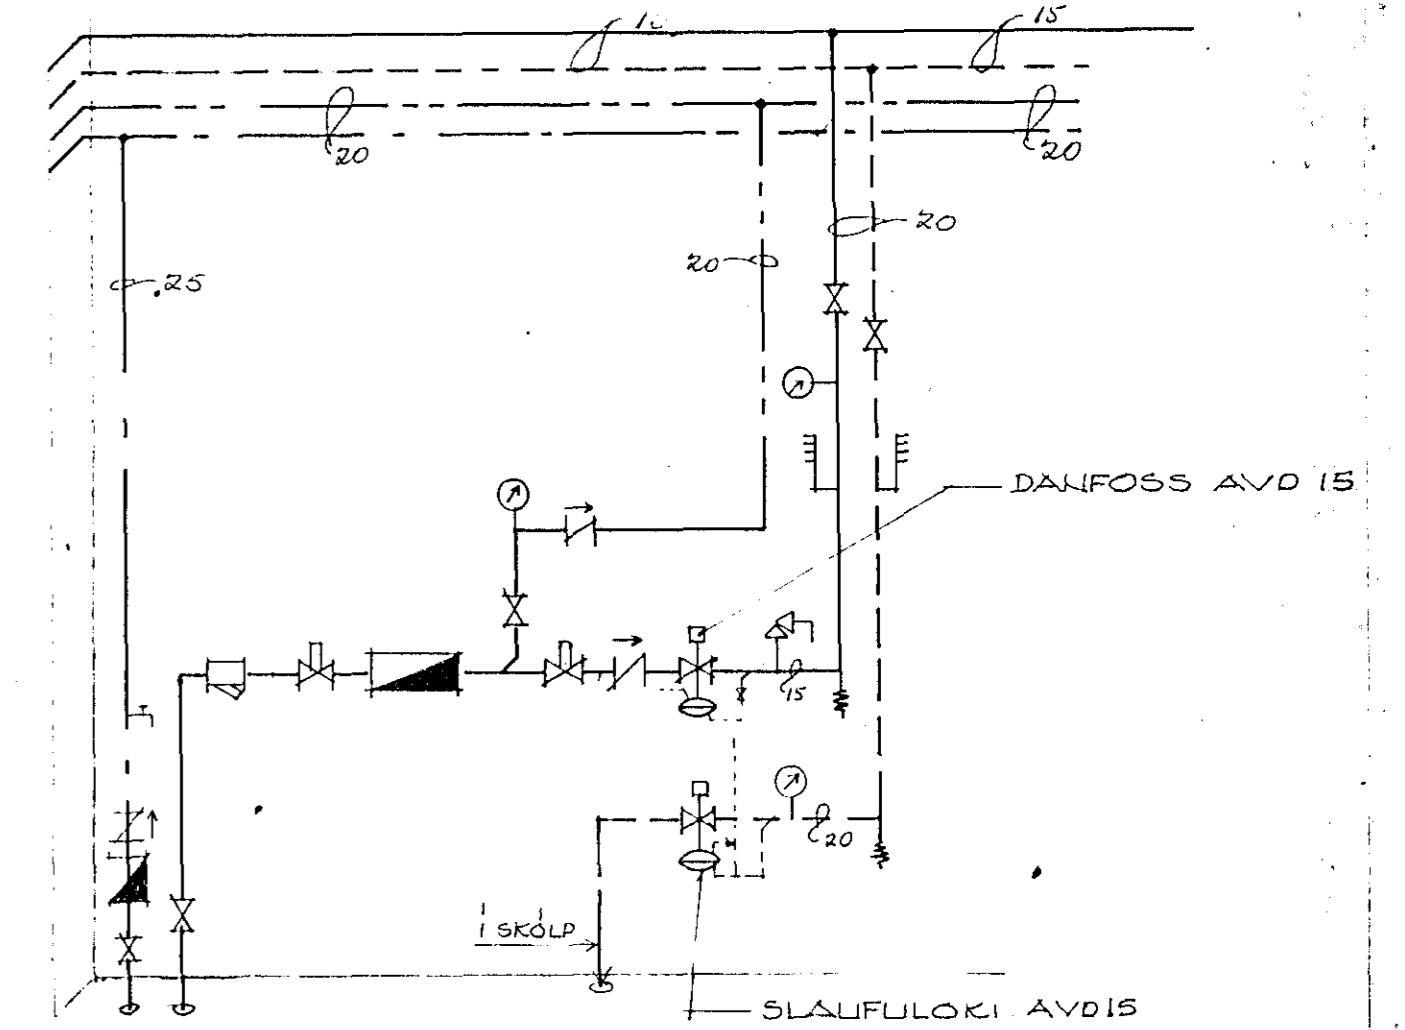

Breyting 16.07.1990.

MÆLAGRIND FÆRÐ, OFURR 105 OG 106 FÆRÐIR.		JAN 190
BREYTING	DAGS.	GERT AF
<b>LÆKJARBERG 4 HAFNARFIRÐI</b>		
ÁRMANN JÓHANNESSON BYGGINGAVERKFRÆÐINGUR	HITAL OG VATNSLAGNIR	
BALDVIN EINARSSON BYGGINGAFRÆÐINGUR		
relkn.	ylfr f.	mkv: 1:50
telkn. <i>BM</i>	samb.	dags. FEB '89
	verk nr.	blað af.