
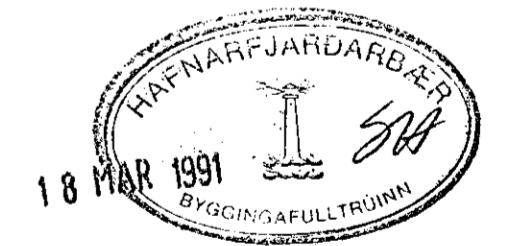


GRUNNMÝND 1:50

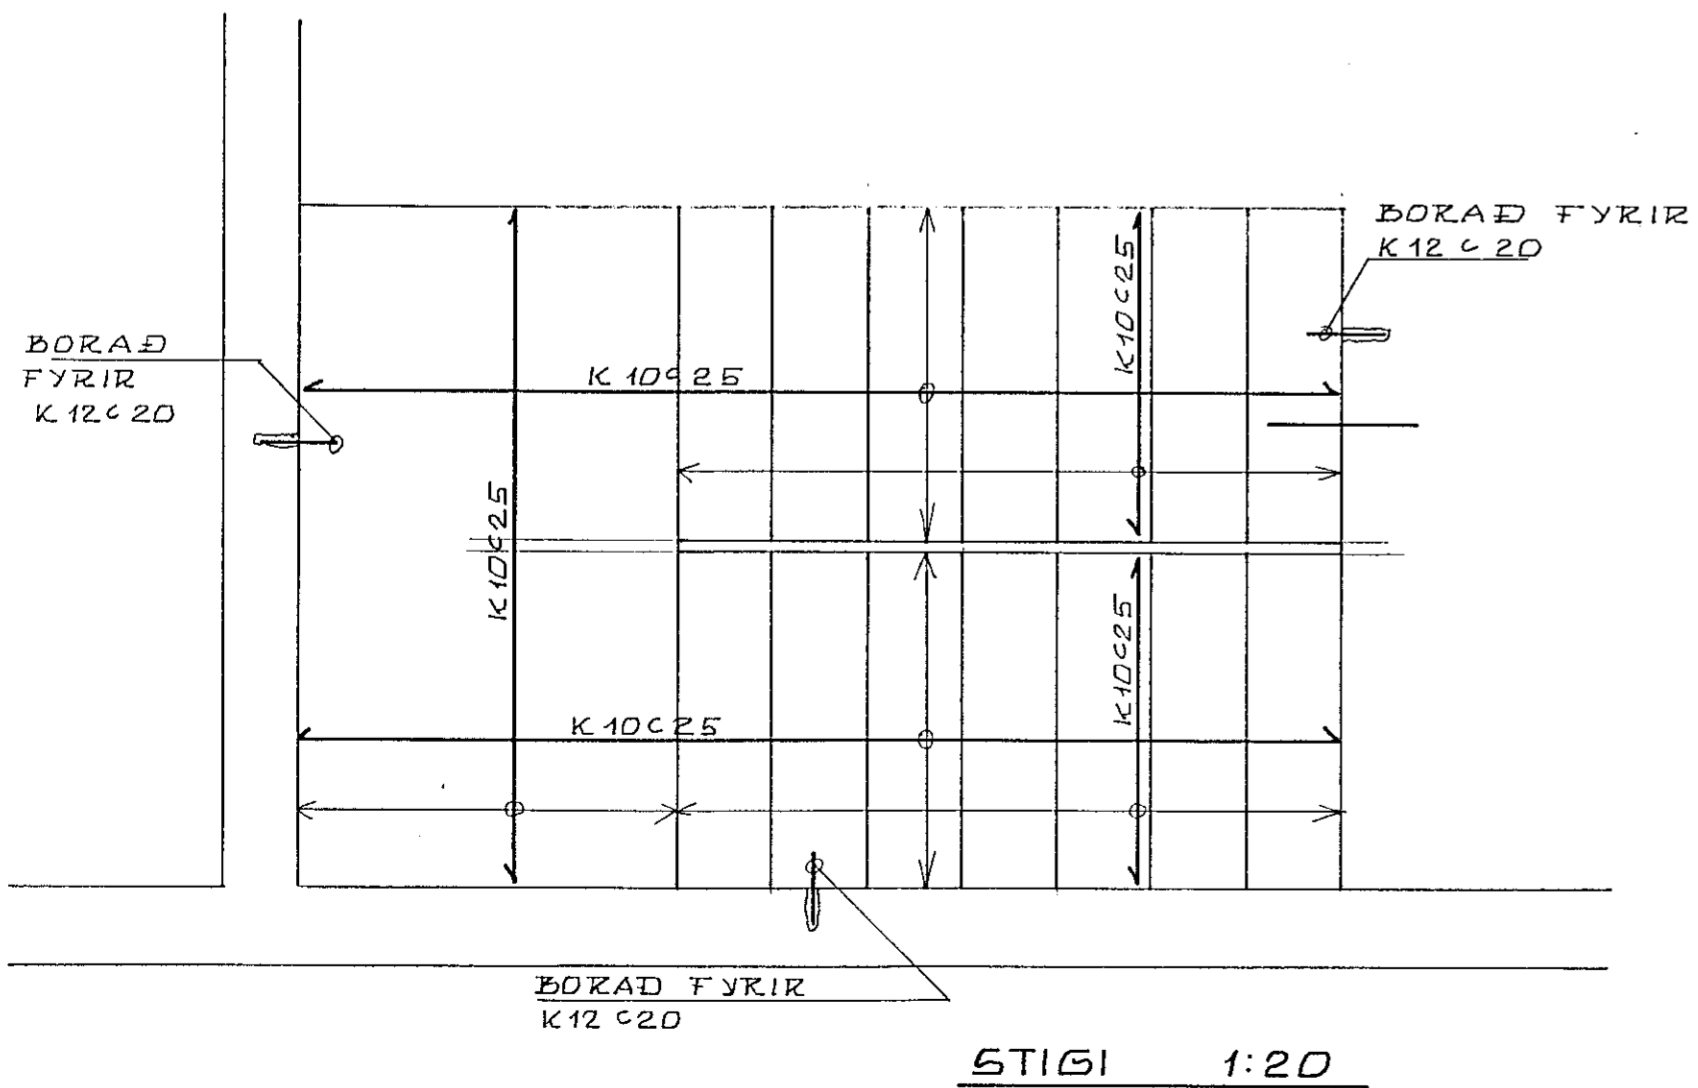

① BREYTING: STIGI KJALLARA, PLATA GEYMSLU

KRISTJÁN KNÚTSSON TÆKNIFR. FTFÍ
 LYGBERGI 27, HAFNARFIRÐI. S. 051647

BIRKIBERG 4 HAFNARFIRÐI	DAGS DKT. 88 MKV 1:50 1:20
UNDIRSTÖÐUK: GRUNNMÝND STIGI KJALLARA	BL. 1 AF VERK. 883-01 H.K.K. T. SEK