


MÁL ERU Í mm - HÆDARTÖLUR ERU m

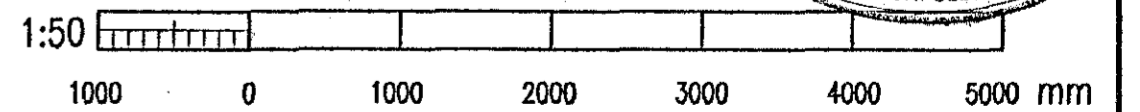

				VST VERKFRÆÐISTOFA SIGURDAR THORODDSEN hf. VERKFRÆÐIRÁÐGJAFAR FRV				BYGGDAVERK HF						
				Árrmála 4 108 Reykjavík Talsími: (91) 69 50 00 Brefsími: (91) 69 50 10 Glerárgötu 30 600 Akureyri (96) 2 25 43 (96) 1 11 90 Bjarnarbraut 8 310 Borgarnes (93) 7 13 17 (93) 7 13 11 Hafnarstræti 1 400 Ísafjörður (94) 37 08 (94) 39 65				SÓLVANGSVEGUR 1 - 3 FYRRI HLUTI LOFTRÆSING - TENGIÁLMA LOFTSTOKKAR Í KJALLARA - LOFTRÆSIKLEFI						
2.301.1	SNID A - A Í LOFTRÆSIKLEFA	SEPT. 92	LOFTRÆSIKLEFA OG LÖGNUM FRÁ HONUM BETT Á TEIKNINGUNA.	HP										
Teikn. nr.	Tilvisun á teikningu	Br.	Dags.	Eðli breytingar	Br.	Yf.	Sp.	Höfundur	Teiknað	Yfirfarið	Samþykkt	Dagsetning	Verk nr.	Teikn. nr.
					HP	HP		GN	GN	Guttormsdóttir		JANÚAR 1992	91.150	2.301

