


RÚMMYND 1:50

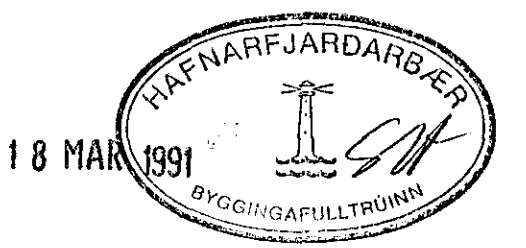

BR.NR.	DAGS	EDLI BREVTINGAR	SIGN.
	26.07.91	LEGU LAGNA DREYTT	g. 21.
STAPAHRUN 5 HAFNARFIREÐI			DAGS OKT. '89
RÚMMYND HITALAGNA			HANNAÐ g. 21.
MELIKV. 1:50			TEIKNAD.
SIGURÐUR ÞORLEIFSSON TEKNIFRÆÐINGUR F.T.F.I.			VERK NR. 8924
STRANDGÖTU 11 HAFNARFIREÐI SÍMI 54751			BLAD NR. 2-05