



SNID B-1 MKV. 1:10

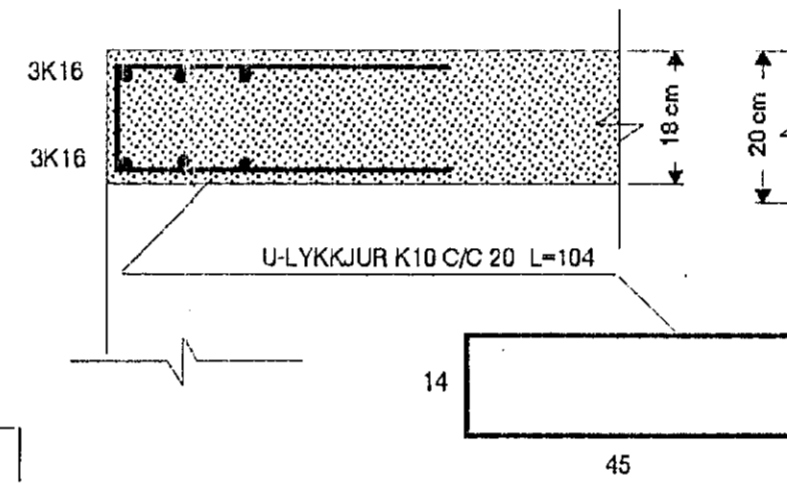

SNID B-2 MKV. 1:10

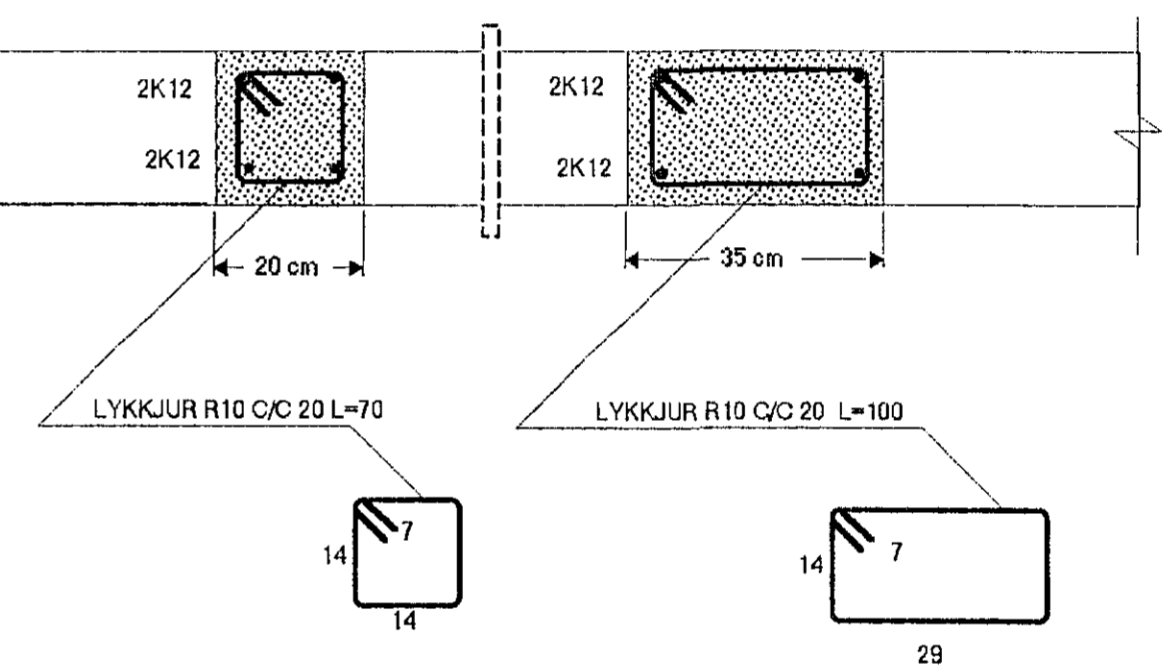


SNID A-A, C-C OG F-F SJÁ TEIKNINGU NR. 1.04

SNID D-D OG E-E SJÁ TEIKNINGU NR. 1.02

SNID G-G OG H-H SJÁ TEIKNINGU NR. 1.05

- (A) BREYTT 10.11.1991
- (B) BREYTT 04.02.1992

10 FEB 1992

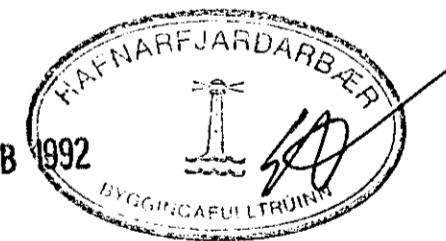

KVARDI : 1:50 1:10	TV TÆKNIVANGUR S/F GRENSASVEGUR 16 108 REYKJAVÍK. S 67 88 45	VERKNR. TEIKN. NR. 1.03
DAGS. :OKT1991	VERKEFNI : VESTURHOLT 16 HAFNARFIRDI	BREYTT DAGS.
HANNAÐ : M.G	HEITI : BURÐARVIRKI : GRUNNMYND AF PLÖTU YFIR KJALLARA , SNIÉ	
TEIKNAD : M.G	YFIRFARID : <i>Magnús Gylfason</i>	MAGNÚS GYLFASON F.T.F.I