



Bilskúr
M:100

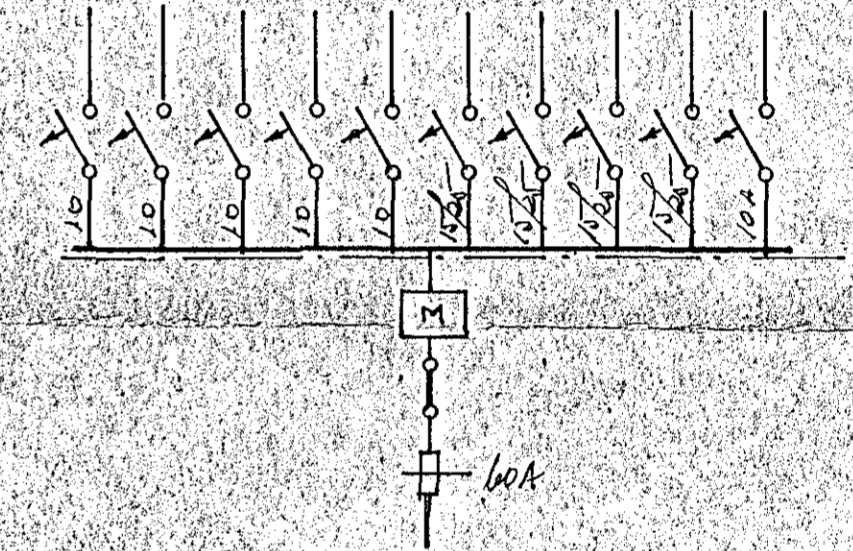

- SKYRINGAR**
1. ROPAR: 110cm FRA GOLF
 2. TENGLAR: 20cm -||- NEMA
 3. -||- ELDHÚTOTTUR: 110cm -||-
 4. -||- J. OFN - HELLUR: 2x 65cm -||-
UNDIR TAKJUM SJA INNR. TEIKN.
 5. VEGGLJÓD: 165cm -||-
 6. SIMI: R. 20cm -||- TENGLAÐÓD
MEY SKRÖFUFESTINGU
 7. HOFTNET: N. 20cm -||-
 8. HITALÍÐLIT: 145cm -||-

STEINGUR AD BILSKUR
PLASTOR 65cm

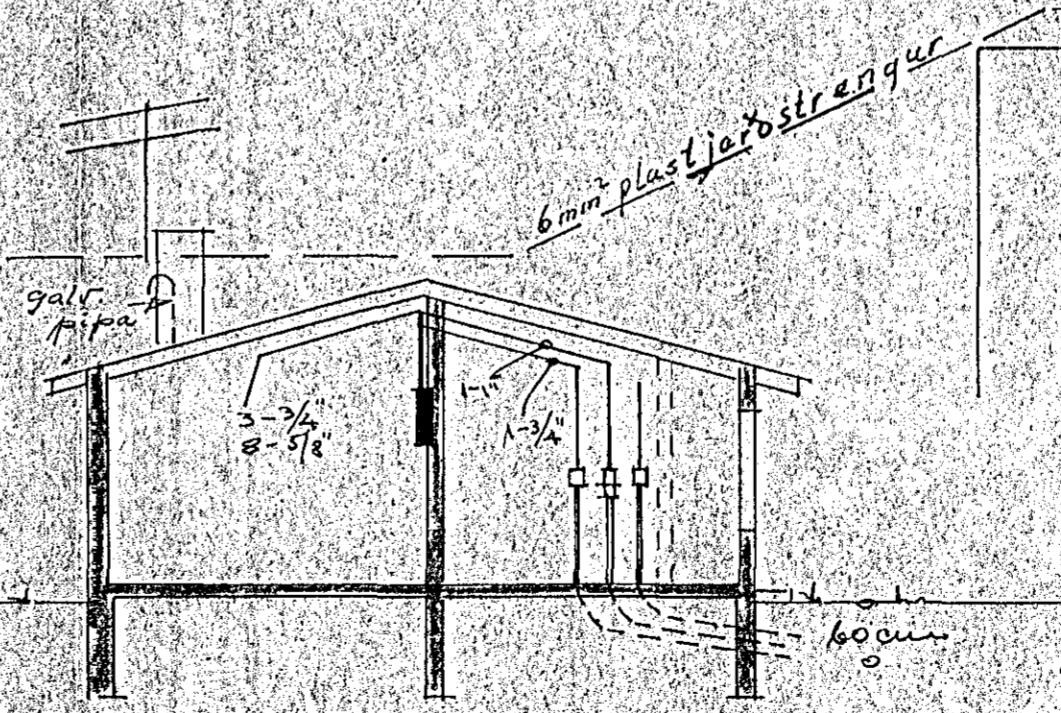

Bilskúr

HÚSNÆÐISMÁLASTOFNUN RÍKISINS		
RAFLÖGN	EINBYLISHÓD	VERK
GRUNNING-SNEDING	1132	
	Blaslaofl	
	M:1.50 - 1:100	
NGGOST	TBO	
1969	UT	473-1

Þreyting í maí 1971 · Bilgeymsla 221