


Inntök samþykkt 13. 11. 1971
f. h. RAFVEITU HAFNARFJÄRDAR

Magnus Jérkstjóri



Bilskur.
M 1:100.

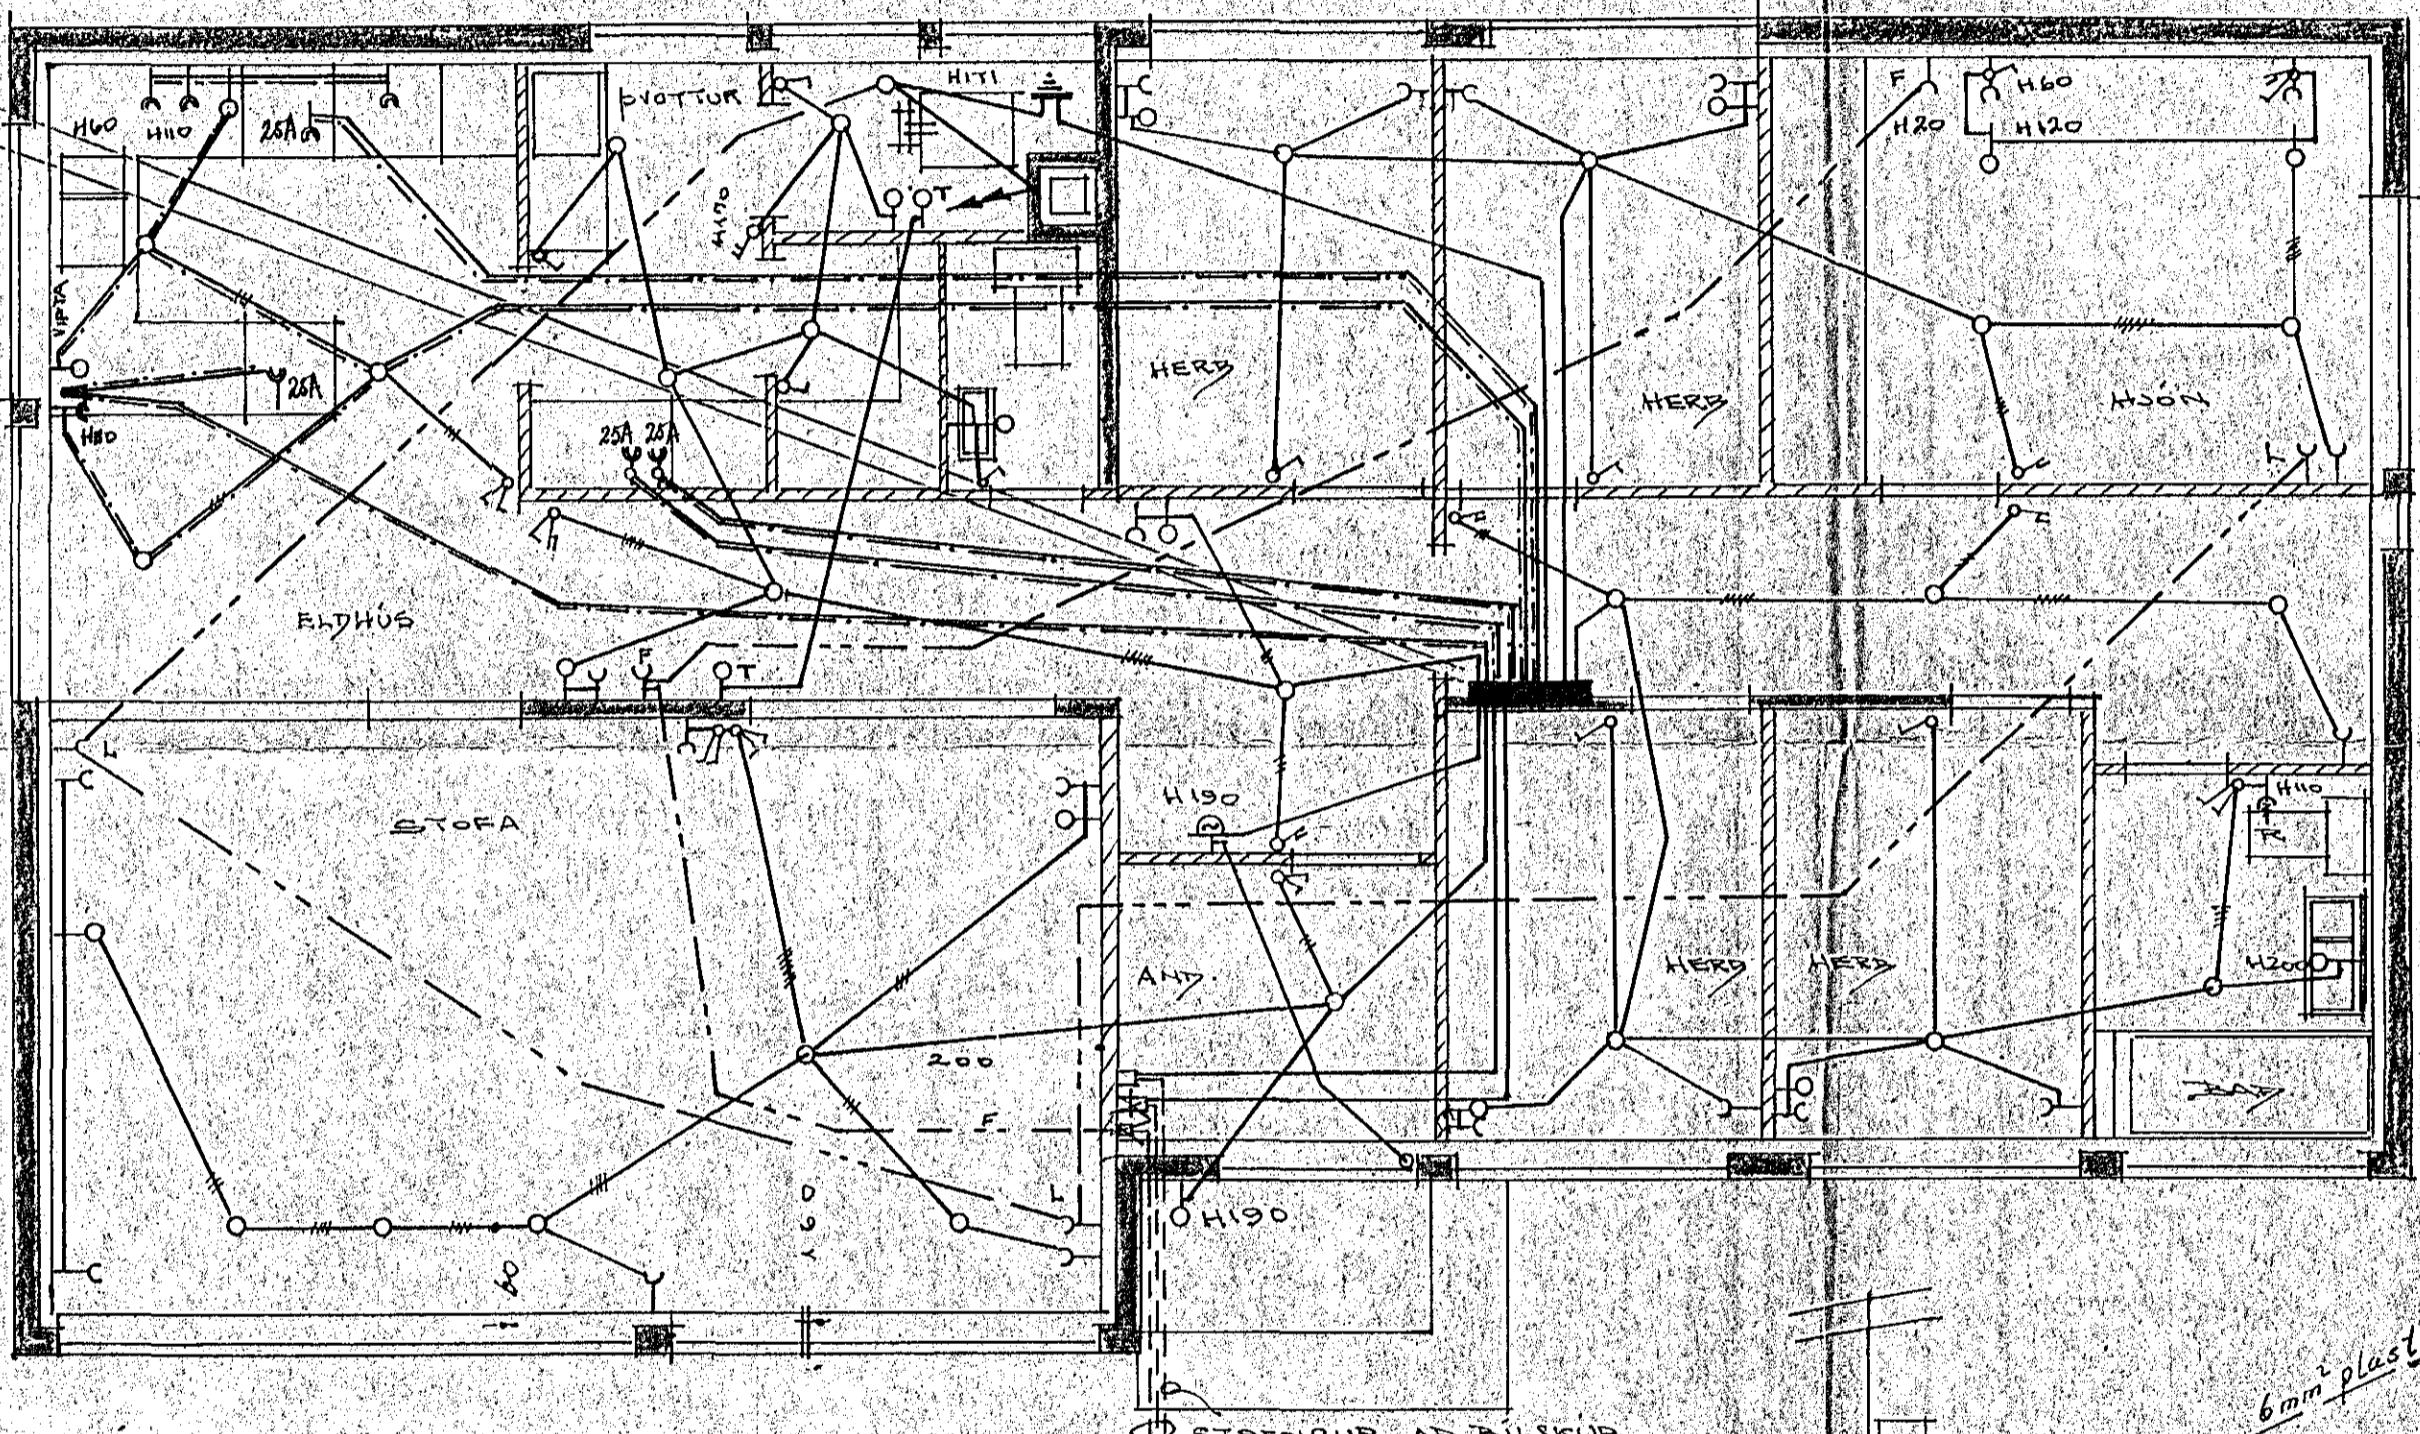

SKYRINGSATE

1. ROFAIR: 110 cm FRA GOLF
 2. TENGELAR: 20 cm -" NEMA:
 3. -" ELDH FVOTUR: 110 cm -" -
 4. -" f. OFN - HELLOR: ca. 65 cm -" -
UNDIR TÆKJUM: SJA INNTR. TEIKN.
 5. VEGGLÓS: 165 cm -" -
 6. SÍMS: F: 20 cm -" - TENGELADÓS
MEY SKRÚFUFESTINGU
 7. HOFTNET: L: 20cm -" -
 8. HITALIDL: T: 145 cm -" -

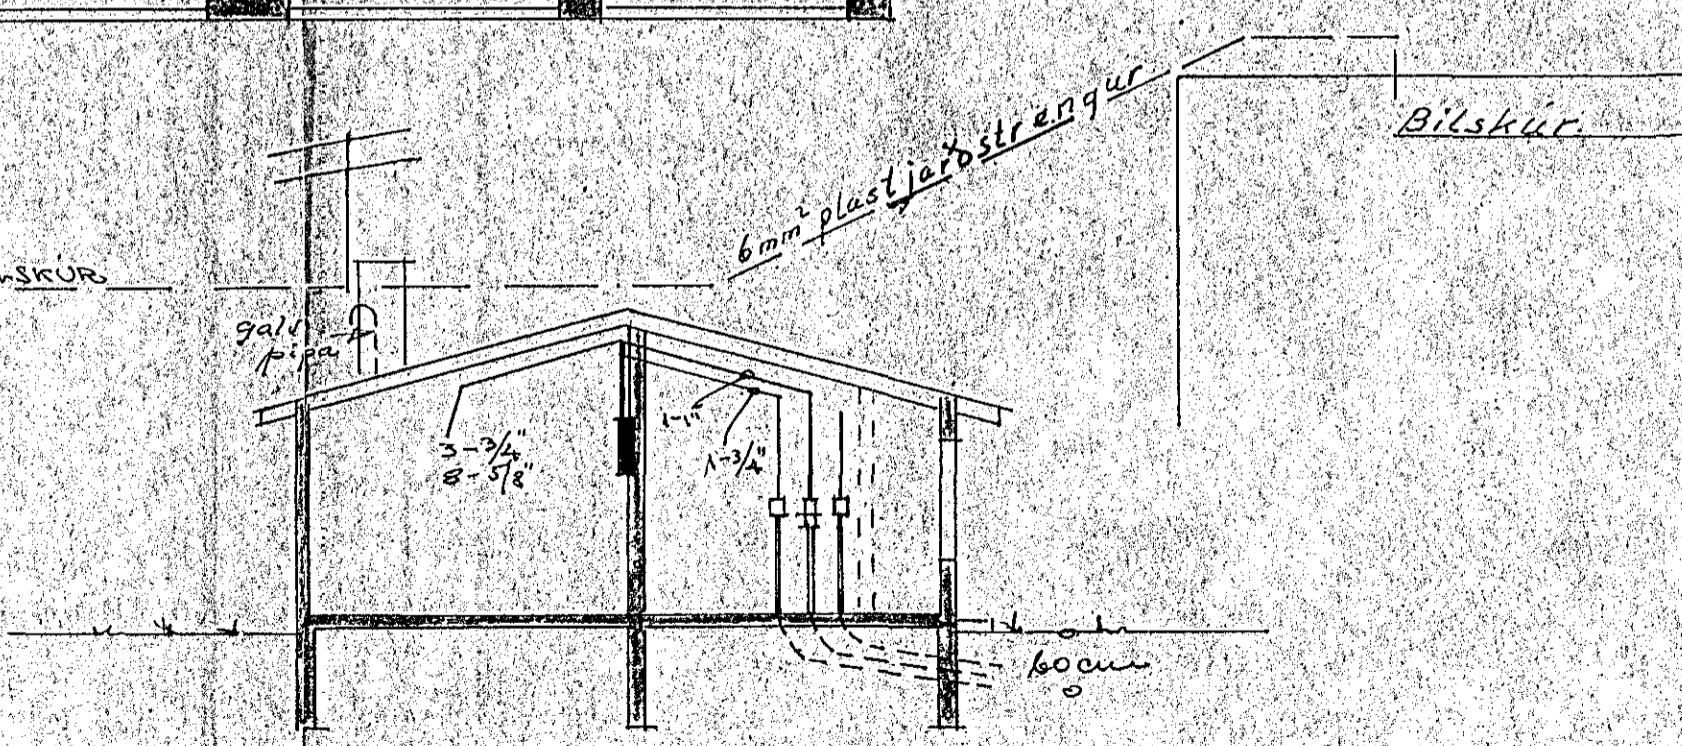

Breyting i mai 1971. Bilgeymsla. 89.

HÚSNÆÐISMÁLASTOFNUN RÍKISINS	
RAFLÖGN	EINBYLISHÚS
GRUNNMYNT-SNEIDING	VERK
	1132
	BLAÐI af 1
	M:L:50 - L:100
Agóst	1960
1969	- OCT -
	473-1