
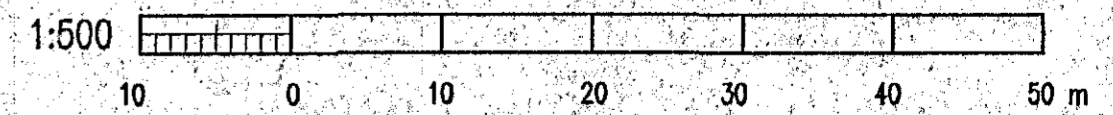
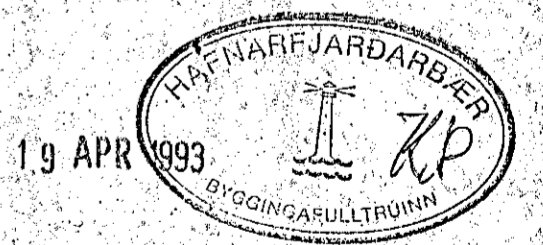


REYKJANESBRAUT

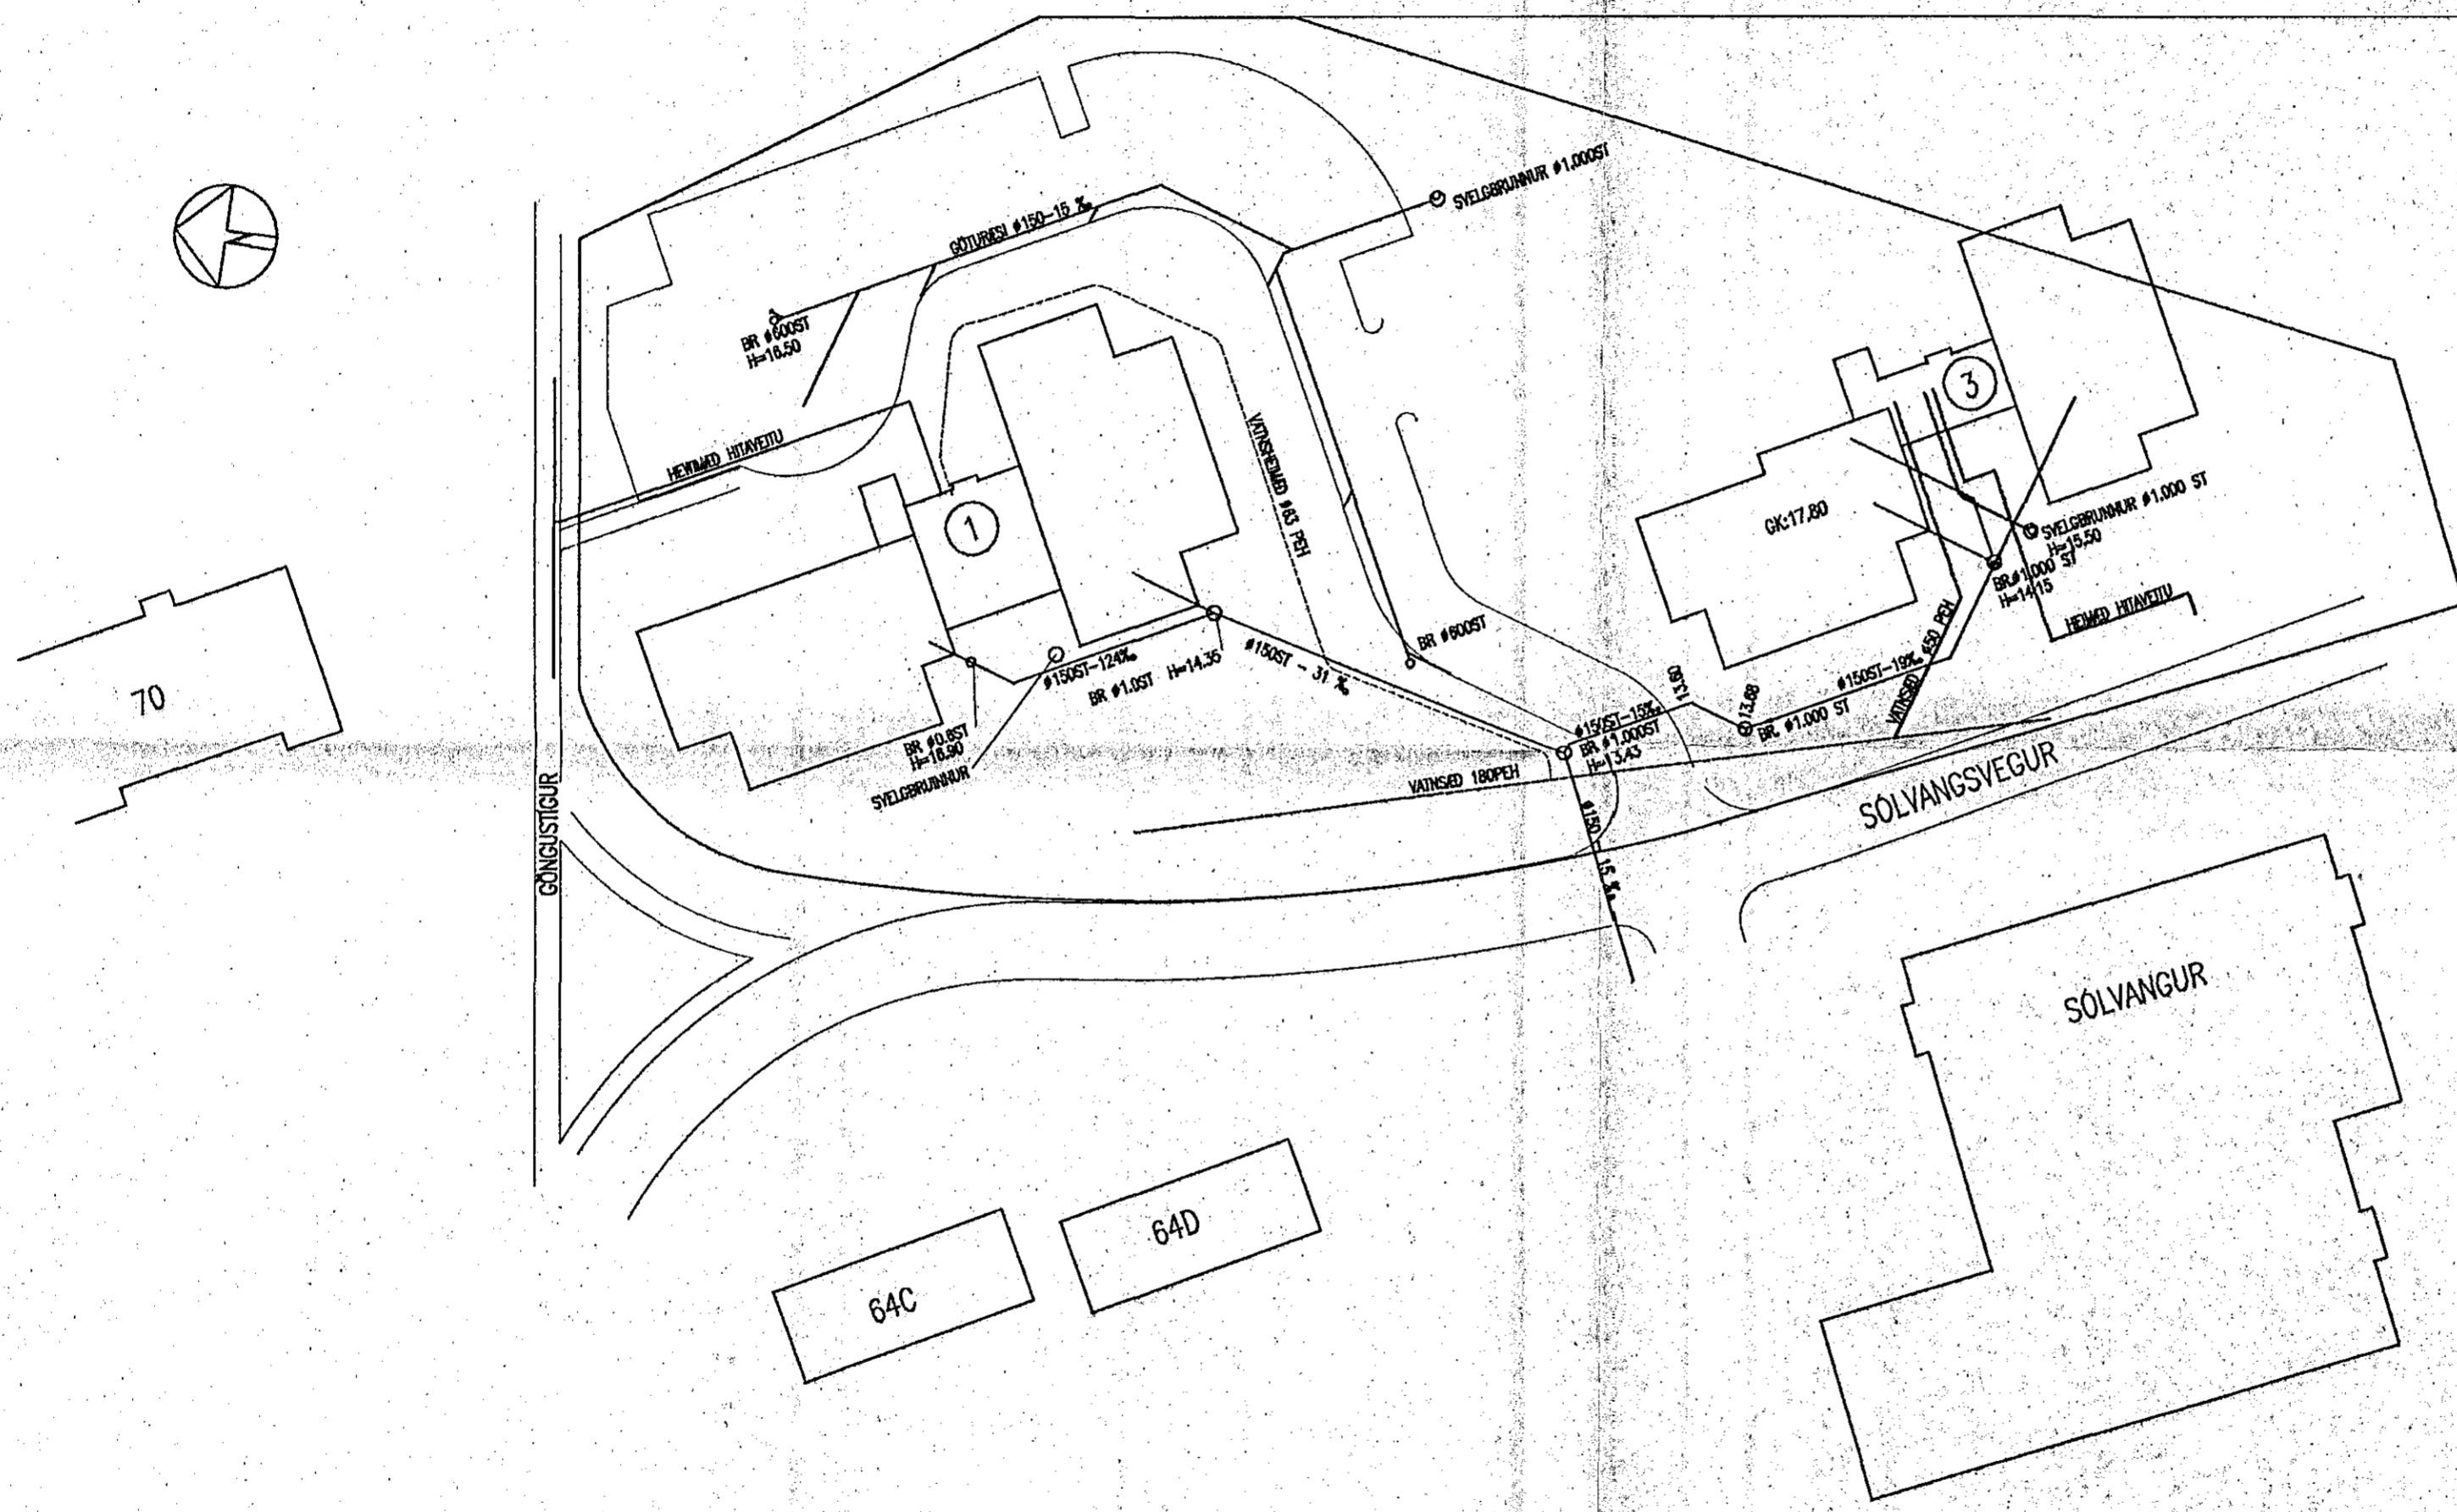

HÆDARTÖLUR ERU | m

				VERKFRÆDISTOFA SIGURDAR THORODDSEN hf. VERKFRÆDIRÁÐGJAFAR FRV Ármála 4 108 Reykjavík Tölsími: (91) 69 50 00 Bréfasími: (91) 69 50 10 Glergötu 30 600 Akureyri (96) 2 25 43 (96) 1 11 90 Bjarnarbraut 8 310 Borgarnes (93) 7 13 17 (93) 7 13 11 Hafnarstræti 1 400 Ísafjörður (94) 37 08 (94) 39 65				BYGGDAVERK HF SOLVANGSVEGUR 3, HAFNARFIRÐI HREINLÆTIS- OG HITALAGNIR - HEILD AFSÖDUMYND, STOFNLAGNIR						
Telkn. nr.	Tilvisun ó teikningu	Br.	Dags.					Eðli breytingar	Br.	Yf.	Sp.	Hannað	Teiknað	Yfirforð
			NOV 92	LEGA STOFNLAGNA FÆRD INN	HP			HP	HP	GH	Guðrún Halldóttir	APRIL 1993	93.112	0.001