


GRUNNMYND, 1:50

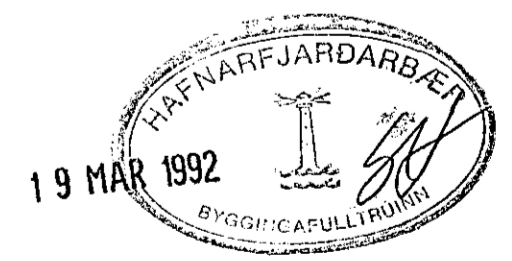

Rekling: Eldri teikning ógild.

| | | | |
|--|----------|-----------------|---------------|
| DI | 17.03.92 | SPERRUM BREGTT | 97 |
| BR.NR. | DAGS | EÐLI BREVTINGAR | SIGN. |
| GOLFSKALI KEILIS HVALEGRARVELLI | | | DAGS AGÚST 91 |
| ÞAKVIRKI, GRUNNMYND | | | HANNAÐ 97 |
| | | | TEIKNAD 97 |
| | | | VERK NR. 9114 |
| MÆLIKV. 1:50 | | | BLAD NR. 1-05 |
| SIGURÐUR ÞORLEIFSSON TEKNIFRÉBINGUR F.T.F.I. | | | |
| STRANDGÖTU 11 HAFNARFIRÐI SÍMI 54751/54255 | | | |