


04 NOV 1991

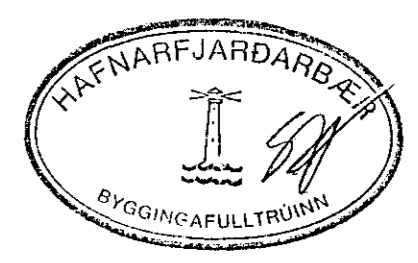

DI	30.10.91	KOTUM BÍEYTT	LEGU LAGNA BÍEYTT	27
BR.NR.	DAGS	EDLI	BREYTINGAR	SIGN.
				DAGS AGUST. 91
				HANNAÐ 4. 91
				TEIKNAD 4. 91
				VERK NR. 9114
				BLAD NR.
				2-02

MELKV. 1:50. 1:20
SIGURÐUR ÞORLEIFSSON TEKNIFRÆÐINGUR F.T.F.I.
 STRANDGÖTU 11 HAFNARFIRÐI SÍMI 54751/54255