


GRUNNMÝND 2 HÆÐAR 1:50

ÁSKILIÐ, ELDRÍ  
TEIKNING ÓGILD

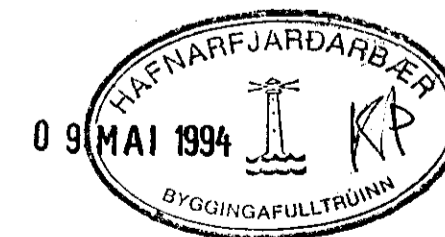

01	MARS '94	HL. A BADI FÆRD. FP EJÓLGARÐ CH	
BR.	DAGS.	EDLI BR.	SIGN.

STECKJARBERG 4  
HAFNARFIRÐI

HITA - VATNS - FRÁREINSLIS OG  
LOFTÆSTILAGNIR 2 HÆÐAR

MKV. 1:50

DAGS. DES '93

VERK NR. 9336

TEIKN NR. 2-04

HANNAÐ

TEIKNAD GH

YFIRFARIÐ

**GF** TÆKNIPJÓNUSTA  
SIGURDAR ÞORLEIFSSONAR HF

STRANDGÖTU 11 - 220 HAFNARFJÖRÐUR - SÍMI 54255 - FAX 652875