


RÚMMYND-HITALAGNA 1:50

Plú. nr.	Staðsetn.	Plú. port kca./h	Lengd MM	m hæð tenging. MM	
101	STICAHUS	600	2.200	600	AD
102	HJÓL VAGNAR	1.130	1.400	600	CD
103	HJÓN	1.220	1.600	600	AB
104	BAD	600	900	600	CD
105	STOFA	3.150	3.400	600	BC
106	PVOTTUR G	500	1.000	600	AB
107	BAKANDD	500	1.000	600	AB
108	PVOTTUR G	500	1.000	600	AB
109	STOFA	3.800	3.400	400	BC
110	BAD	600	900	600	CD
111	HOL	600	700	600	AB
112	HJÓN	1.310	1.600	600	CD
113	HERB	900	1.400	600	AB
114	ANDD	600	1.200	600	CD
201	STIGAH	1.600	2.200	600	AD
202	HERB	810	1.400	600	CD
203	HERB	810	1.400	600	CD
204	HJÓN	1.220	1.600	600	AB
205	BAD	600	1.000	600	CD
206	PVOTTUR G	400	1.000	600	AB
207	STOFA	2.100	3.400	400	BC
208	ELDH	1.300	1.600	400	AB
209	ELDH	1.300	1.600	400	CD
210	STOFA	2.400	3.400	400	BC
211	PVOTTUR	500	1.000	600	CD
212	HOL	600	700	600	AB
213	BAD	600	800	600	AB
214	HJÓN	1.300	1.600	600	CD
215	HERB	810	1.400	600	AB
216	HERB	810	1.400	600	AB
301	HERB	810	1.400	600	CD
302	HERB	810	1.400	600	CD
303	HJÓN	1.220	1.600	600	AB
304	BAD	600	1.000	600	CD
305	PVOTTUR G	400	1.000	600	AB
306	STOFA	2.100	3.400	400	BC
307	ELDH	1.300	1.600	400	AB
308	ELDH	1.300	1.600	400	CD
309	STOFA	2.400	3.400	400	BC
310	PVOTTUR G	500	1.000	600	BC
311	HOL	600	800	600	AB
312	BAD	600	800	600	AB
313	HJÓN	1.300	1.600	600	CD
314	HERB	810	1.400	600	AB
315	HERB	810	1.400	600	AB
SAMTALS		49.500			

ÁSKILIÐ, ELDRÍ  
TEIKNING ÓGILD

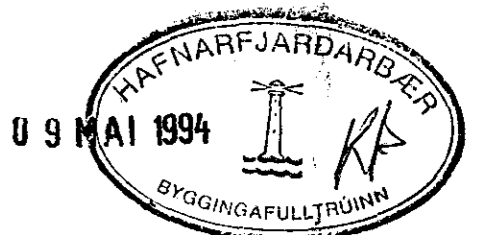

01	MARS '94	ÓFILLAR	213 OG 312	HINNAR	GH
BR.	DAGS.	EDLI BR.	SIGN.		
STEKKJARBERG 4 HAFNARFJÖRÐI					
RÚMMYND - HITALAGNA					
MÓD 1:50					
DAGS. SEPT '93					
VERK NR. 9336					
TEIKN NR. 2-06					
HANNAD					
TEIKNAD GH					
YFIRFARIÐ					
STRANDGÖTU 11 · 220 HAFNARFJÖRÐUR · Sími 54255 · FAX 652875					