


RÚMMYND - FRÆMMSIS OG LOFTRESTITLAGNA

ÁSKILIÐ, ELÐRI
TEIKNING ÓGILD

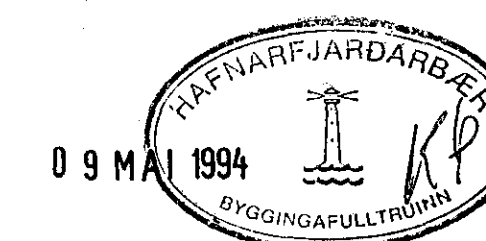

02	APRIL '94	STIÐ LOFTRORA DR.	GH
01	MARS '94	FALLP. FJÓLGAD	GH
BR	DAGS	EDLI BR	SIGN.

STEKKJARBERG 4
HAFNARFJÖRÐUR

RÚMMYND - FRÆMMSIS OG
LOFTRESTITLAGNA

MKV 1:50
DAGS DES '93
VERK NR 933L
TEIKN NR 2-08
HANNAD
TEIKNAD GH
YFIRFARIÐ

TÆKNIPJÓNUSTA
SIGURDAR ÞORLEIFSSONAR HF

STRANDGÖTU 11 - 220 HAFNARFJÖRÐUR - Sími 54255 - FAX 652875